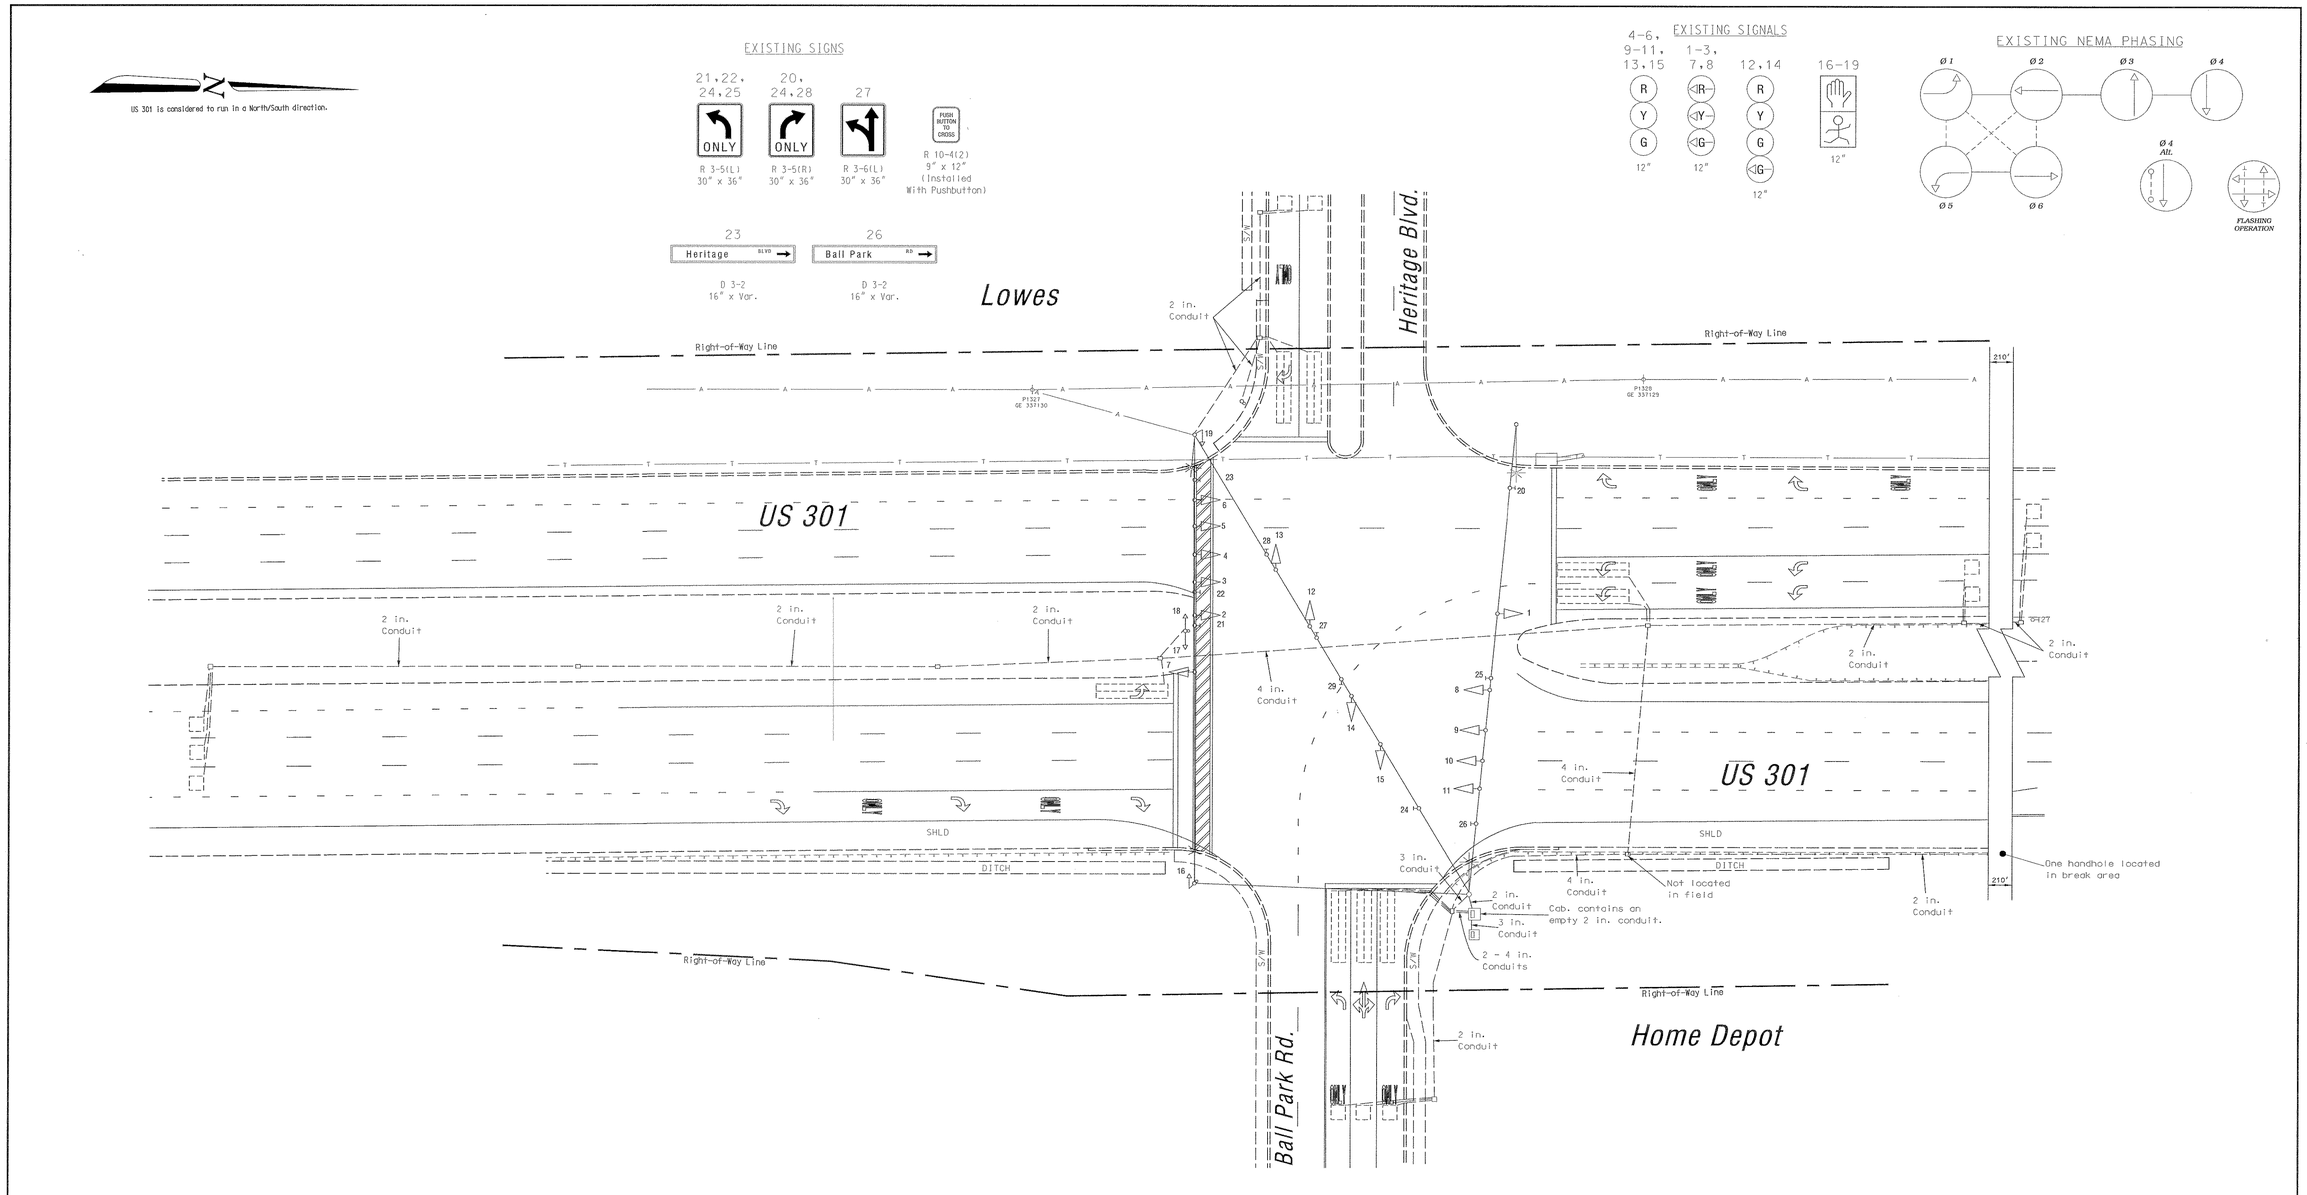

GEOMETRIC LEGEND

EXISTING GEOMETRICS

PROPOSED GEOMETRICS

UTILITY LEGEND

G	GAS MAIN
W	WATER MAIN
S	SEWER MAIN
E	ELECTRIC CABLES
D	STORM DRAIN
A	AERIAL CABLES
T	TELEPHONE CABLES

As-Built

The Traffic Group

The Traffic Group, Inc.
410-583-8405
Fax 410-321-8458

REVISIONS

September 7, 1999
As-Built
S.H.A. No.:BW996M82
JES

APPROVALS

TEAM LEADER, TRAFFIC ENGINEERING DESIGN DIVISION

ASST. CHIEF TRAFFIC ENGINEERING DESIGN DIVISION

CHIEF, TRAFFIC ENGINEERING DESIGN DIVISION

DIRECTOR, TRAFFIC & SAFETY

ORIGINAL ON FILE

MARYLAND DOT - STATE HIGHWAY ADMINISTRATION
Office of Traffic & Safety
TRAFFIC ENGINEERING DESIGN DIVISION
(Traffic Signal Plan)

US 301 @ Ball Park Rd./Heritage Blvd.

DRAWN BY:	Bruce Thompson	F.A.P. NO.	N/A	TS NO. 3370D	SHEET NO.
CHECKED BY:	XXX	S.H.A. NO.	AW277A5K1B5K		
SCALE:	1" = 30"	COUNTY:	Prince George's	T.I.M.S. NO. C-778	1 OF 1
DATE:	September 14, 1993	LOG MILE:	1603023.55		

f:\970417\des\asbuilt.dgn 09 SEP 1999