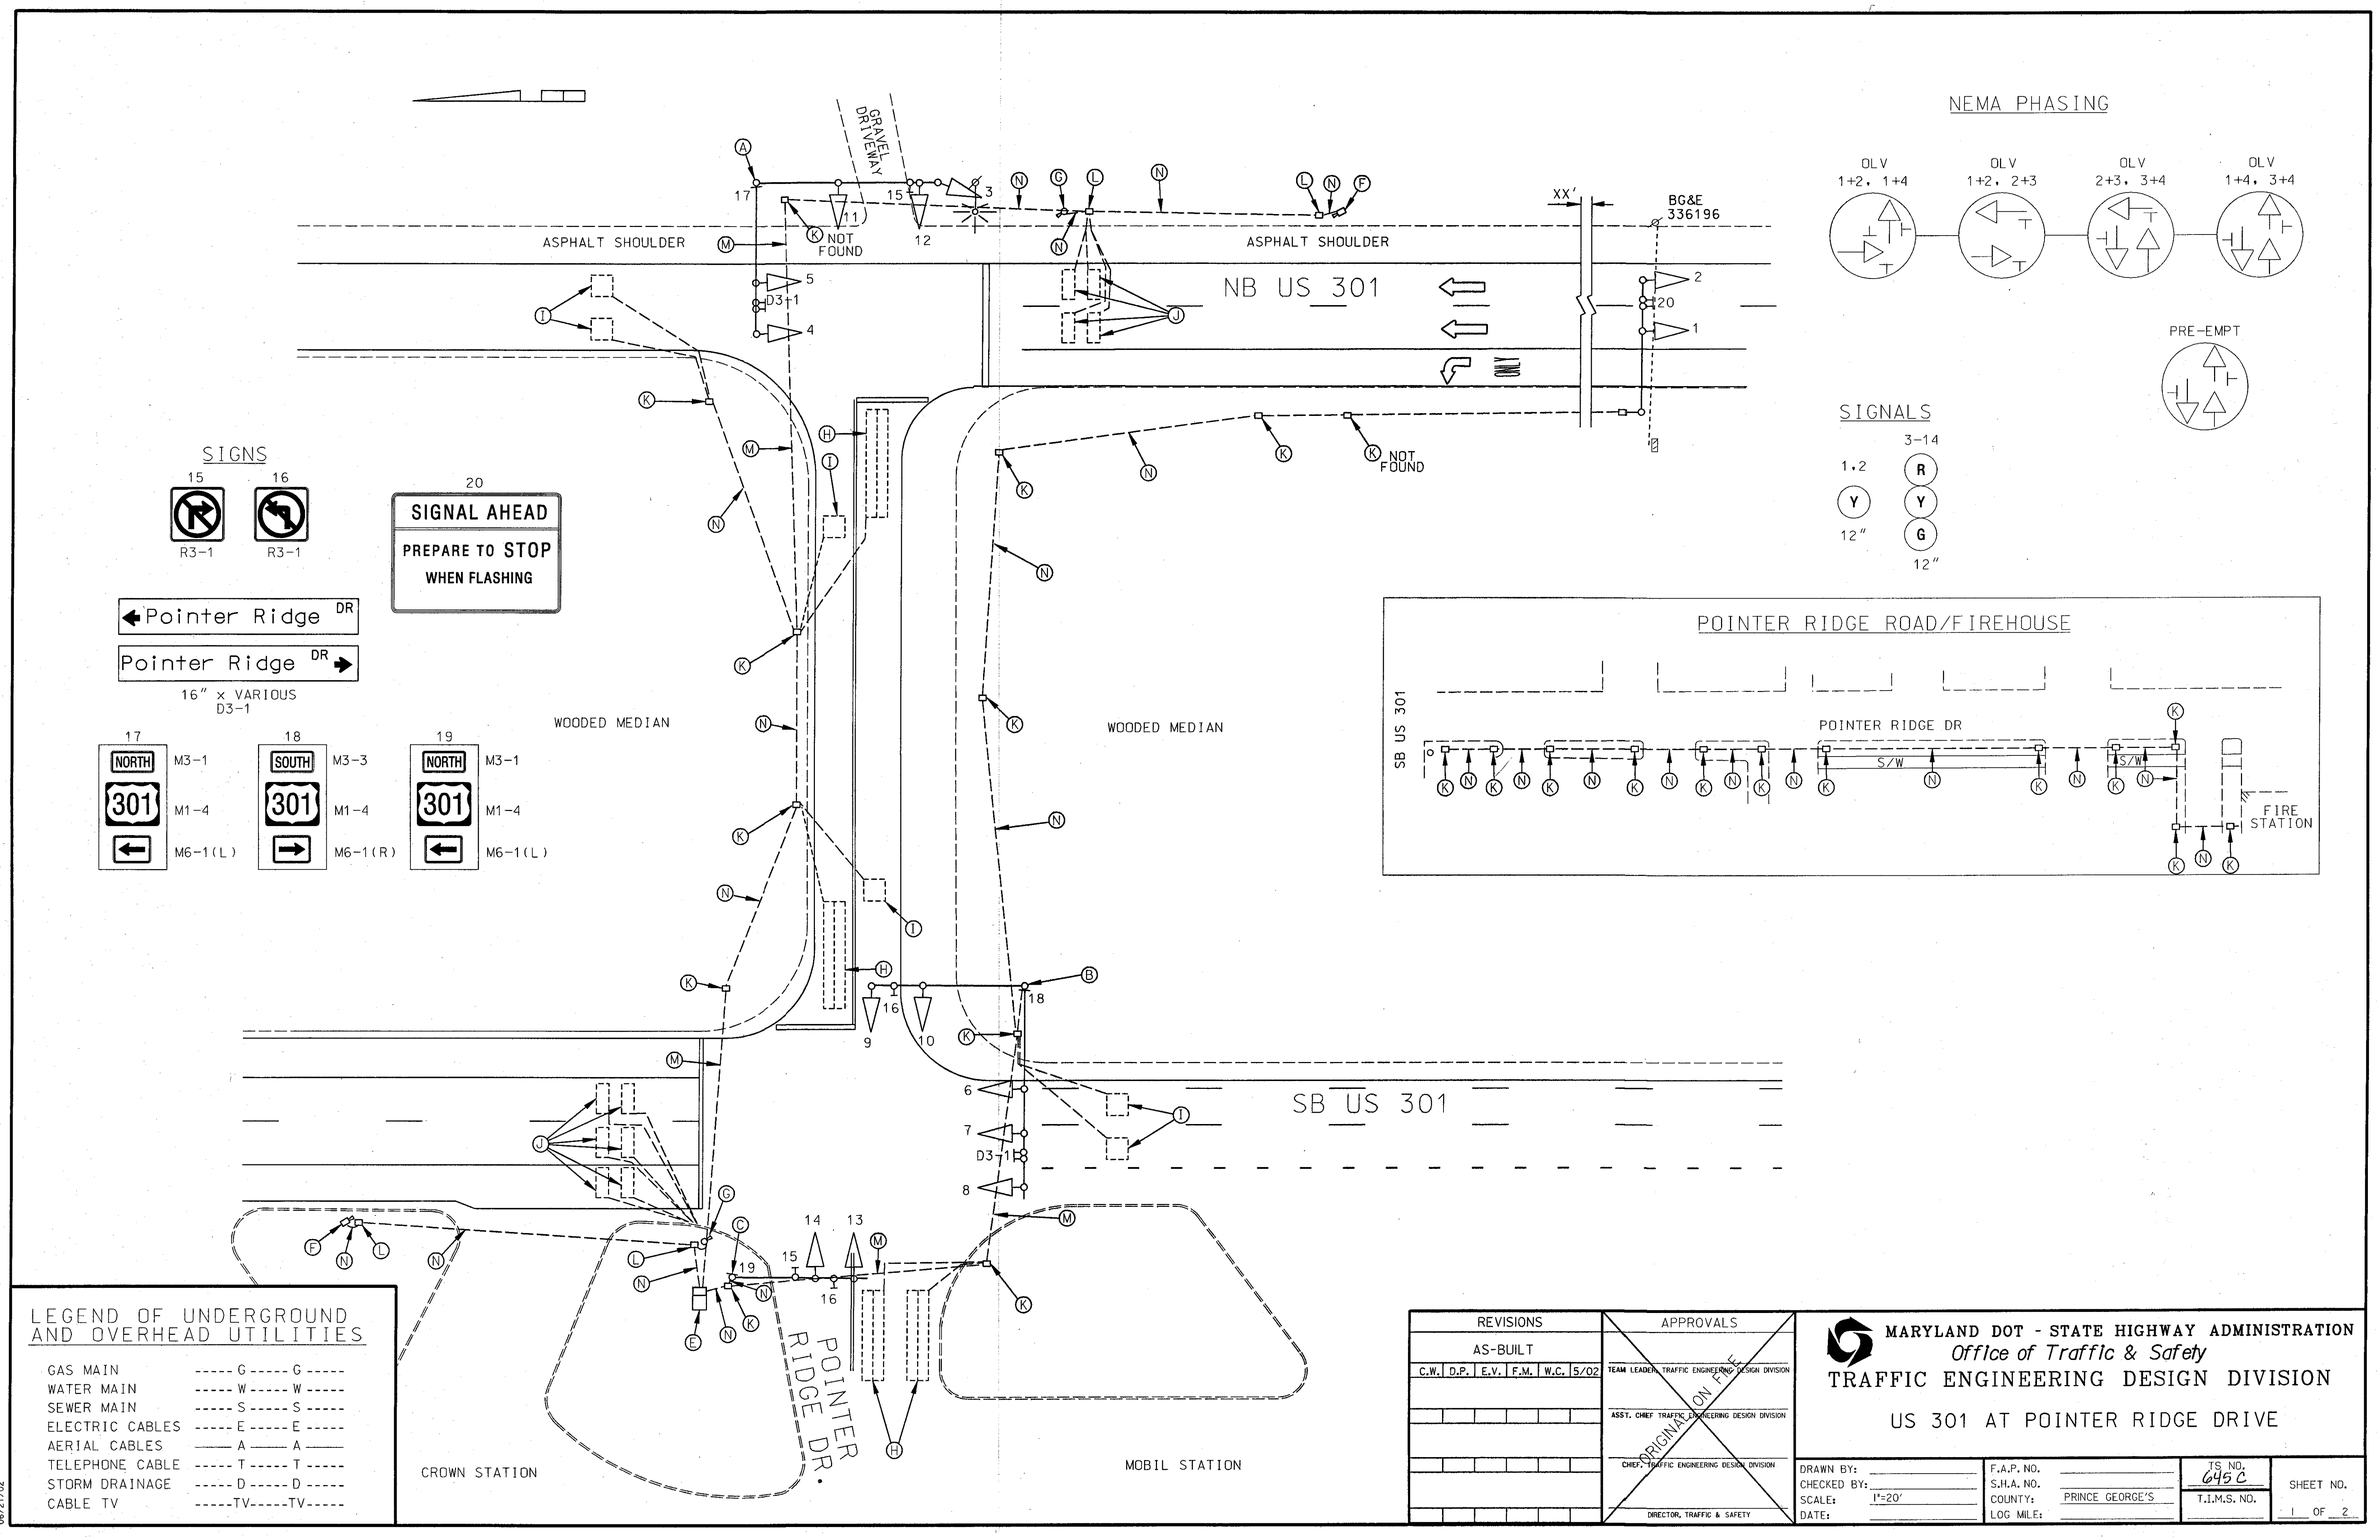

LEGEND OF UNDERGROUND AND OVERHEAD UTILITIES

GAS MAIN	-----G-----G-----
WATER MAIN	-----W-----W-----
SEWER MAIN	-----S-----S-----
ELECTRIC CABLES	-----E-----E-----
AERIAL CABLES	——— A ——— A ———
TELEPHONE CABLE	-----T-----T-----
STORM DRAINAGE	-----D-----D-----
CABLE TV	-----TV-----TV-----

REVISIONS					
AS-BUILT					
C.W.	D.P.	E.V.	F.M.	W.C.	5/02

APPROVALS

TEAM LEADER, TRAFFIC ENGINEERING DESIGN DIVISION

ASST. CHIEF TRAFFIC ENGINEERING DESIGN DIVISION

CHIEF, TRAFFIC ENGINEERING DESIGN DIVISION

DIRECTOR, TRAFFIC & SAFETY

ORIGINAL ON FILE

MARYLAND DOT - STATE HIGHWAY ADMINISTRATION

Office of Traffic & Safety

TRAFFIC ENGINEERING DESIGN DIVISION

US 301 AT POINTER RIDGE DRIVE

DRAWN BY:	F.A.P. NO.	TS NO. 645 C	SHEET NO.
CHECKED BY:	S.H.A. NO.	T.I.M.S. NO.	1 OF 2
SCALE: 1"=20'	COUNTY: PRINCE GEORGE'S		
DATE:	LOG MILE:		

E:\MD301\POINTERRIDEDR-1.dgn
06/21/02