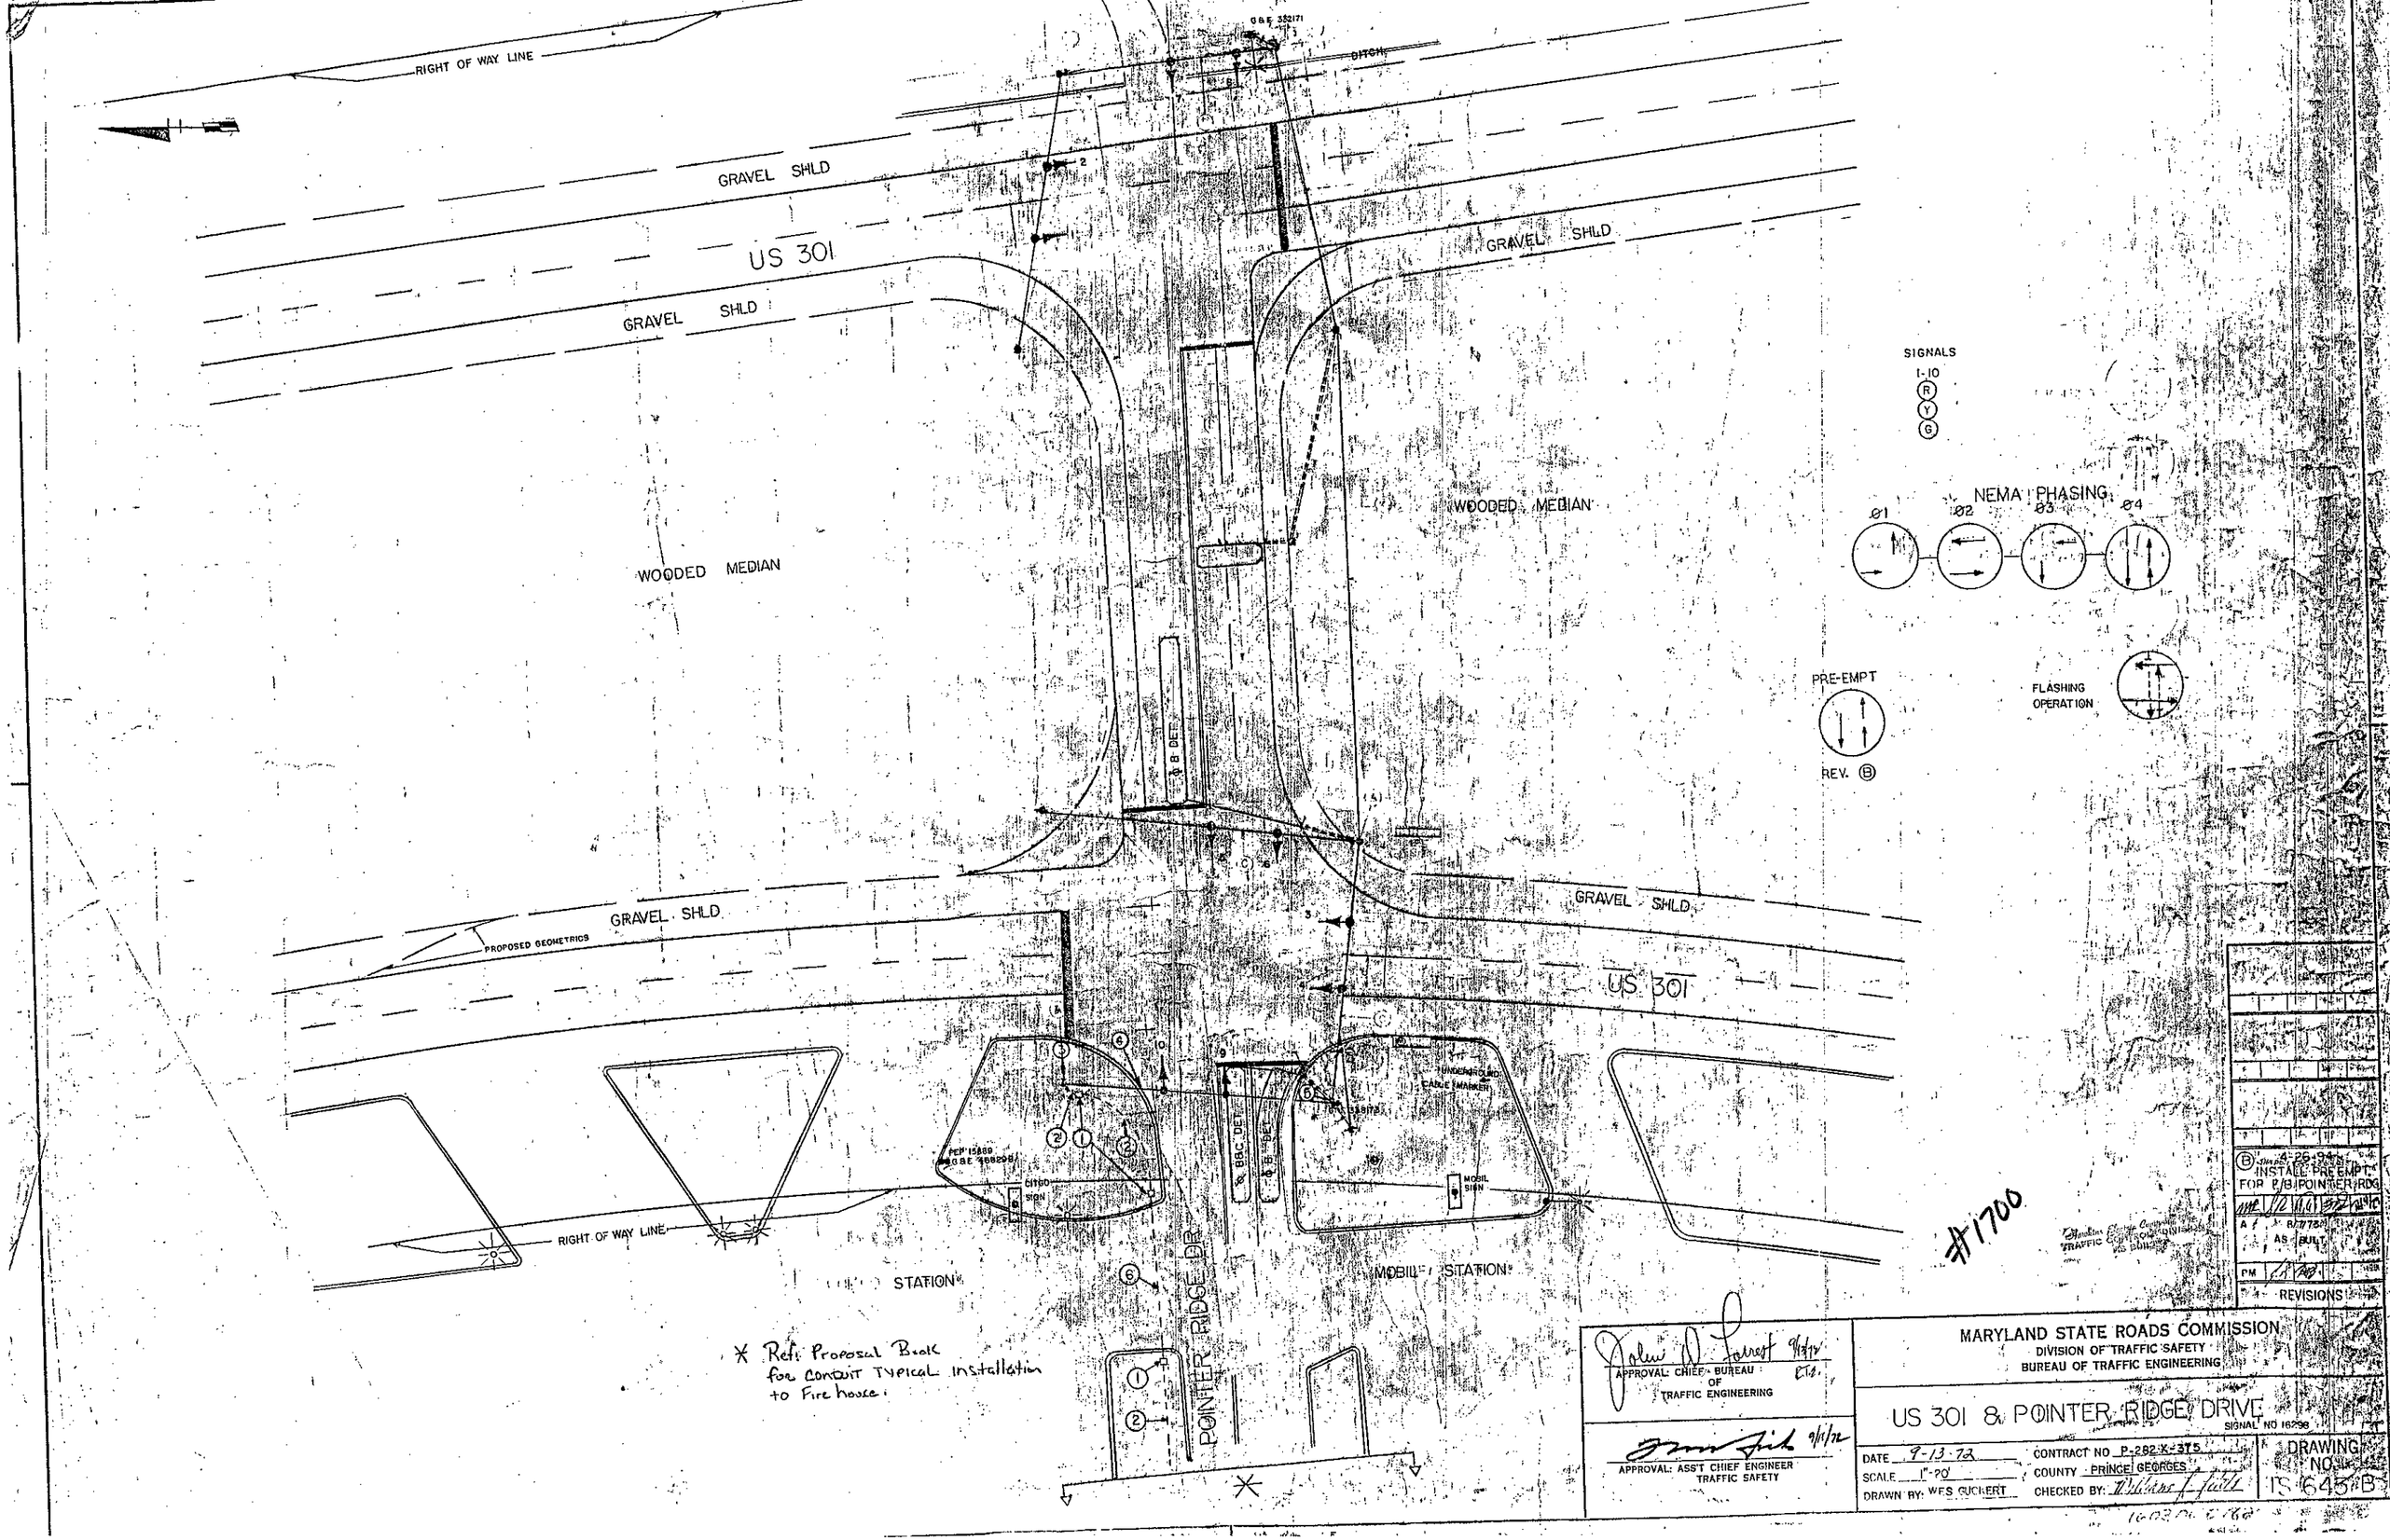
RIGHT OF WAY LINE
DITCH
GRAVEL SHLD
US 301
GRAVEL SHLD
GRAVEL SHLD
WOODED MEDIAN
WOODED MEDIAN
SIGNALS
I-10
R
Y
G
NEMA PHASING
Ø1
Ø2
Ø3
Ø4
PRE-EMPT
REV. B
FLASHING OPERATION
GRAVEL SHLD
PROPOSED GEOMETRICS
GRAVEL SHLD
US 301
UNDERGROUND CABLE MARKER
CITGO SIGN
MOBIL SIGN
RIGHT OF WAY LINE
STATION
MOBIL STATION
POINTER RIDGE DR
#1700
* Ref: Proposal Book for Conduit Typical Installation to Fire house.
B 4-26-94 INSTALL PRE EMPT FOR P/B POINTER RDG
A 8/7/73 AS BUILT
PM
REVISIONS
APPROVAL: CHIEF BUREAU OF TRAFFIC ENGINEERING
APPROVAL: ASS'T CHIEF ENGINEER TRAFFIC SAFETY
MARYLAND STATE ROADS COMMISSION
DIVISION OF TRAFFIC SAFETY
BUREAU OF TRAFFIC ENGINEERING
US 301 & POINTER RIDGE DRIVE
SIGNAL NO 16298
DATE 9-13-72
SCALE 1"-20'
DRAWN BY: WES GUCKERT
CONTRACT NO P-282-X-375
COUNTY PRINCE GEORGES
CHECKED BY:
DRAWING NO. TS 645 B