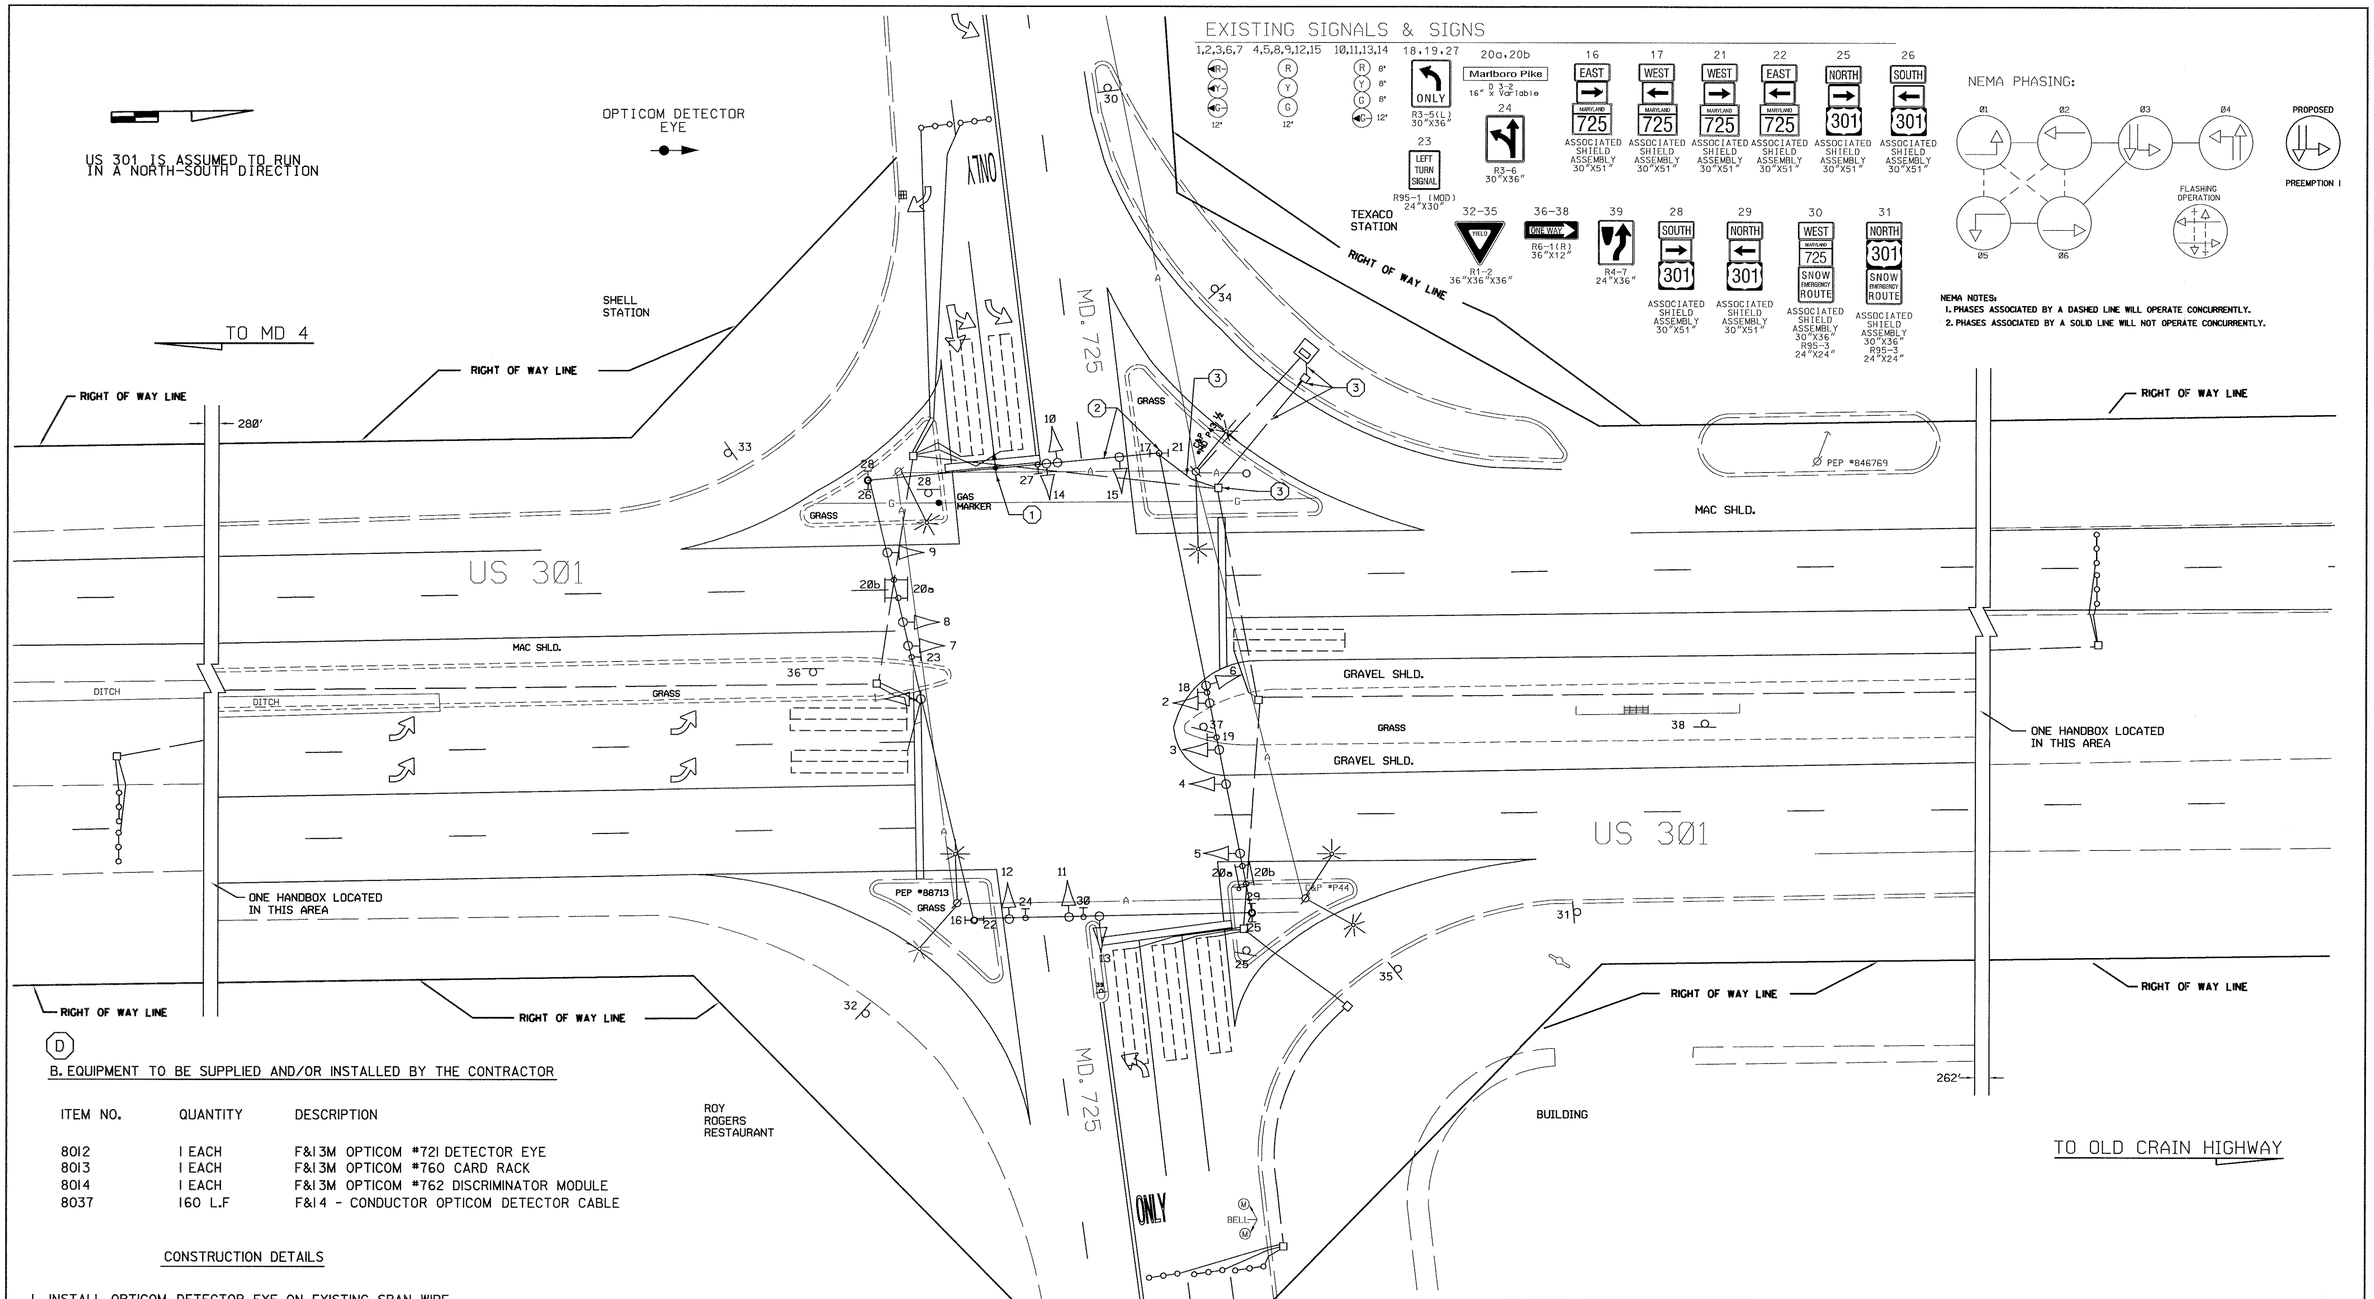

(D)

B. EQUIPMENT TO BE SUPPLIED AND/OR INSTALLED BY THE CONTRACTOR

ITEM NO.	QUANTITY	DESCRIPTION
8012	1 EACH	F&I 3M OPTICOM #721 DETECTOR EYE
8013	1 EACH	F&I 3M OPTICOM #760 CARD RACK
8014	1 EACH	F&I 3M OPTICOM #762 DISCRIMINATOR MODULE
8037	160 L.F	F&I 4 - CONDUCTOR OPTICOM DETECTOR CABLE

CONSTRUCTION DETAILS

1. INSTALL OPTICOM DETECTOR EYE ON EXISTING SPAN WIRE.
2. USE EXISTING SPAN WIRE AND STEEL POLE
3. USE EXISTING HANDHOLE AND CONDUIT.

UTILITY LEGEND

—G—G—	GAS MAIN
—W—W—	WATER MAIN
—S—S—	SEWER MAIN
—E—E—	ELECTRIC CABLES
—A—A—	AERIAL CABLES
—T—T—	TELEPHONE CABLES

REVISIONS

(D) INSTALL OPTICOM DETECTOR EYE EB MD 725 2/00

CEI

C. 05/96 - AS BUILT, INSTALL NEW SIGNAL POLE IN N/E & N/W, & NEW DETECTORS ALL DIRECTIONS

B. 10-28-91 - CHANGE NB & SB U.S. 301 E/P L.T.'S TO EXCLUSIVE L.T.'S - SHA #855-25032184

A. 10/84

OLD MD. 408

APPROVALS

ORIGINAL

ASST. TRAFFIC ENGINEERING DESIGN DIVISION

ON

ASST. DISTRICT ENGINEER, TRAFFIC

FILE

CHIEF, TRAFFIC ENGINEERING DESIGN DIVISION

DIRECTOR, TRAFFIC & SAFETY

CENTURY ENGINEERING, INC.
CONSULTING ENGINEERS - PLANNERS
32 WEST ROAD
TOWSON, MARYLAND 21204

MARYLAND DOT - STATE HIGHWAY ADMINISTRATION
Office of Traffic & Safety
TRAFFIC ENGINEERING DESIGN DIVISION

U.S. 301 & MD. 725

PG308A57/B57

RE-DRAWN BY:	SPP	F.A.P. NO.	AC-STPG-000S(683)E	TS NO. 871 (D)	SHEET NO.
CHECKED BY:	TMH/CJ	S.H.A. NO.	XX1005185		
SCALE:	1"= 20'	COUNTY:	PRINCE GEORGE'S	T.I.M.S. NO. D565	9 OF 24
DATE:	2/21/00	LOG MILE:	16030114.80		

c:*transdwg\97006*31*us301@725b.dgn
20 MAR 2000