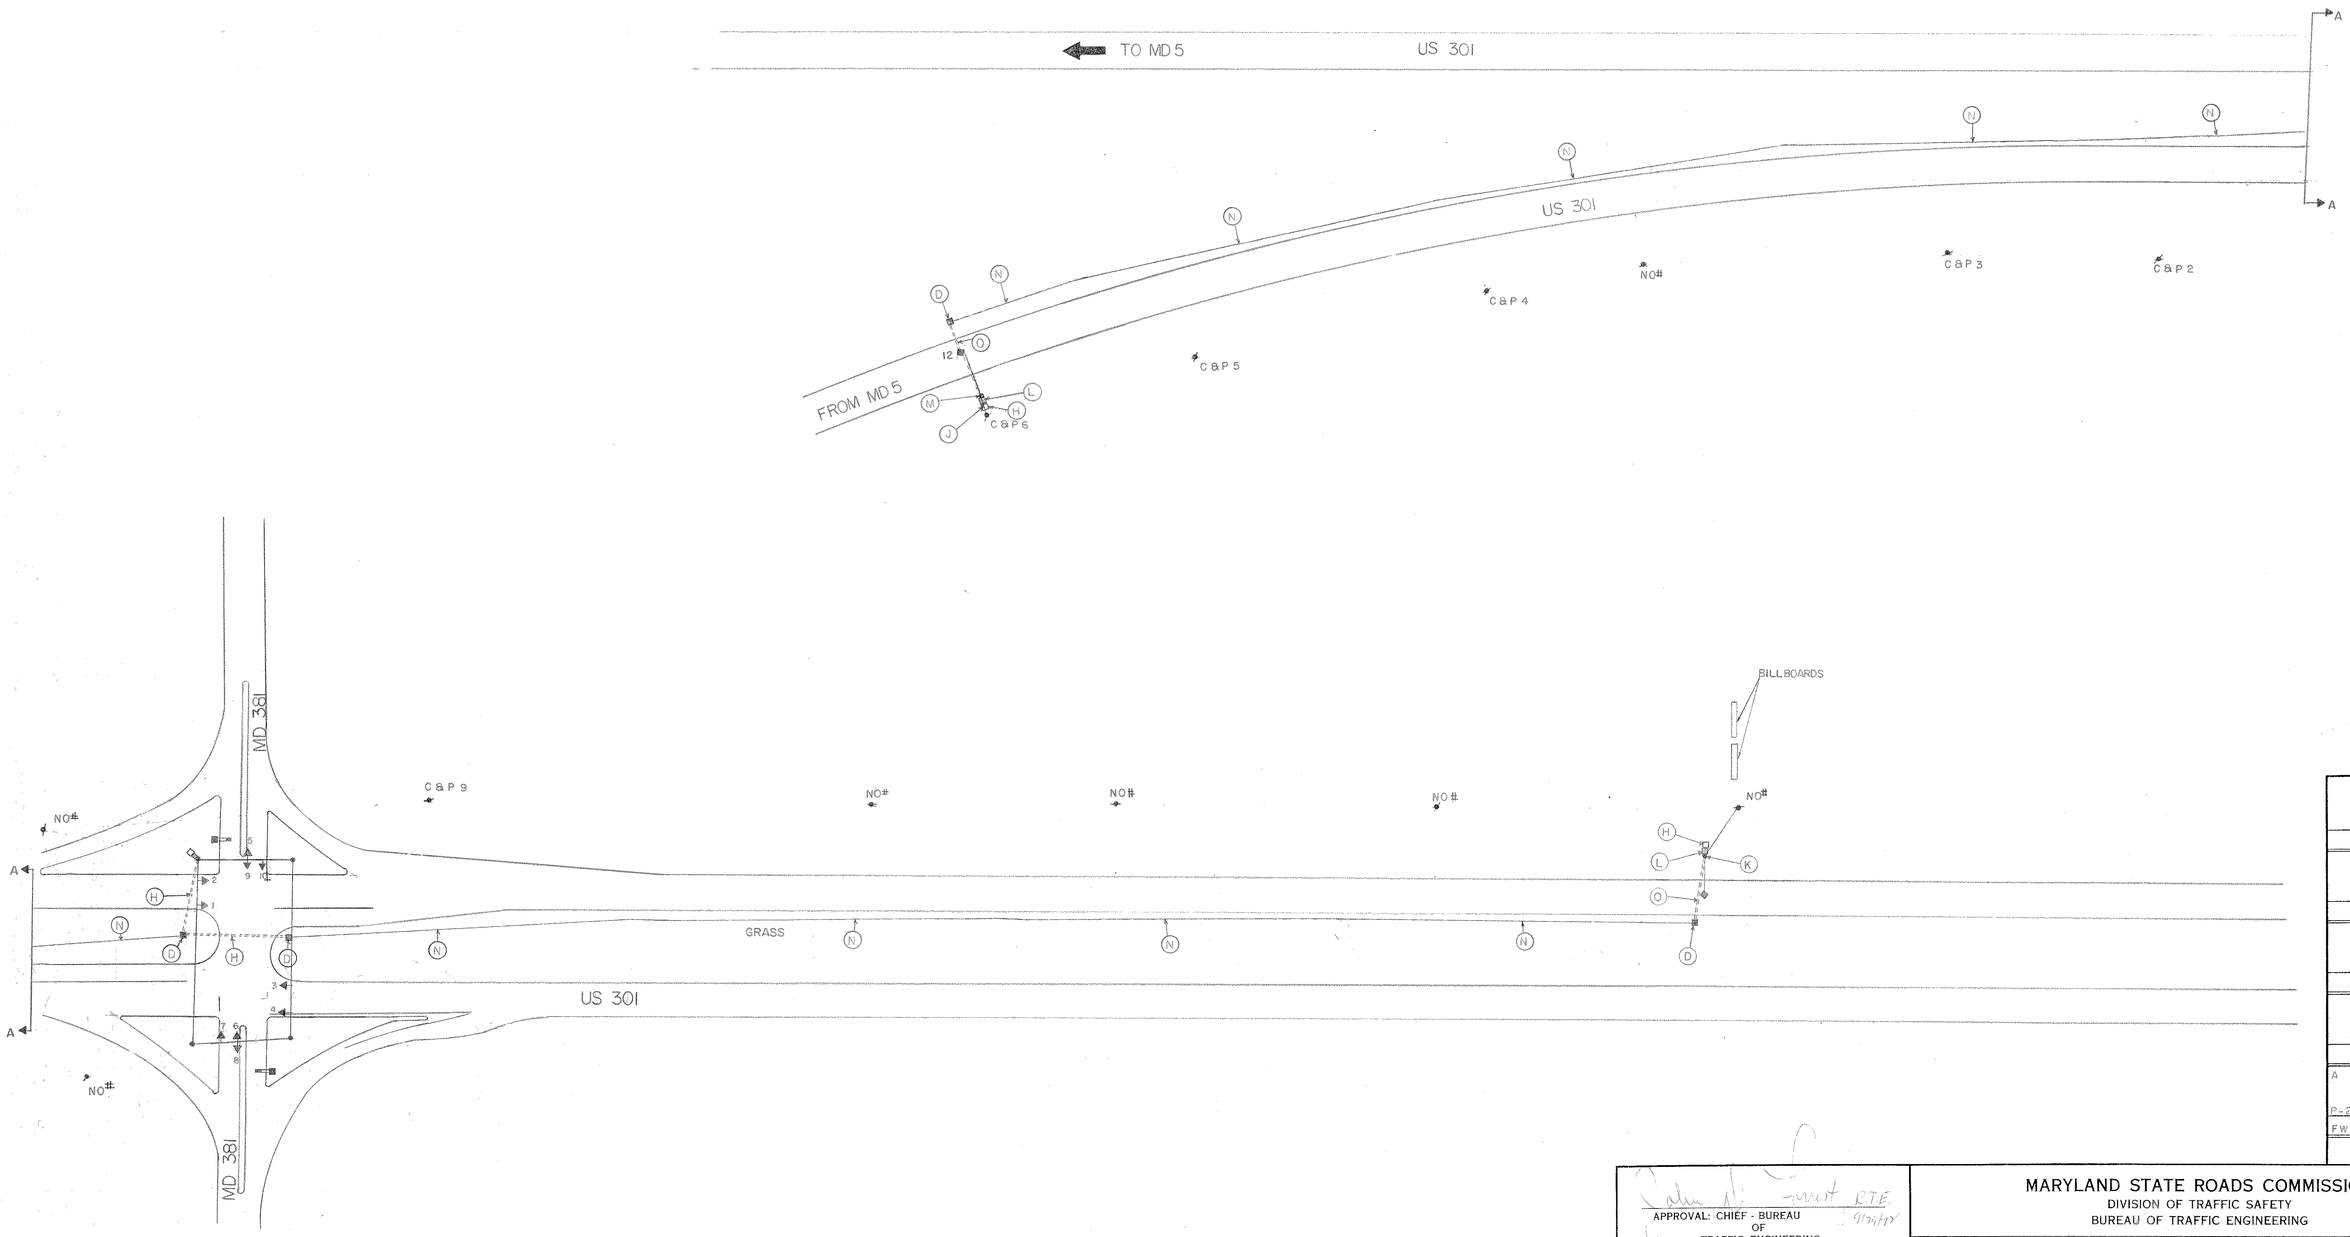

A		7-24-74
	ASBUILT	
P-269-X-385		
F.W.R.		

REVISIONS

APPROVAL: CHIEF - BUREAU OF TRAFFIC ENGINEERING — RTE 9/24/72

APPROVAL: ASS'T CHIEF ENGINEER TRAFFIC SAFETY — 9/25/72

MARYLAND STATE ROADS COMMISSION
DIVISION OF TRAFFIC SAFETY
BUREAU OF TRAFFIC ENGINEERING

INTERCONNECT - RED SIGNAL AHEAD
US 301 & MD 381

SIGNAL NO. 16060

DATE 9-29-72
SCALE 1"=50'
DRAWN BY: W. GUCKERT
CONTRACT NO.
COUNTY PRINCE GEORGES
CHECKED BY: William F. Foote

DRAWING NO. TS 686 A