F H WA REGION NO	STATE	FED. AID PROJ. NO	SHEET NO.	TOTAL SHEETS
3	MD.			

EXISTING SIGNALS & SIGN

1-7	8	9
R Y G 12"	R3-1 24" x 24"	NO TURN ON RED R10-11b 24" x 24"

NEMA PHASES:

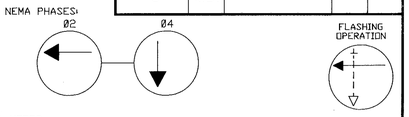

NEMA NOTES:
1. PHASES ASSOCIATED BY A DASHED LINE WILL OPERATE CONCURRENTLY.
2. PHASES ASSOCIATED BY A SOLID LINE WILL NOT OPERATE CONCURRENTLY.

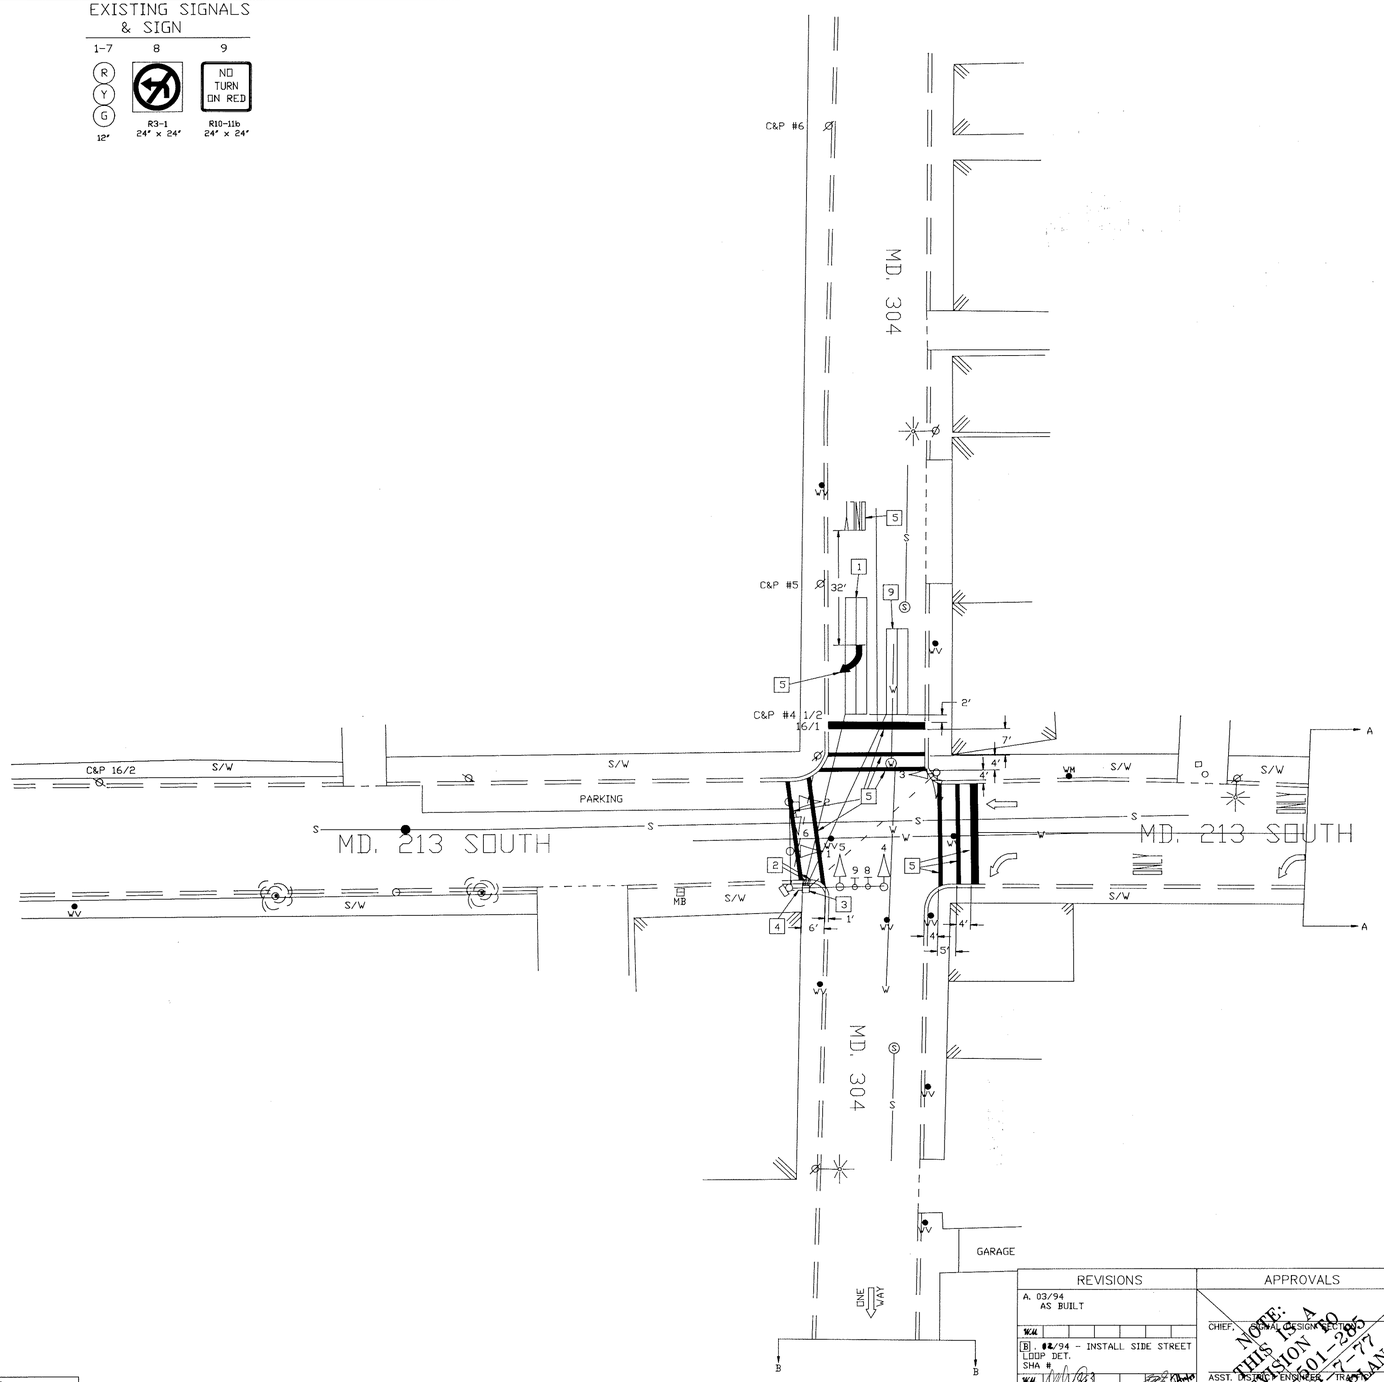

GENERAL NOTES:
1. 'D.O' INDICATES A DELAY-OUTPUT LOOP DETECTOR.
2. REVISION 'B' IS A MODIFICATION TO WORK COMPLETED UNDER CONTRACT NO. Q 560-501-285, DATED 2-7-77.
3. THE ORIGINAL T.S. 1493 IS ON FILE.
4. MD. 213 RUNS IN A NORTH-SOUTH DIRECTION.

UTILITY LEGEND

—G—G—	GAS MAIN
—W—W—	WATER MAIN
—S—S—	SEWER MAIN
—E—E—	ELECTRIC CABLES
—A—A—	AERIAL CABLES
—T—T—	TELEPHONE CABLES

REVISIONS

A. 03/94 AS BUILT

B. 02/94 - INSTALL SIDE STREET LOOP DET. SHA #

APPROVALS

CHIEF, SIGNAL DESIGN SECTION

ASST. DISTRICT ENGINEER, TRAFFIC

CHIEF, TRAFFIC ENGINEERING DESIGN DIVISION

DIRECTOR, OFFICE OF TRAFFIC & SAFETY

NOTE: THIS IS A REVISION TO Q 560-501-285 DATED 2-7-77 ORIGINAL PLAN ON FILE

MDOT – STATE HIGHWAY ADMINISTRATION
Office of Traffic & Safety
TRAFFIC ENGINEERING DESIGN DIVISION SIGNAL # ~~175213007.61~~

DRAWN BY: B. THOMPSON
DES. BY: B. THOMPSON
CHK. BY: A. BUDNICHUK 10/11/77

MD. 213 (LIBERTY ST.) & MD. 304 (WATER ST.)
BOOK NO. 19039 CENTREVILLE, MD. COUNTY: QUEEN ANNE'S

DATE: 2-7-77 F.A.P. NO.
SCALE: 1" = 20' S.H.A. NO. Q 560-501-285

TS/STD. NO. TS-1493 B

SHEET NO. 1 OF 1

~~17030403.25~~