FHWA REGION NO.	STATE	FED. AID PROJ. NO.	SHEET NO.	TOTAL SHEETS
3	MD			

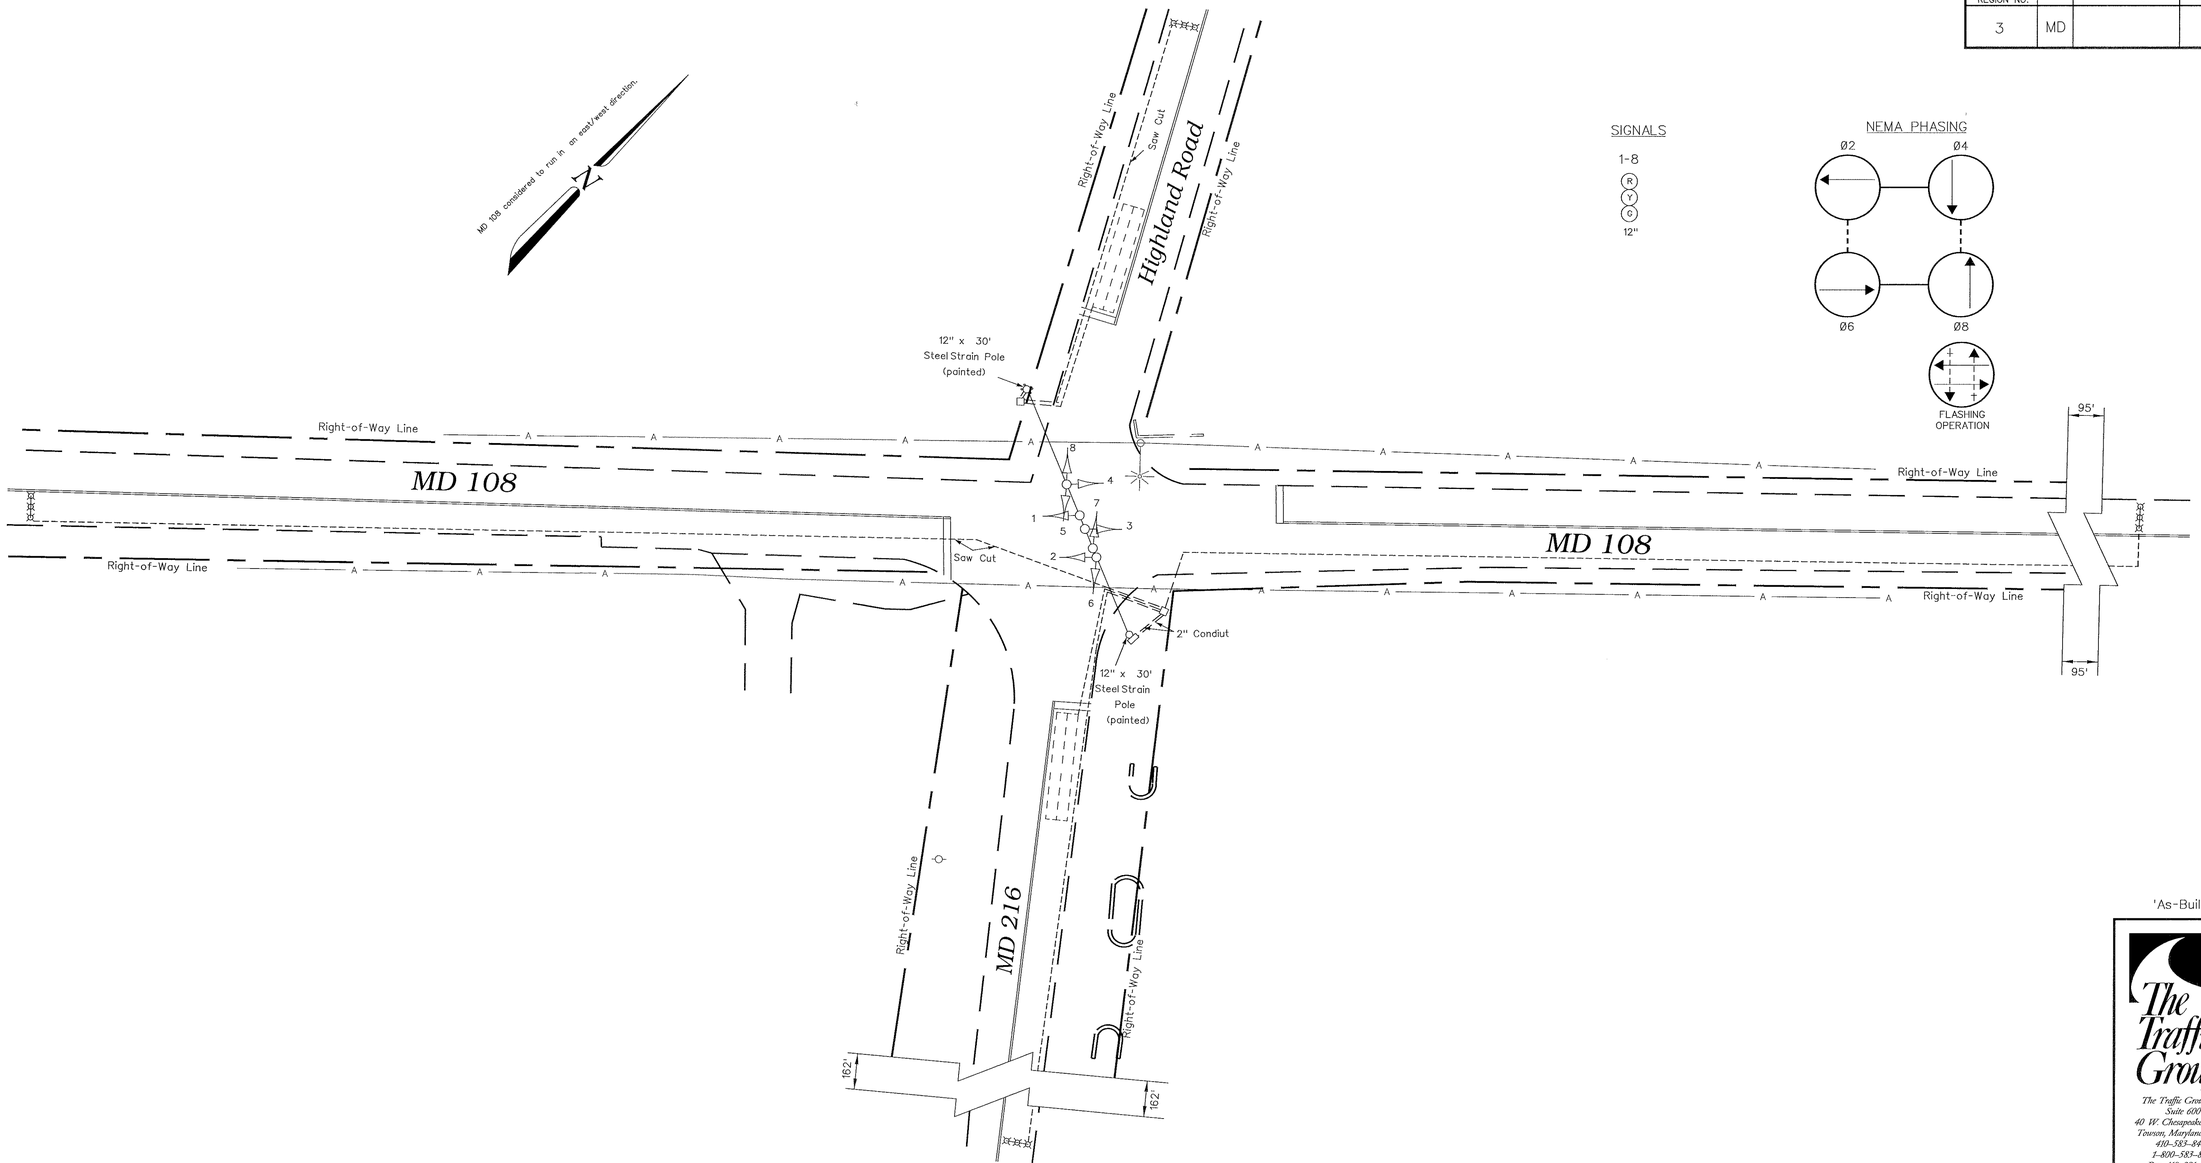

'As-Built"

The Traffic Group

The Traffic Group, Inc.
Suite 600
40 W. Chesapeake Avenue
Towson, Maryland 21204
410-583-8405
1-800-583-8411
Fax 410-321-8458
Job. No. 960422

GEOMETRIC LEGEND

EXISTING GEOMETRICS
PROPOSED GEOMETRICS

UTILITY LEGEND

GAS MAIN
WATER MAIN
SEWER MAIN
ELECTRIC CABLES
STORM DRAIN
AERIAL CABLES
TELEPHONE CABLES

REVISIONS

May 10, 1996
"As-Built"
S.H.A. No.: AW-794-501-785
FJH

APPROVALS

ASST. DIVISION CHIEF TRAFFIC ENGINEERING DESIGN DIVISION
CHIEF, TRAFFIC ENGINEERING DESIGN DIVISION
ASST. DISTRICT ENGINEER - TRAFFIC
DIRECTOR, OFFICE OF TRAFFIC & SAFETY

ORIGINAL ON FILE

MDOT – STATE HIGHWAY ADMINISTRATION
Office of Traffic & Safety
TRAFFIC ENGINEERING DESIGN DIVISION

DRAWN BY: J. Gordon
DES. BY: J. Gordon
CHK. BY: A. Budnichuck

(Traffic Signal Plan)
MD 108 at MD 216/ Highland Road
COUNTY: HOWARD
LOG MILE •1301000 1.53

DATE: 7/2/76
SCALE: 1" = 20'
F.A.P. NO. N/A
S.H.A. NO. HO 558-501-785
TS/STD. NO. 1436D-P
SHEET NO. 1 of 1