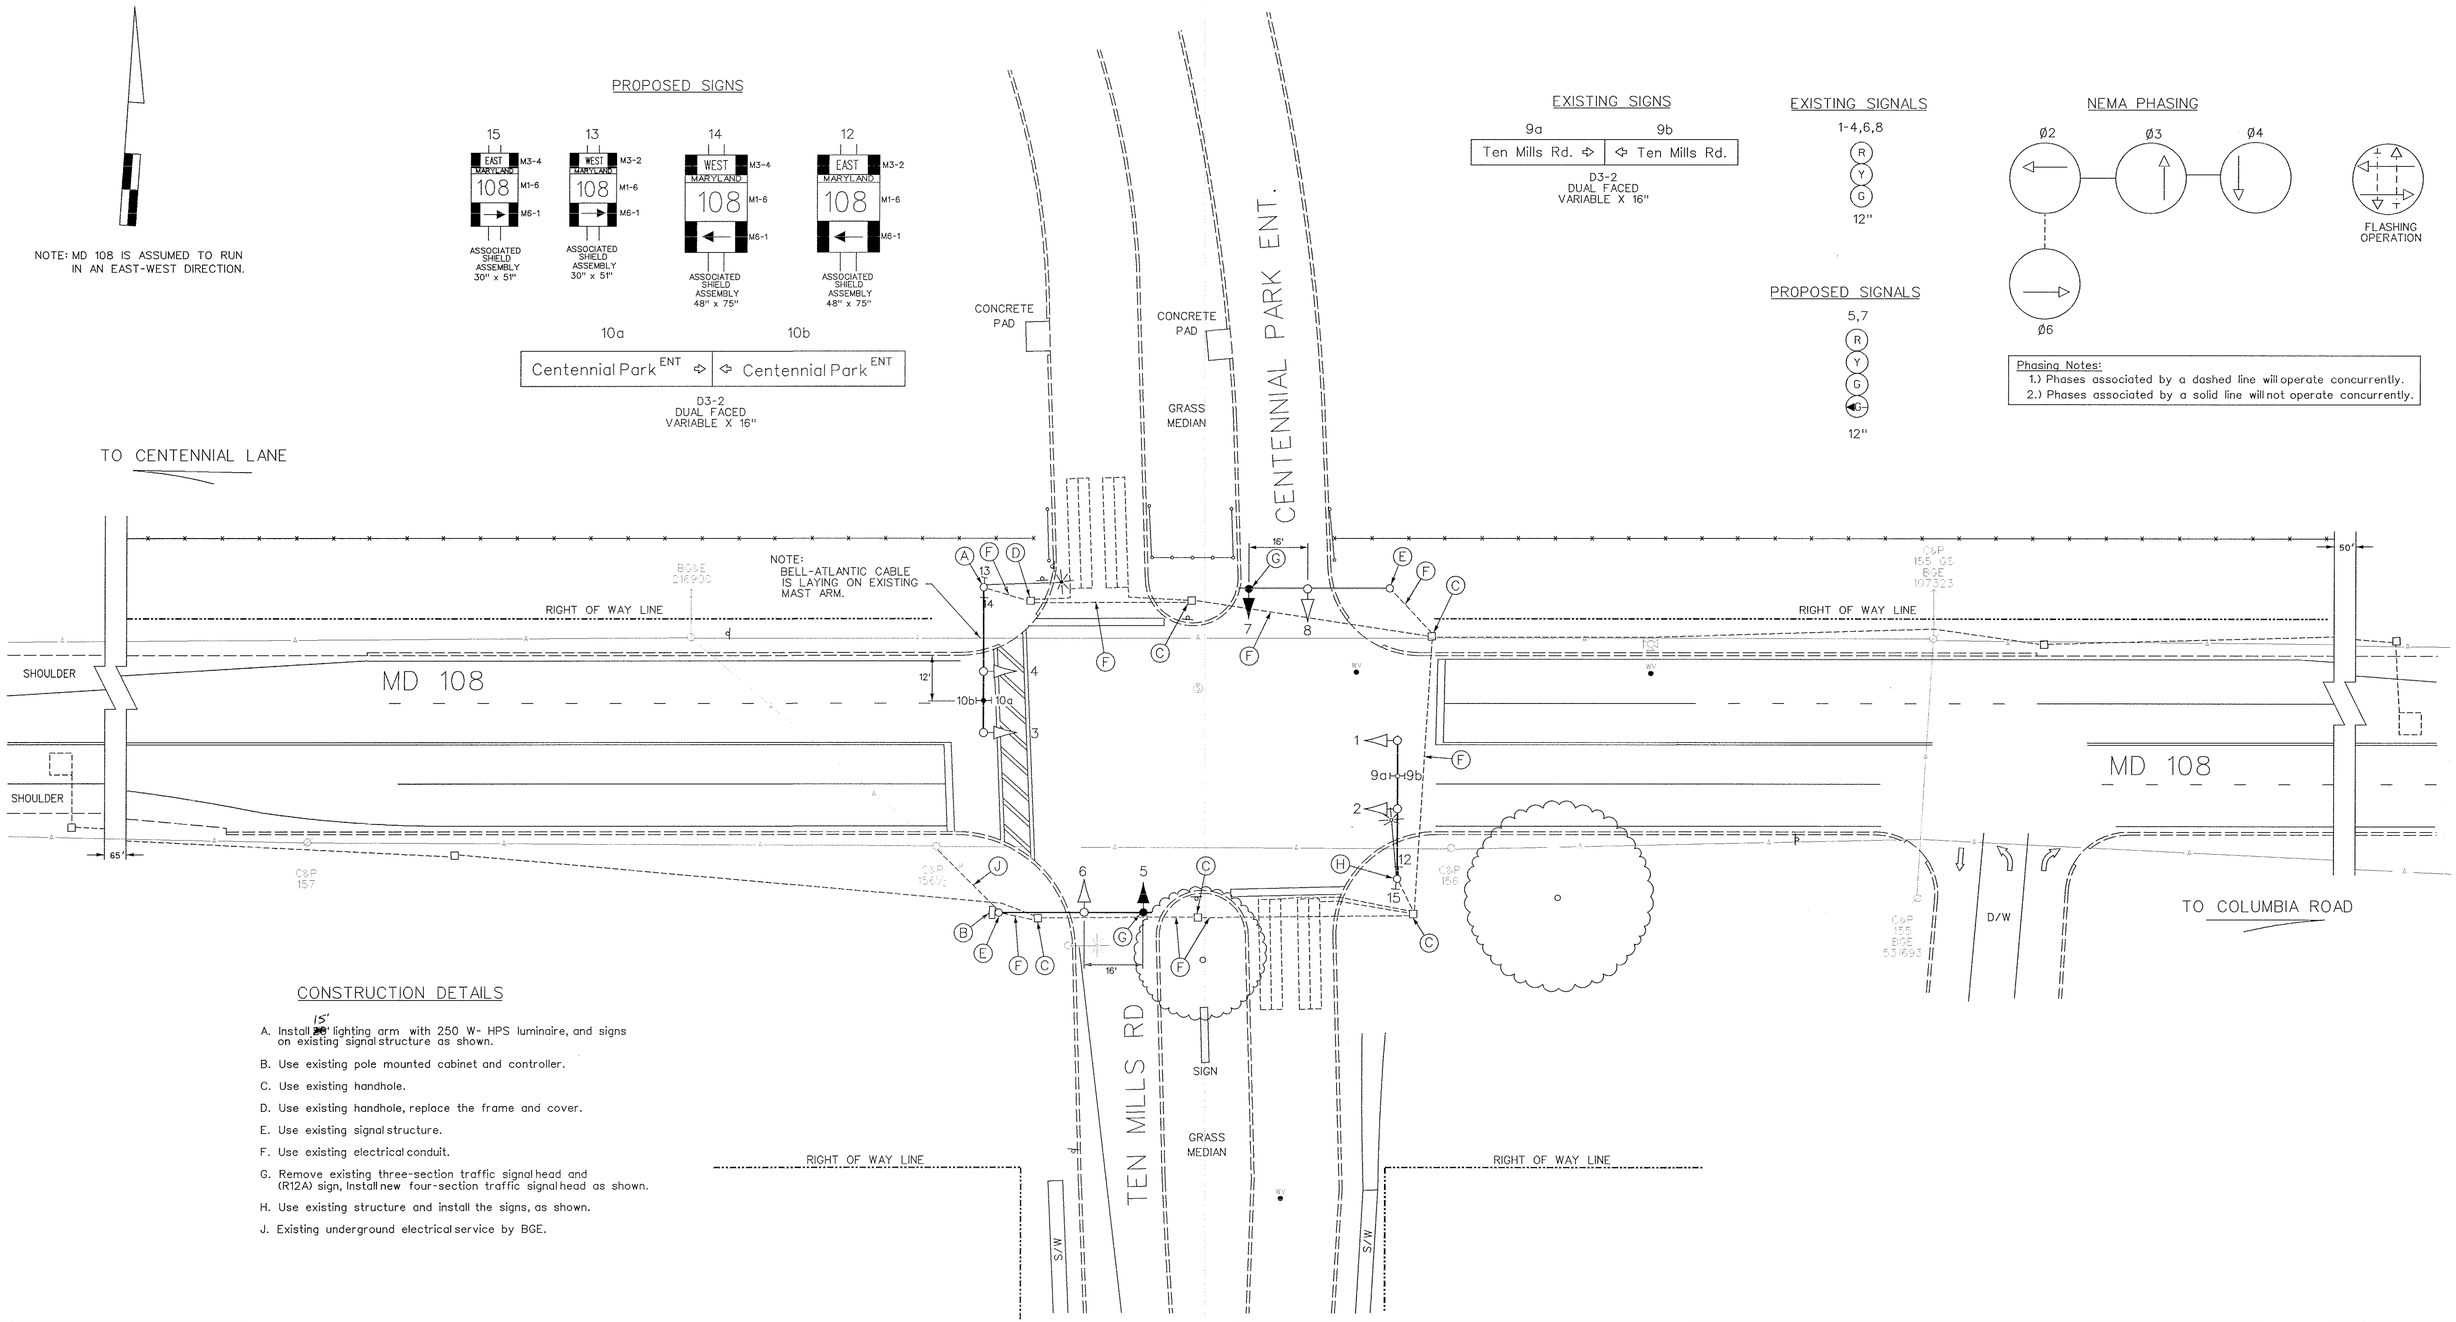

CONSTRUCTION DETAILS

A. Install ~~20'~~ 15' lighting arm with 250 W- HPS luminaire, and signs on existing signal structure as shown.

B. Use existing pole mounted cabinet and controller.

C. Use existing handhole.

D. Use existing handhole, replace the frame and cover.

E. Use existing signal structure.

F. Use existing electrical conduit.

G. Remove existing three-section traffic signal head and (R12A) sign, Install new four-section traffic signal head as shown.

H. Use existing structure and install the signs, as shown.

J. Existing underground electrical service by BGE.

GEOMETRIC LEGEND

PROPOSED ————————

EXISTING — — — — — — — —

LEGEND OF UNDERGROUND AND OVERHEAD UTILITIES

AERIAL CABLE	—— A —— A ——
ELECTRIC	—— E —— E ——
TELEPHONE	—— T —— T ——
GAS	—— G —— G ——
SEWER	—— S —— S ——
WATER	—— W —— W ——
CABLE TV	—— TV —— TV ——

REVISION "A"

STREET TRAFFIC STUDIES, LTD.

Gateway International
1302 Concourse Drive, Suite 104
Linthicum, Maryland 21090
Ph (410) 859-3553
Fax (410) 859-3579

TASK27.dgn

REVISIONS

RTB

Ⓐ 5-10-99
SPLIT SIDE ROAD PHASING, ADD RT. SIGN, AND ADD LUMINAIRE.
SHA NO. XX100578S

EMM RTB

APPROVALS

ASST. CHIEF TEDD SECTION

ASST. DISTRICT ENGINEER, TRAFFIC

CHIEF, TRAFFIC ENGINEERING DESIGN DIVISION

DIRECTOR, TRAFFIC & SAFETY

ORIGINAL ON FILE

MARYLAND DOT - STATE HIGHWAY ADMINISTRATION
Office of Traffic & Safety
TRAFFIC ENGINEERING DESIGN DIVISION
MD 108 AND TEN MILLS RD / CENTENNIAL PARK ENTRANCE

DRAWN BY: J J DIRNDORFER	COUNTY: HOWARD	TS NO. 2121A	SHEET NO. 1 OF 2
CHECK BY: S.G.R.	LOG MILE: 13010808.98		
DATE: 11-21-85	F.A.P. NO. AC-STPG-7005(687)E	T.I.M.S. NO. D-250	
SCALE: 1"= 20'	S.H.A. NO. H0830A51/B51		