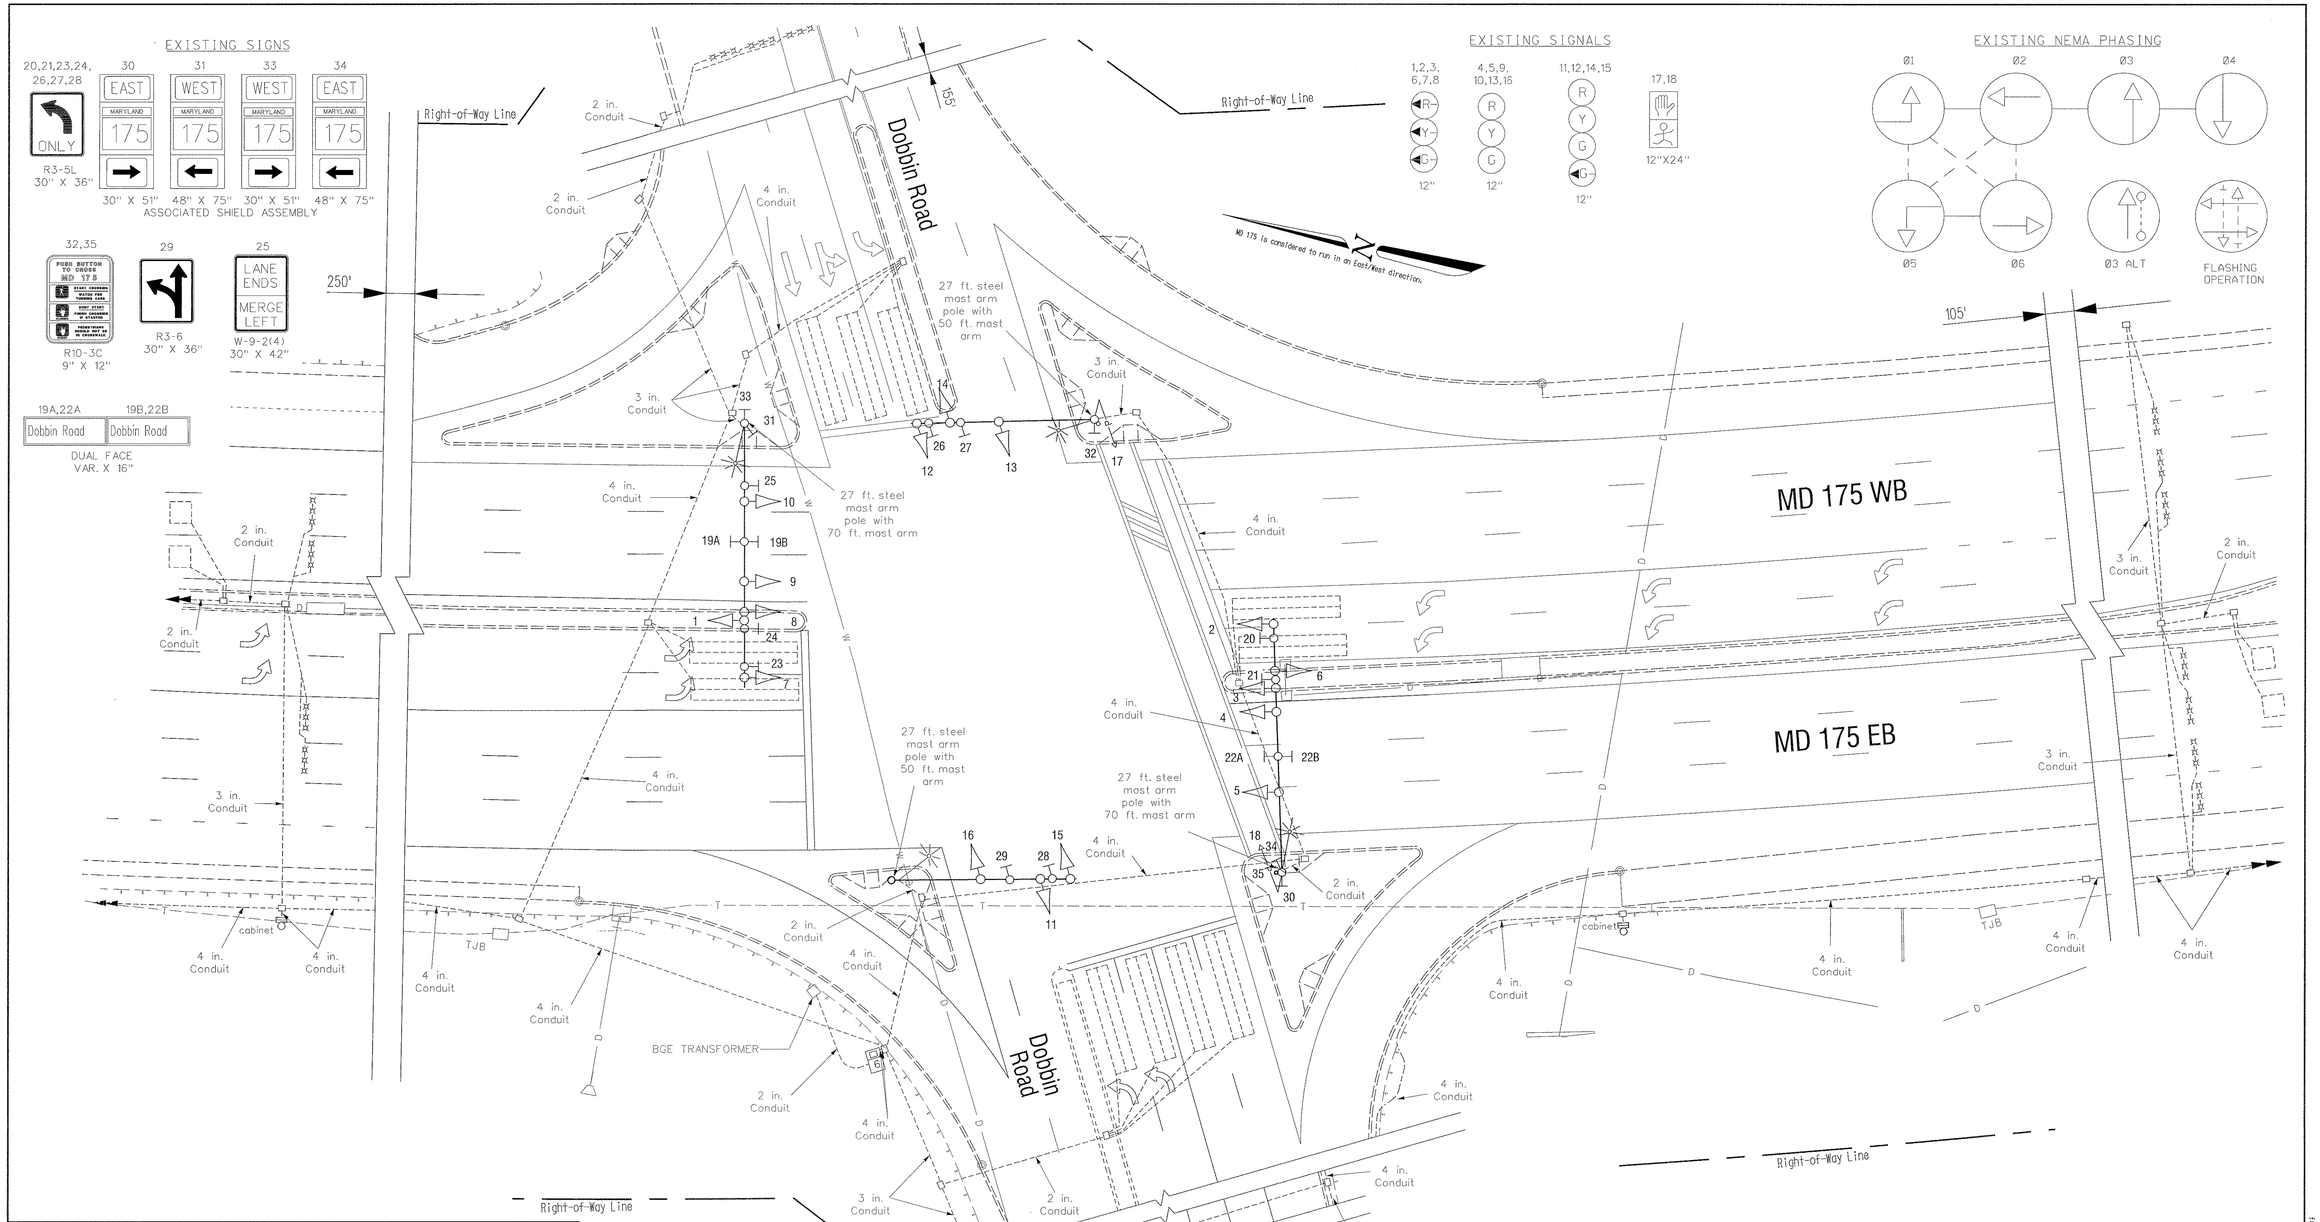


GEOMETRIC LEGEND

EXISTING GEOMETRICS
PROPOSED GEOMETRICS

UTILITY LEGEND

| | |
|---|---|
| G — G | GAS MAIN |
| W — W | WATER MAIN |
| S — S | SEWER MAIN |
| E — E | ELECTRIC CABLES |
| D — D | STORM DRAIN |
| A — A | AERIAL CABLES |
| T — T | TELEPHONE CABLES |

"AS-BUILT"

The Traffic Group

The Traffic Group, Inc.
410-931-6600
Fax 410-931-6601

REVISIONS

January 3, 2001

ASBUILT
S.H.A. No.:BW996MB2
FJH

APPROVALS

TEAM LEADER, TRAFFIC ENGINEERING DESIGN DIVISION
ASST. CHIEF TRAFFIC ENGINEERING DESIGN DIVISION
CHIEF, TRAFFIC ENGINEERING DESIGN DIVISION
DIRECTOR, TRAFFIC & SAFETY

ORIGINAL ON FILE

MARYLAND DOT - STATE HIGHWAY ADMINISTRATION
*Office of Traffic & Safety*
TRAFFIC ENGINEERING DESIGN DIVISION
(Traffic Signal Plan)

# *MD 175 at Dobbin Road*

| | | | | | |
|---|---|---|---|---|---|
| DRAWN BY: | J.G./D.Zafris | F.A.P. NO. | N/A | TS NO. 1396F | SHEET NO. |
| CHECKED BY: | | S.H.A. NO. | HO-400-501-785 | | |
| SCALE: | 1" = 20' | COUNTY: | Howard | T.I.M.S. NO. XXX | 1 OF 1 |
| DATE: | March 16, 1976 | LOG MILE: | 1301754.18 | | |

f:\2000\2000-051\dea-as-built.dgn 09 JAN 2001