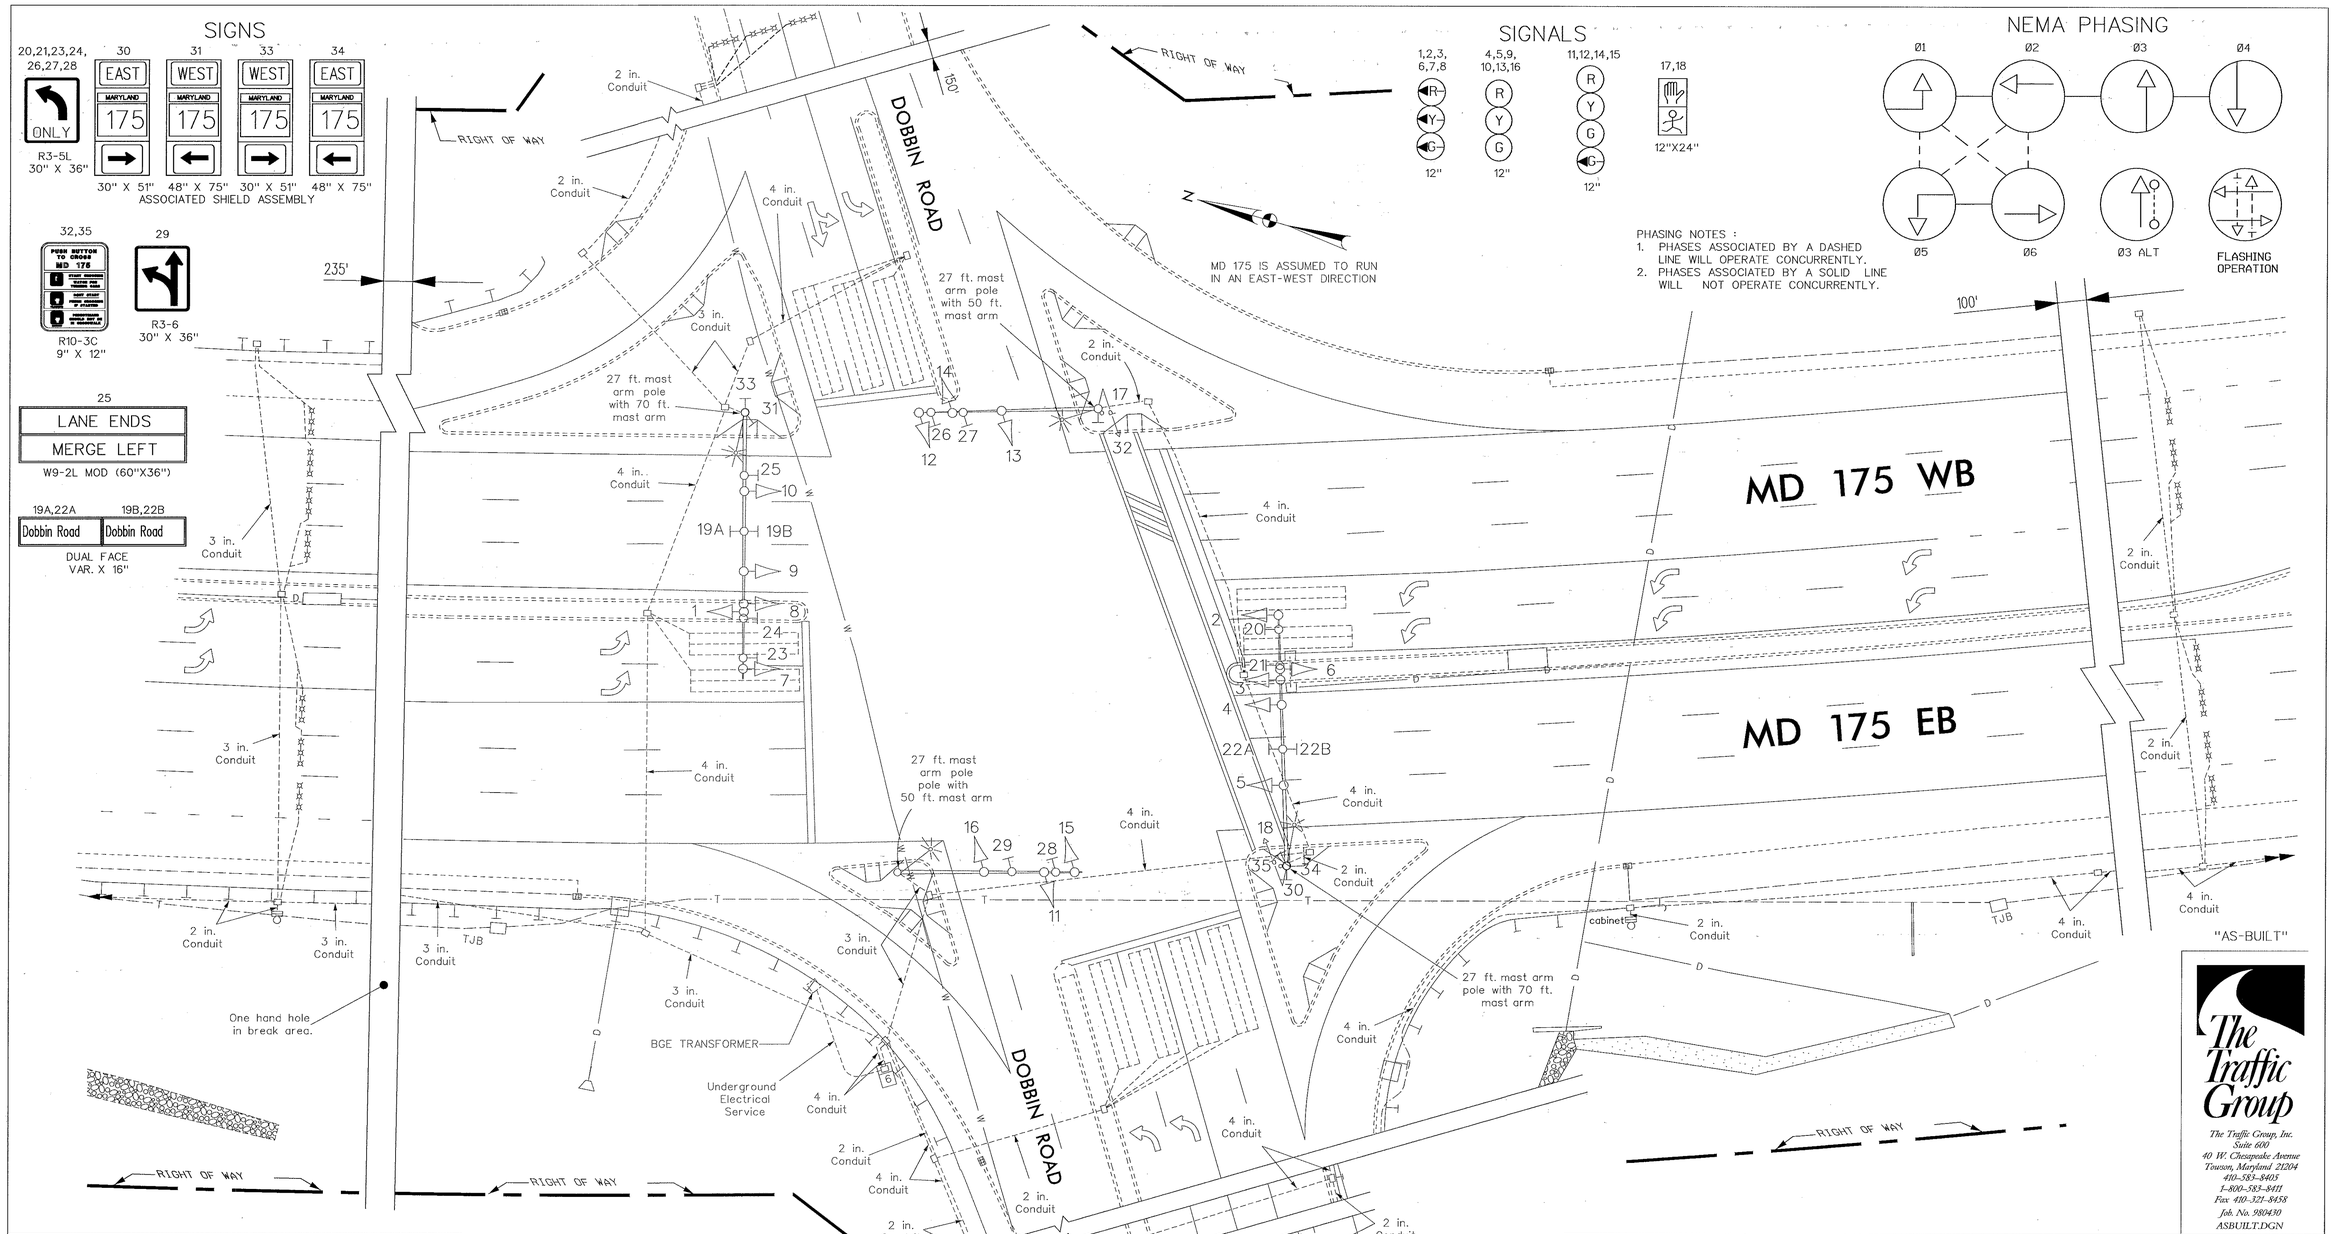

GEOMETRIC LEGEND

EXISTING GEOMETRICS

PROPOSED GEOMETRICS

UTILITY LEGEND

G — G	GAS MAIN
W — W	WATER MAIN
S — S	SEWER MAIN
E — E	ELECTRIC CABLES
D — D	STORM DRAIN
A — A	AERIAL CABLES
T — T	TELEPHONE CABLES

REVISIONS

(F) AS-Built June 12, 1998
S.H.A. No.:
J.S.F.H.

APPROVALS

ASST. TRAFFIC ENGINEERING DESIGN DIVISION

ASST. DISTRICT ENGINEER - TRAFFIC

CHIEF, TRAFFIC ENGINEERING DESIGN DIVISION

DIRECTOR, OFFICE OF TRAFFIC & SAFETY

ORIGINAL ON FILE

MDOT – STATE HIGHWAY ADMINISTRATION

Office of Traffic & Safety

TRAFFIC ENGINEERING DESIGN DIVISION

(Traffic Signal Plan)

MD 175 at Dobbin Road

DATE: March 16, 1976

LOG MILE • 13017504.18

DRAWN BY: J.G./D. Zafris	F.A.P. NO.	N/A	PLAN SHEET NO.:	SHEET NO.
CHK. BY: N/A	S.H.A. NO.	HO-400-501-785	1396F	1 of 1
SCALE: 1" = 20'	COUNTY:	HOWARD		

f:\980410\asbuilt.dgn 15 JUN 98