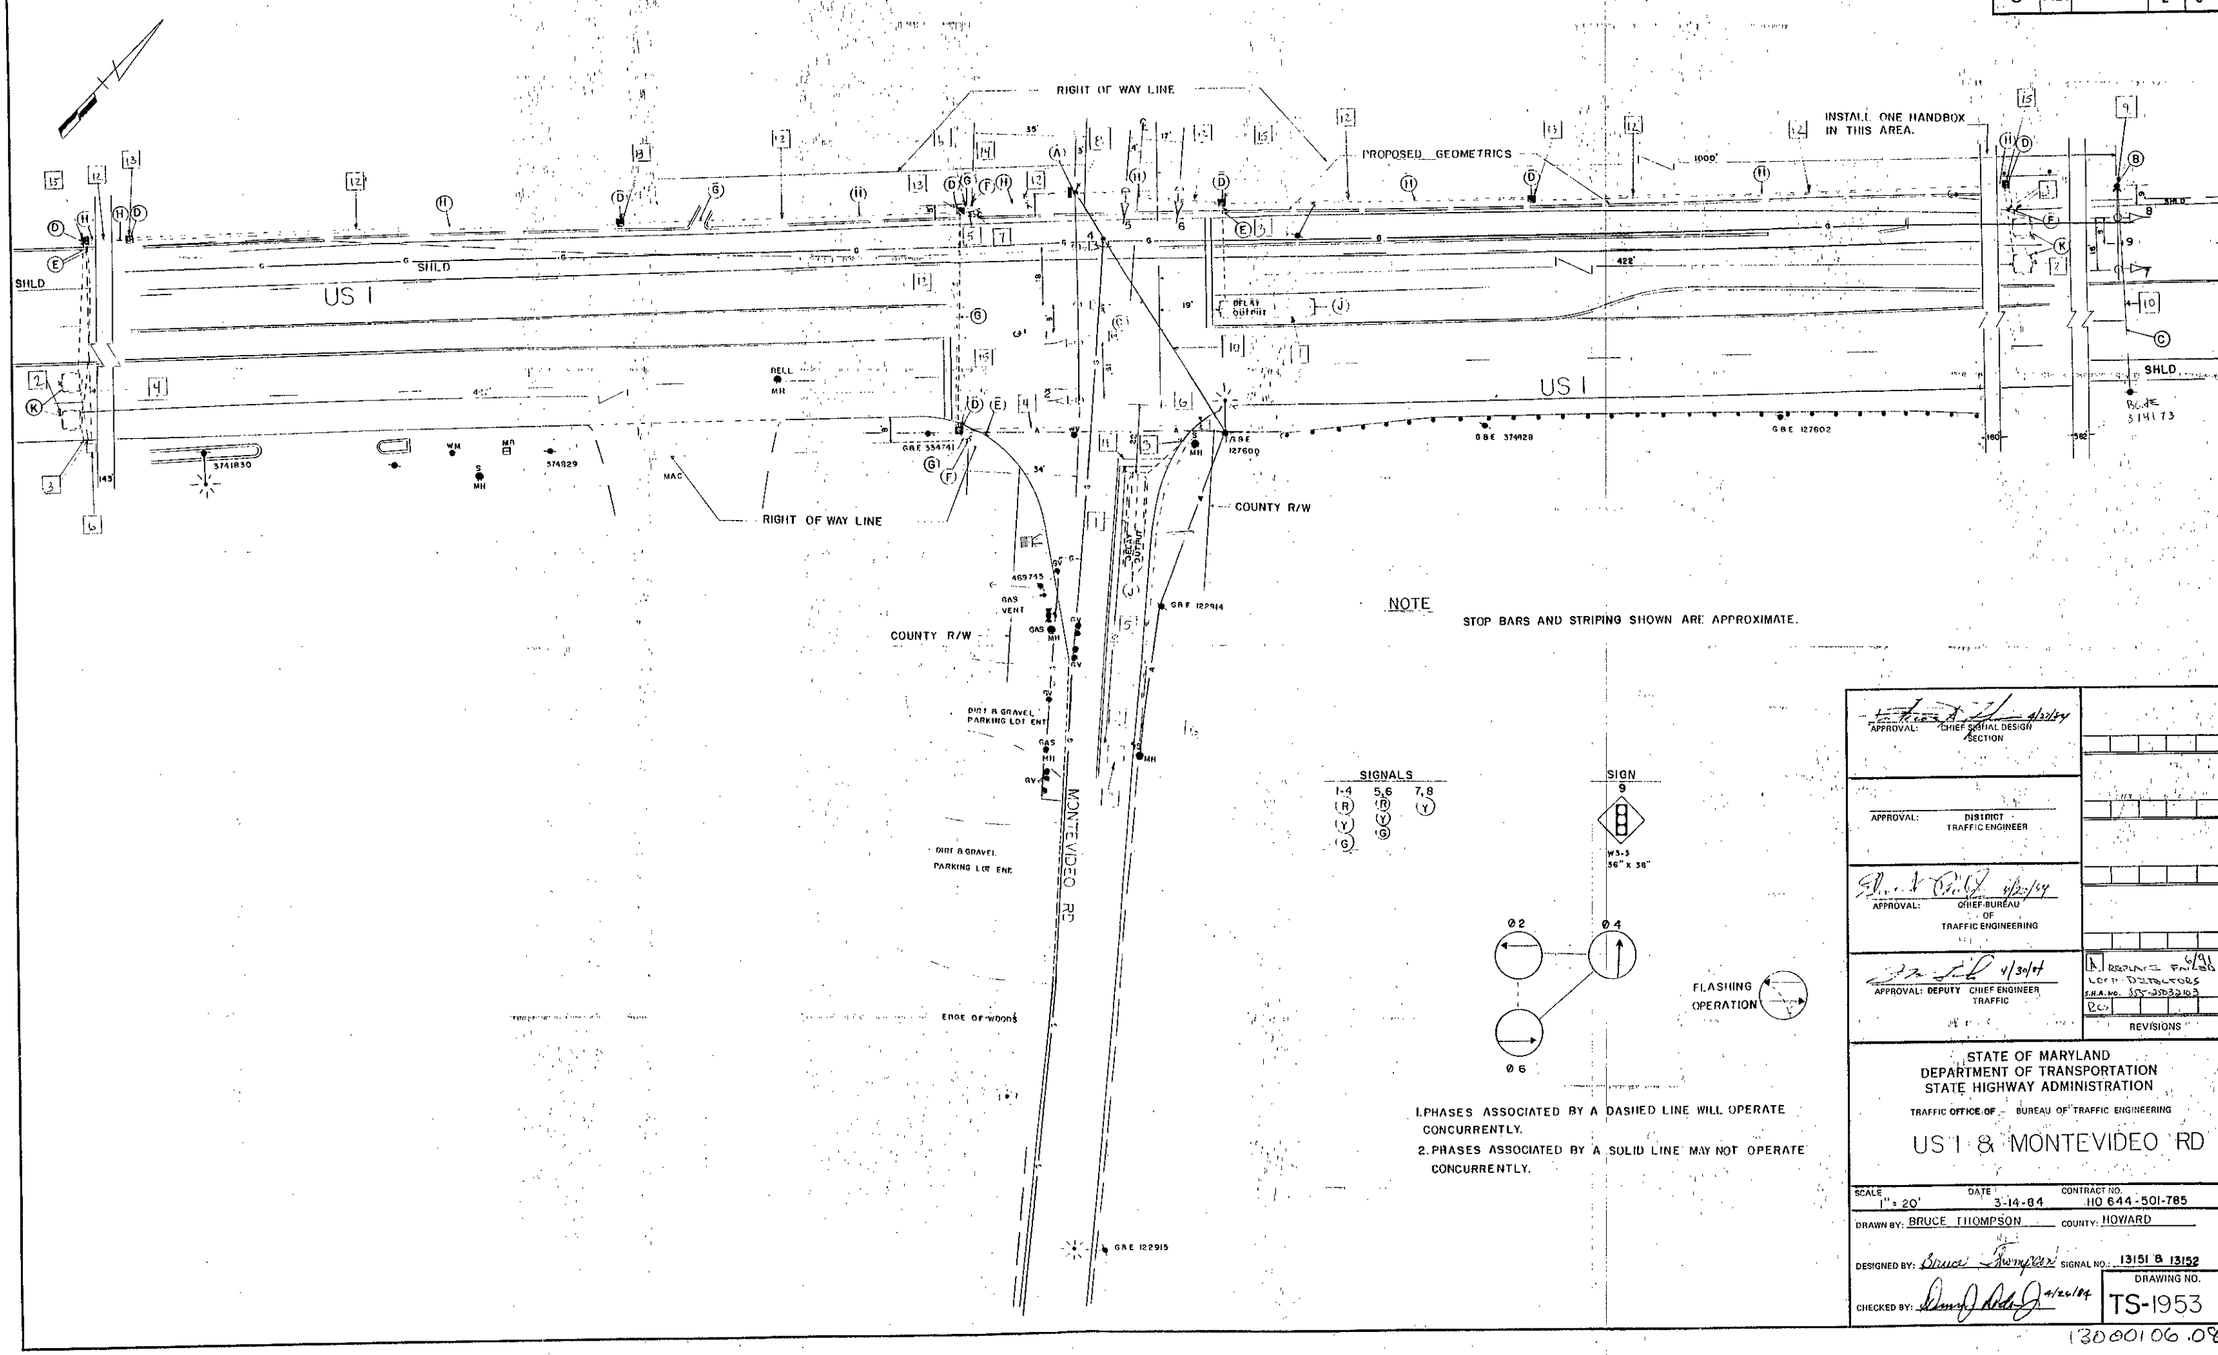
RIGHT OF WAY LINE
PROPOSED GEOMETRICS
INSTALL ONE HANDBOX IN THIS AREA.
SHLD
US 1
DELAY OUTPUT
COUNTY R/W
MONTEVIDEO RD
DIRT & GRAVEL PARKING LOT ENT
EDGE OF WOODS
GAS VENT
GBE 127602
GBE 374928
GBE 127600
GBE 122914
GBE 122915
3741830
374829
NOTE
STOP BARS AND STRIPING SHOWN ARE APPROXIMATE.
SIGNALS
1-4 5,6 7,8
SIGN
9
W3-3
36" x 36"
Ø2
Ø4
Ø6
FLASHING OPERATION
1. PHASES ASSOCIATED BY A DASHED LINE WILL OPERATE CONCURRENTLY.
2. PHASES ASSOCIATED BY A SOLID LINE MAY NOT OPERATE CONCURRENTLY.
APPROVAL: CHIEF SIGNAL DESIGN SECTION
APPROVAL: DISTRICT TRAFFIC ENGINEER
APPROVAL: CHIEF-BUREAU OF TRAFFIC ENGINEERING
APPROVAL: DEPUTY CHIEF ENGINEER TRAFFIC
REVISIONS
STATE OF MARYLAND
DEPARTMENT OF TRANSPORTATION
STATE HIGHWAY ADMINISTRATION
TRAFFIC OFFICE OF BUREAU OF TRAFFIC ENGINEERING
US 1 & MONTEVIDEO RD
SCALE 1" = 20'
DATE 3-14-84
CONTRACT NO. HO 644-501-785
DRAWN BY: BRUCE THOMPSON
COUNTY: HOWARD
DESIGNED BY: Bruce Thompson
SIGNAL NO.: 13151 & 13152
CHECKED BY:
DRAWING NO. TS-1953

13000106.08