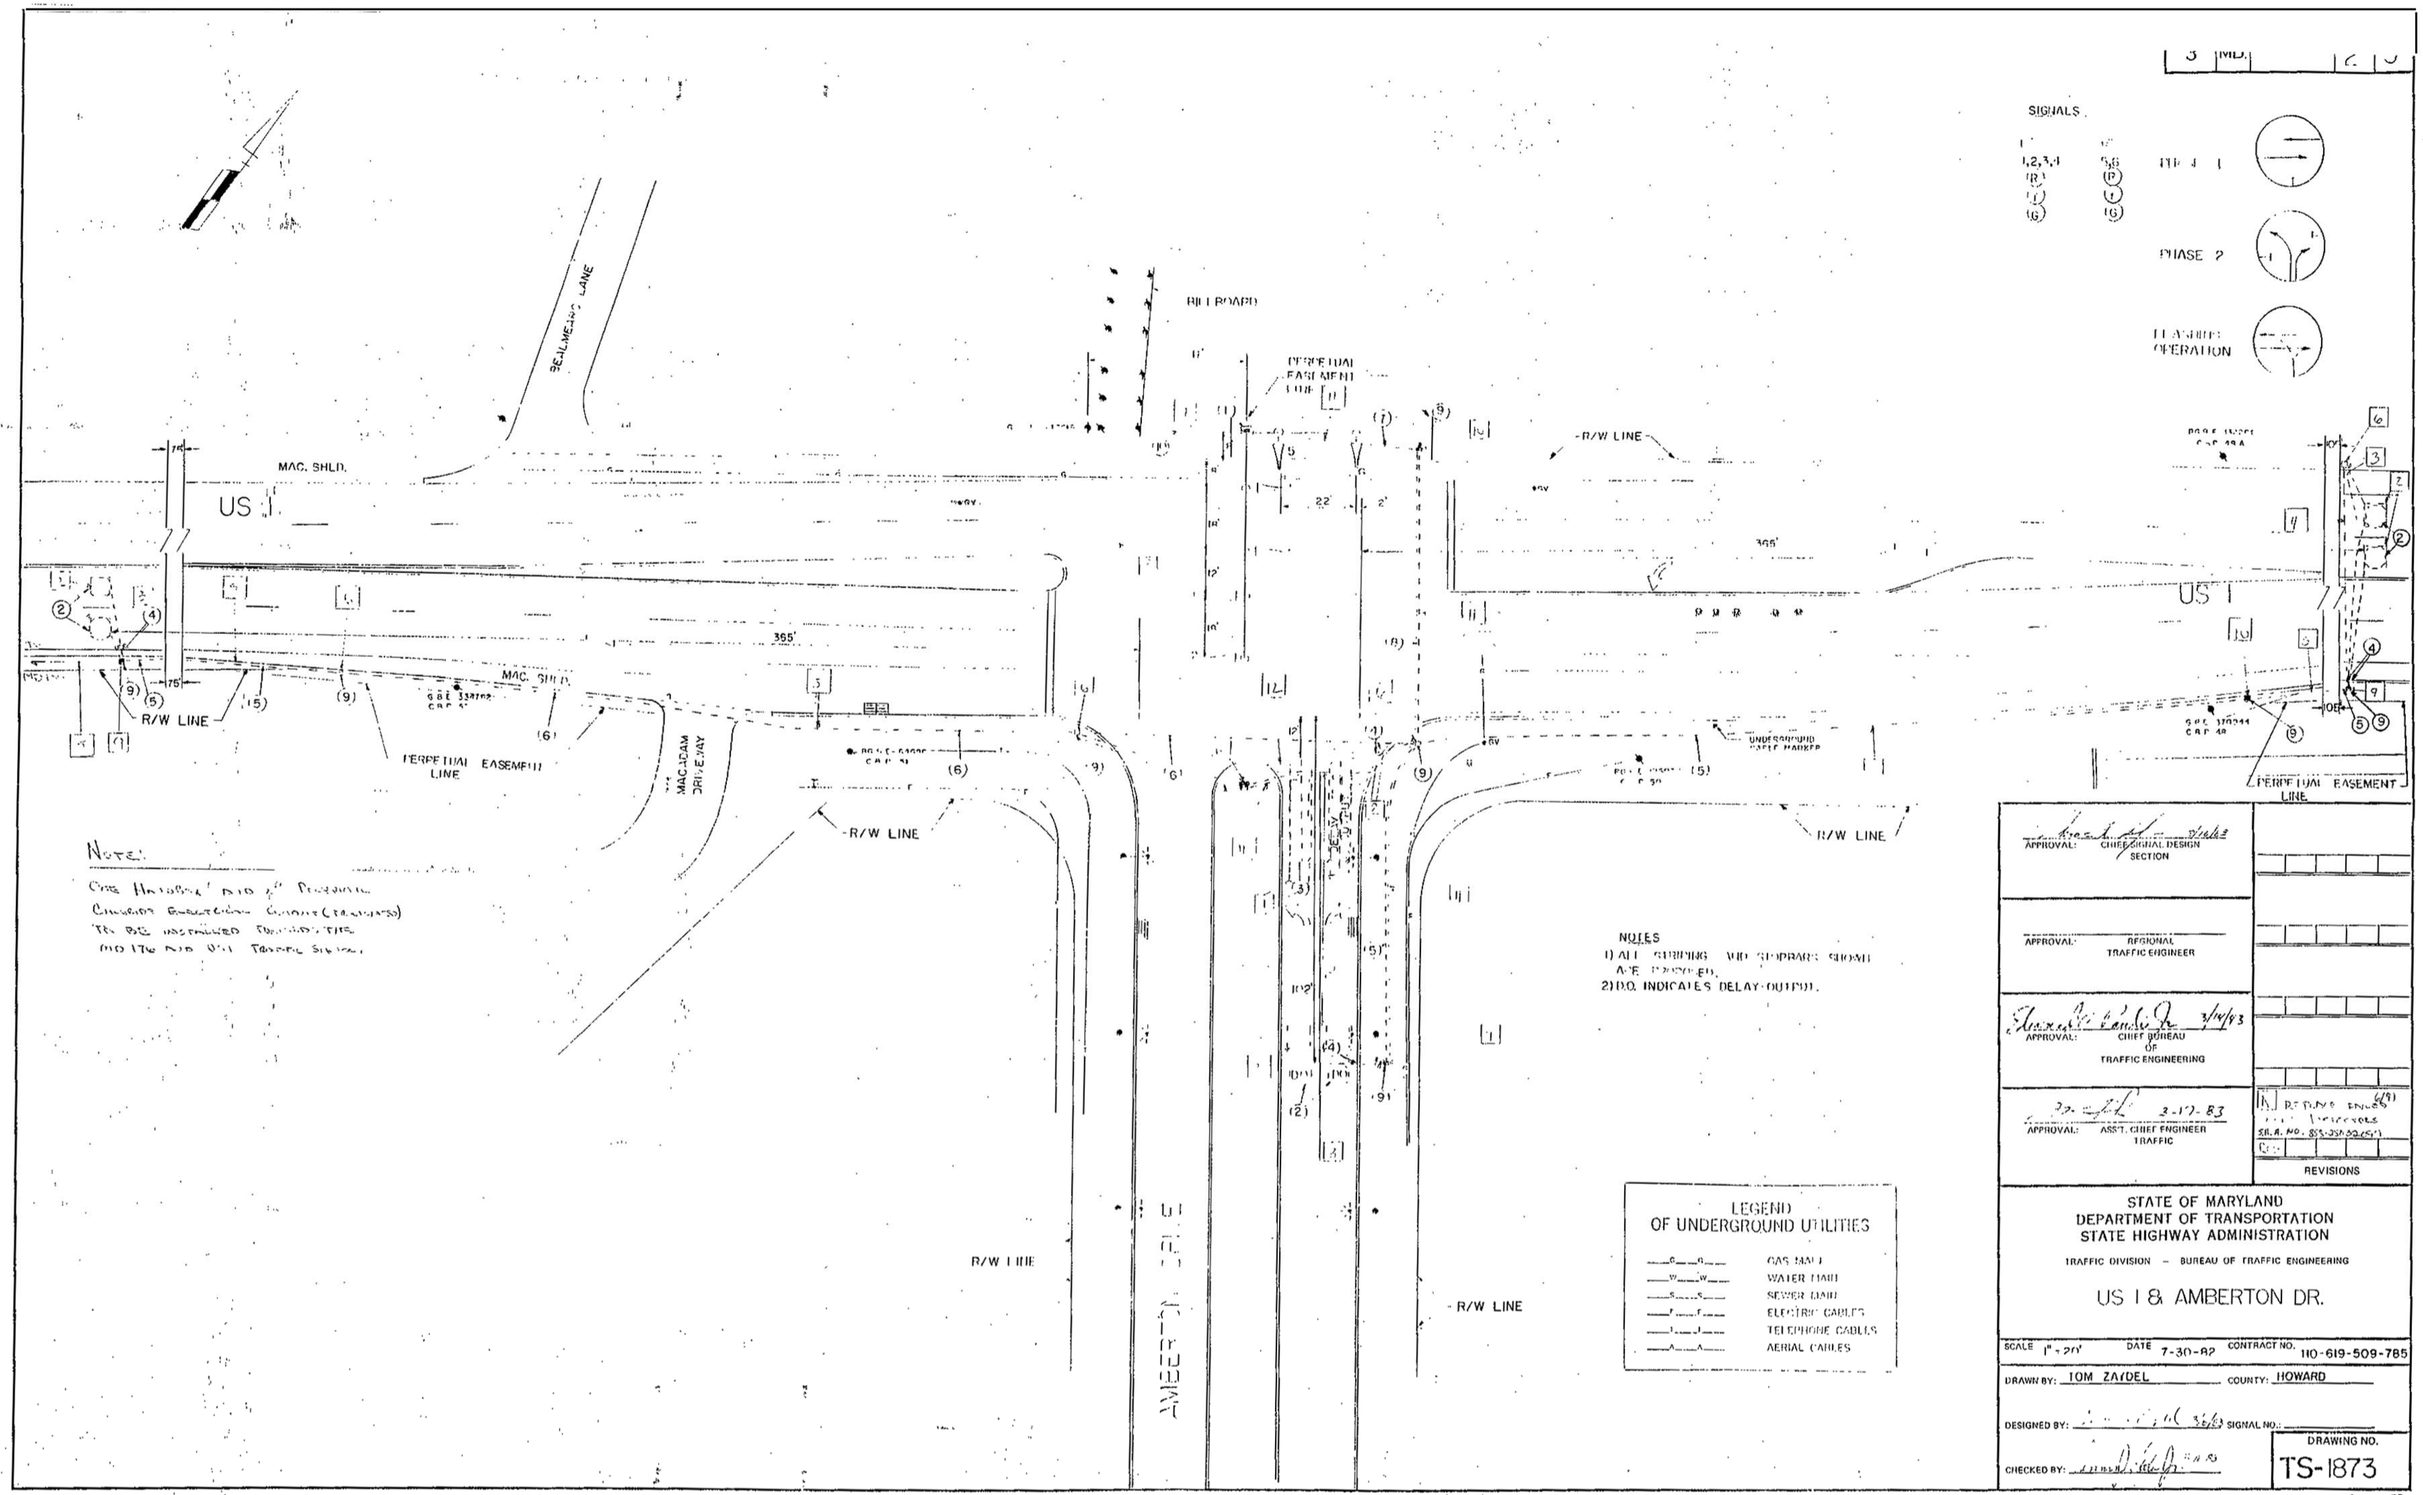
SIGNALS
PHASE 1
PHASE 2
FLASHING OPERATION
BILLBOARD
PERPETUAL EASEMENT LINE
R/W LINE
MAC. SHLD.
US 1
365'
PERPETUAL EASEMENT LINE
MACADAM DRIVEWAY
UNDERGROUND CABLE MARKER
AMBERTON DR.
NOTES
2) D.O. INDICATES DELAY-OUTPUT.
LEGEND OF UNDERGROUND UTILITIES
GAS MAIN
WATER MAIN
SEWER MAIN
ELECTRIC CABLES
TELEPHONE CABLES
AERIAL CABLES
APPROVAL: REGIONAL TRAFFIC ENGINEER
APPROVAL: CHIEF BUREAU OF TRAFFIC ENGINEERING
3/14/83
APPROVAL: ASST. CHIEF ENGINEER TRAFFIC
3-17-83
REVISIONS
STATE OF MARYLAND
DEPARTMENT OF TRANSPORTATION
STATE HIGHWAY ADMINISTRATION
TRAFFIC DIVISION – BUREAU OF TRAFFIC ENGINEERING
US 1 & AMBERTON DR.
SCALE 1" = 20'
DATE 7-30-82
CONTRACT NO. 110-619-509-785
DRAWN BY: TOM ZARDEL
COUNTY: HOWARD
DESIGNED BY:
SIGNAL NO.:
CHECKED BY:
DRAWING NO.
TS-1873

