F.H.W.A. REGION NO.	STATE	FED. AID PROJ. NO.	SHEET NO.	TOTAL SHEETS
3	MD.	HES-251-1(14)	12	25

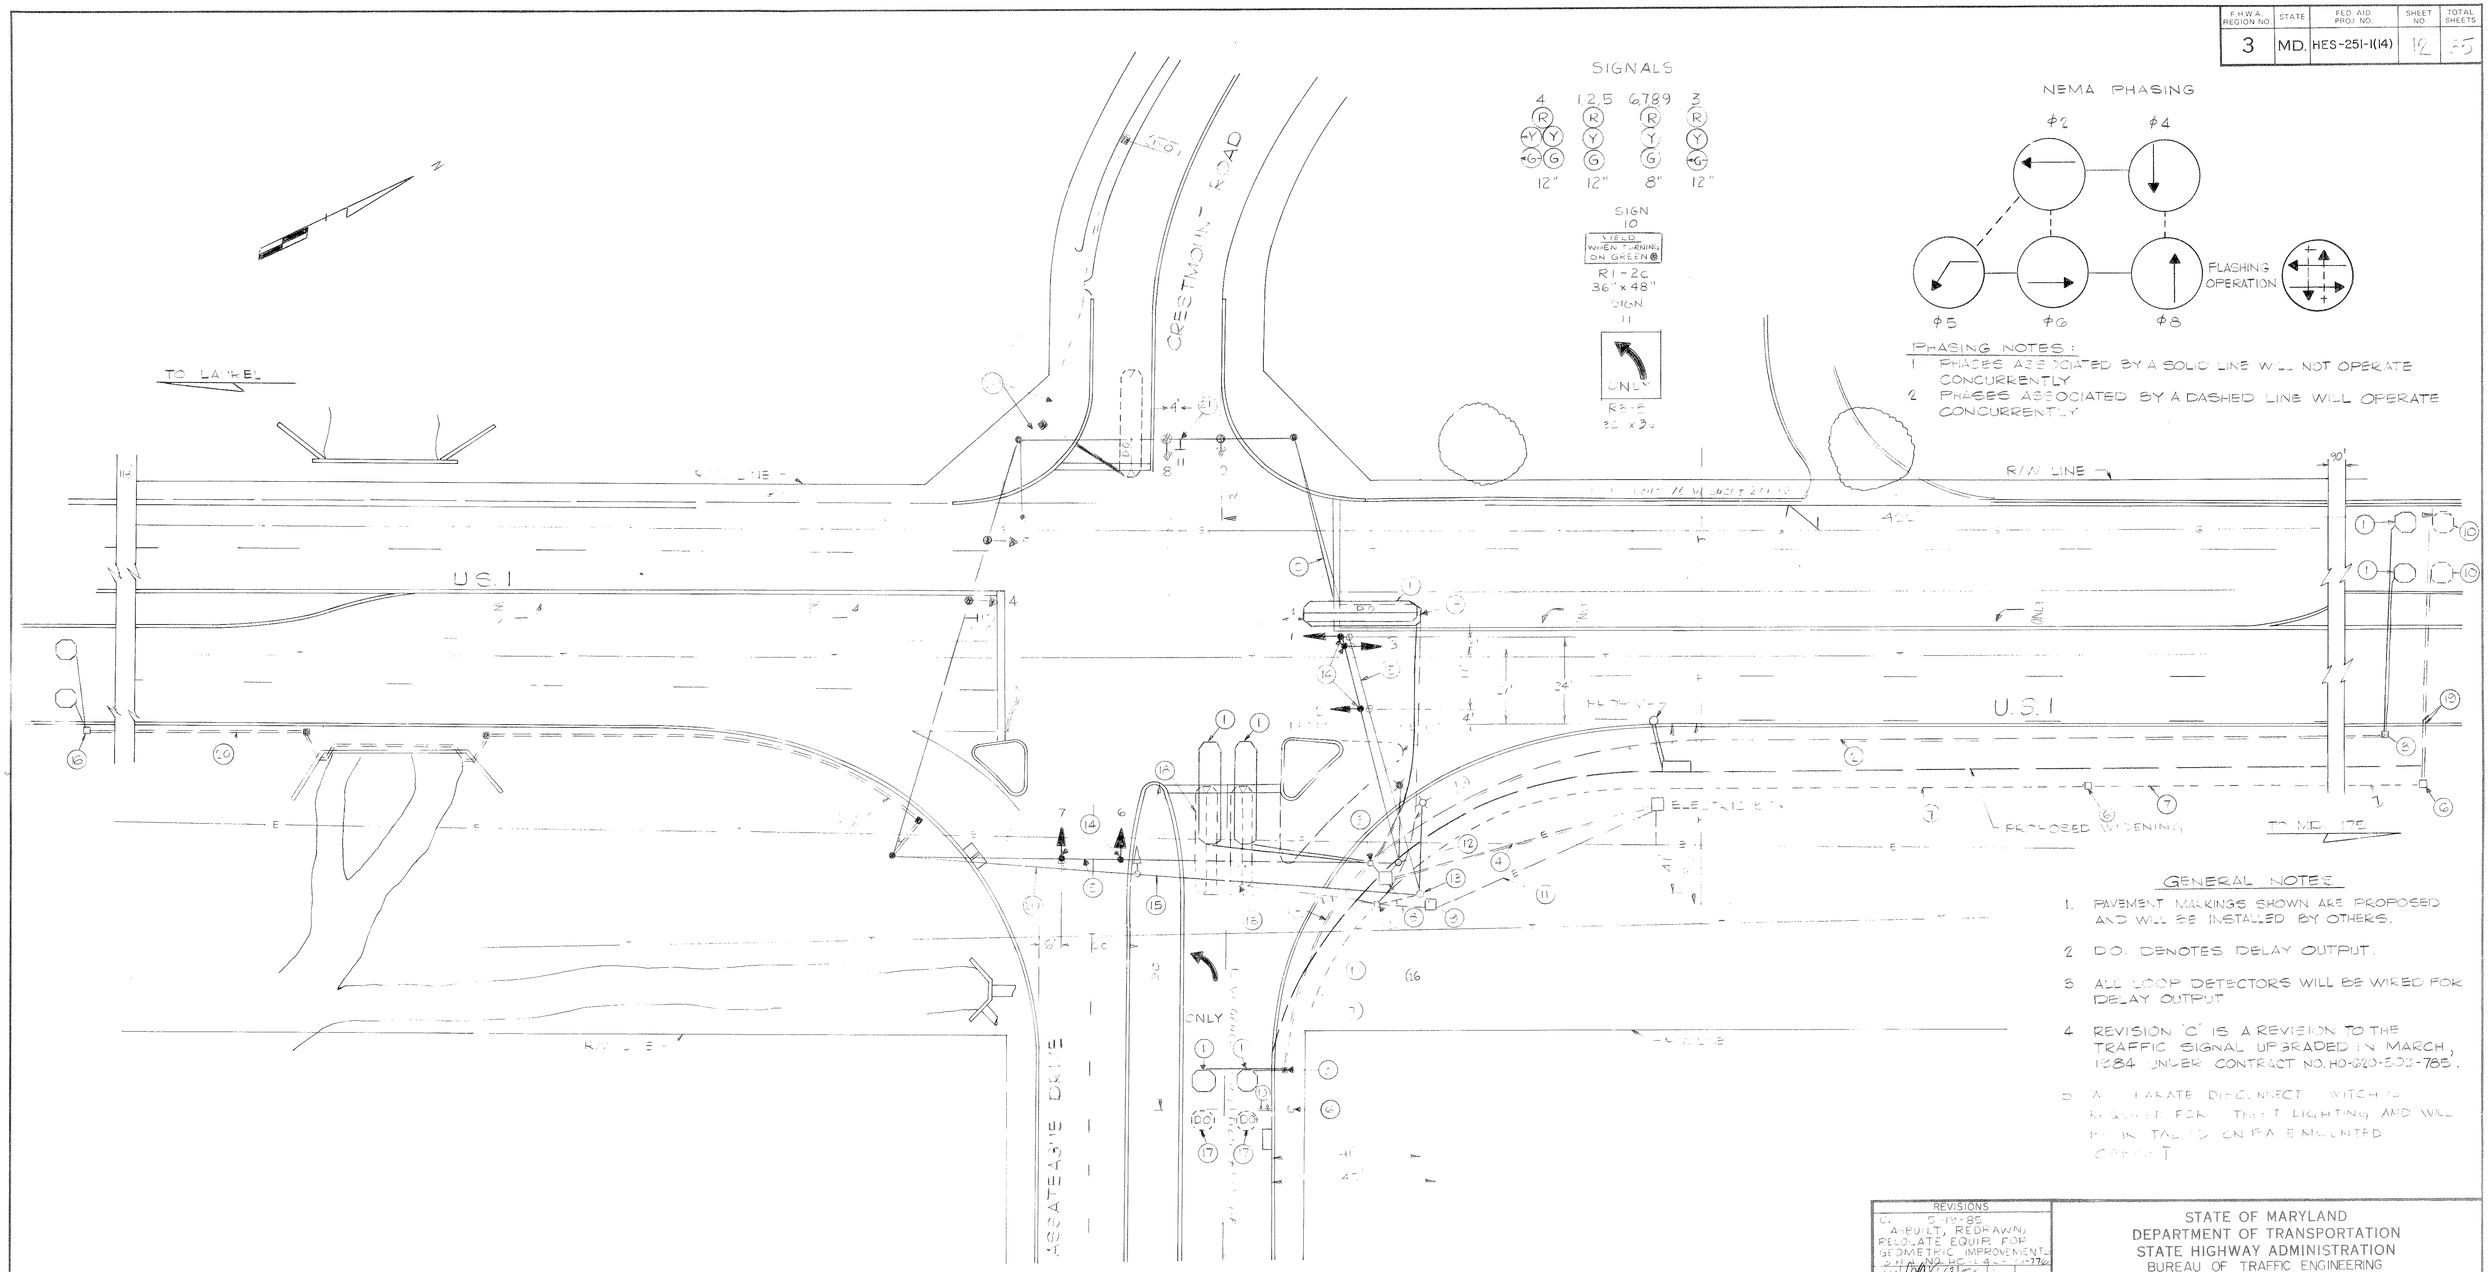

STATE OF MARYLAND
DEPARTMENT OF TRANSPORTATION
STATE HIGHWAY ADMINISTRATION
BUREAU OF TRAFFIC ENGINEERING
OFFICE OF TRAFFIC

U.S. 1 & ASSATEAGUE DRIVE / CRESMOUNT ROAD SIGNAL CONSTRUCTION PLAN

SCALE 1"=20' DATE 9-9-85 CONTRACT NO. HO-455-X-785

DRAWN BY: L. LODA COUNTY: HOWARD

DESIGNED BY: D. RODA SIGNAL NO. 13117

CHECKED BY: WILLIAM F. FITCH 7-26-78

DRAWING NO. TS-913C

13000105.37