| FHWA REGION NO. | STATE | FED. AID PROJ. NO. | SHEET NO. | TOTAL SHEETS |
|---|---|---|---|---|
| 3 | MD | | | |

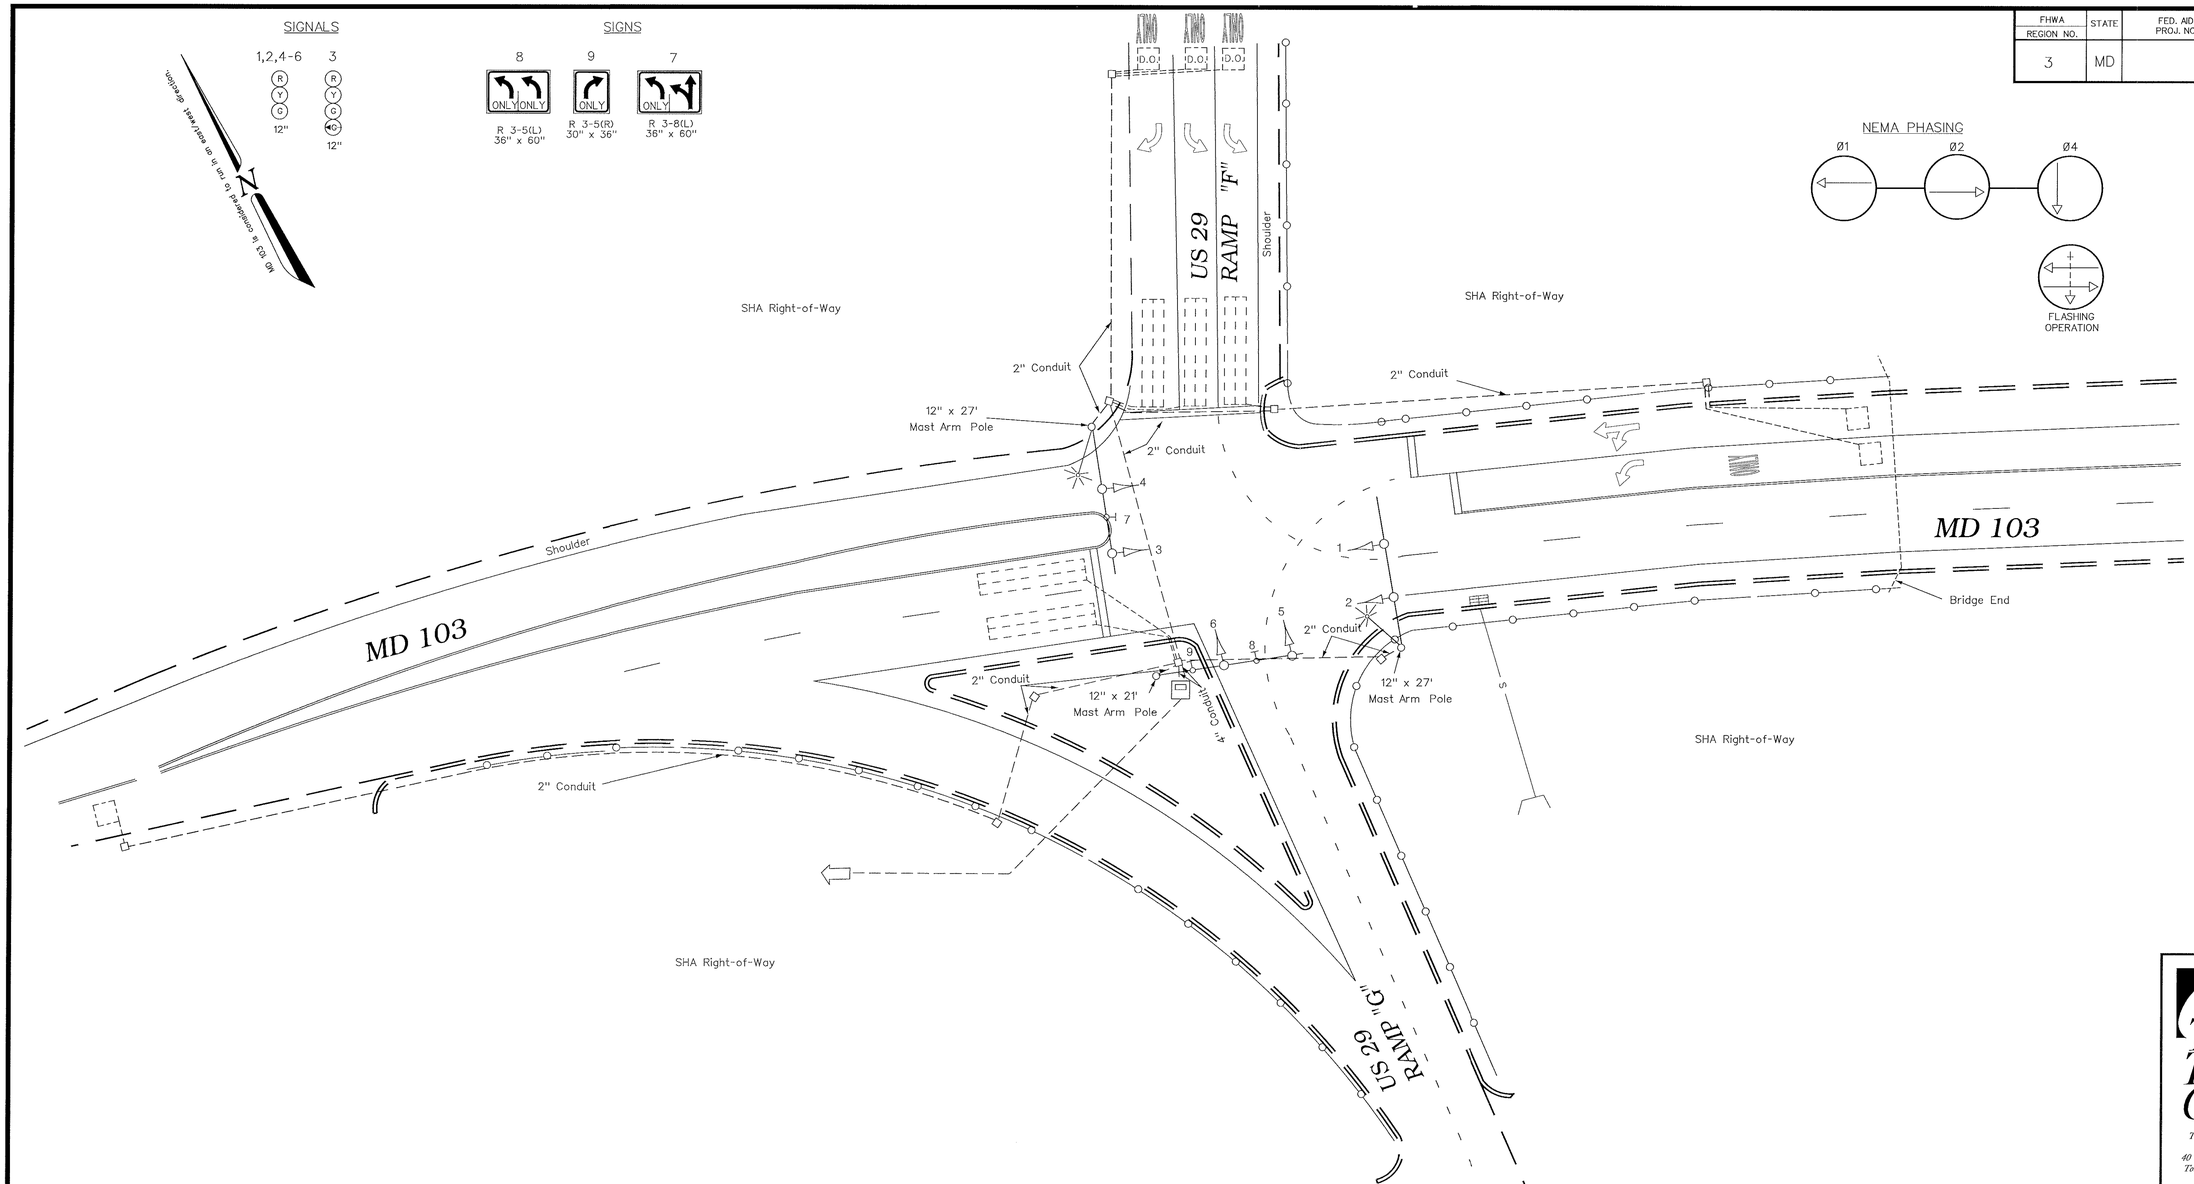


As-Built"

The Traffic Group

The Traffic Group, Inc.
Suite 600
40 W. Chesapeake Avenue
Towson, Maryland 21204
410-583-8405
1-800-583-8411
Fax 410-321-8458
Job. No.960424

GEOMETRIC LEGEND

EXISTING GEOMETRICS
PROPOSED GEOMETRICS

UTILITY LEGEND

| | |
|---|---|
| G | GAS MAIN |
| W | WATER MAIN |
| S | SEWER MAIN |
| E | ELECTRIC CABLES |
| D | STORM DRAIN |
| A | AERIAL CABLES |
| T | TELEPHONE CABLES |

REVISIONS

(B) As-Built May 17, 1996
S.H.A. No.: AW-794-501-785
FJH

APPROVALS

ASST. DIVISION CHIEF TRAFFIC ENGINEERING DESIGN DIVISION
CHIEF, TRAFFIC ENGINEERING DESIGN DIVISION
ASST. DISTRICT ENGINEER - TRAFFIC
DIRECTOR, OFFICE OF TRAFFIC & SAFETY

ORIGINAL ON FILE

MDOT – STATE HIGHWAY ADMINISTRATION
*Office of Traffic & Safety*
TRAFFIC ENGINEERING DESIGN DIVISION

DRAWN BY: D.A. Nies
DES. BY: R.R. Zacherl
CHK. BY:

(Traffic Signal Plan)

*MD 103 at US 29 Ramp "F"*

COUNTY: HOWARD
LOG MILE • 18002910.26

DATE: 8-8-88
SCALE: 1" = 20'
F.A.P. NO. N/A
S.H.A. NO. HO-629-501-770
TS/STD. NO. 2502B-P
SHEET NO. 1 of 1