| F H WA REGION NO | STATE | FED. AID PROJ. NO | SHEET NO. | TOTAL SHEETS |
|---|---|---|---|---|
| 3 | MD. | | | |

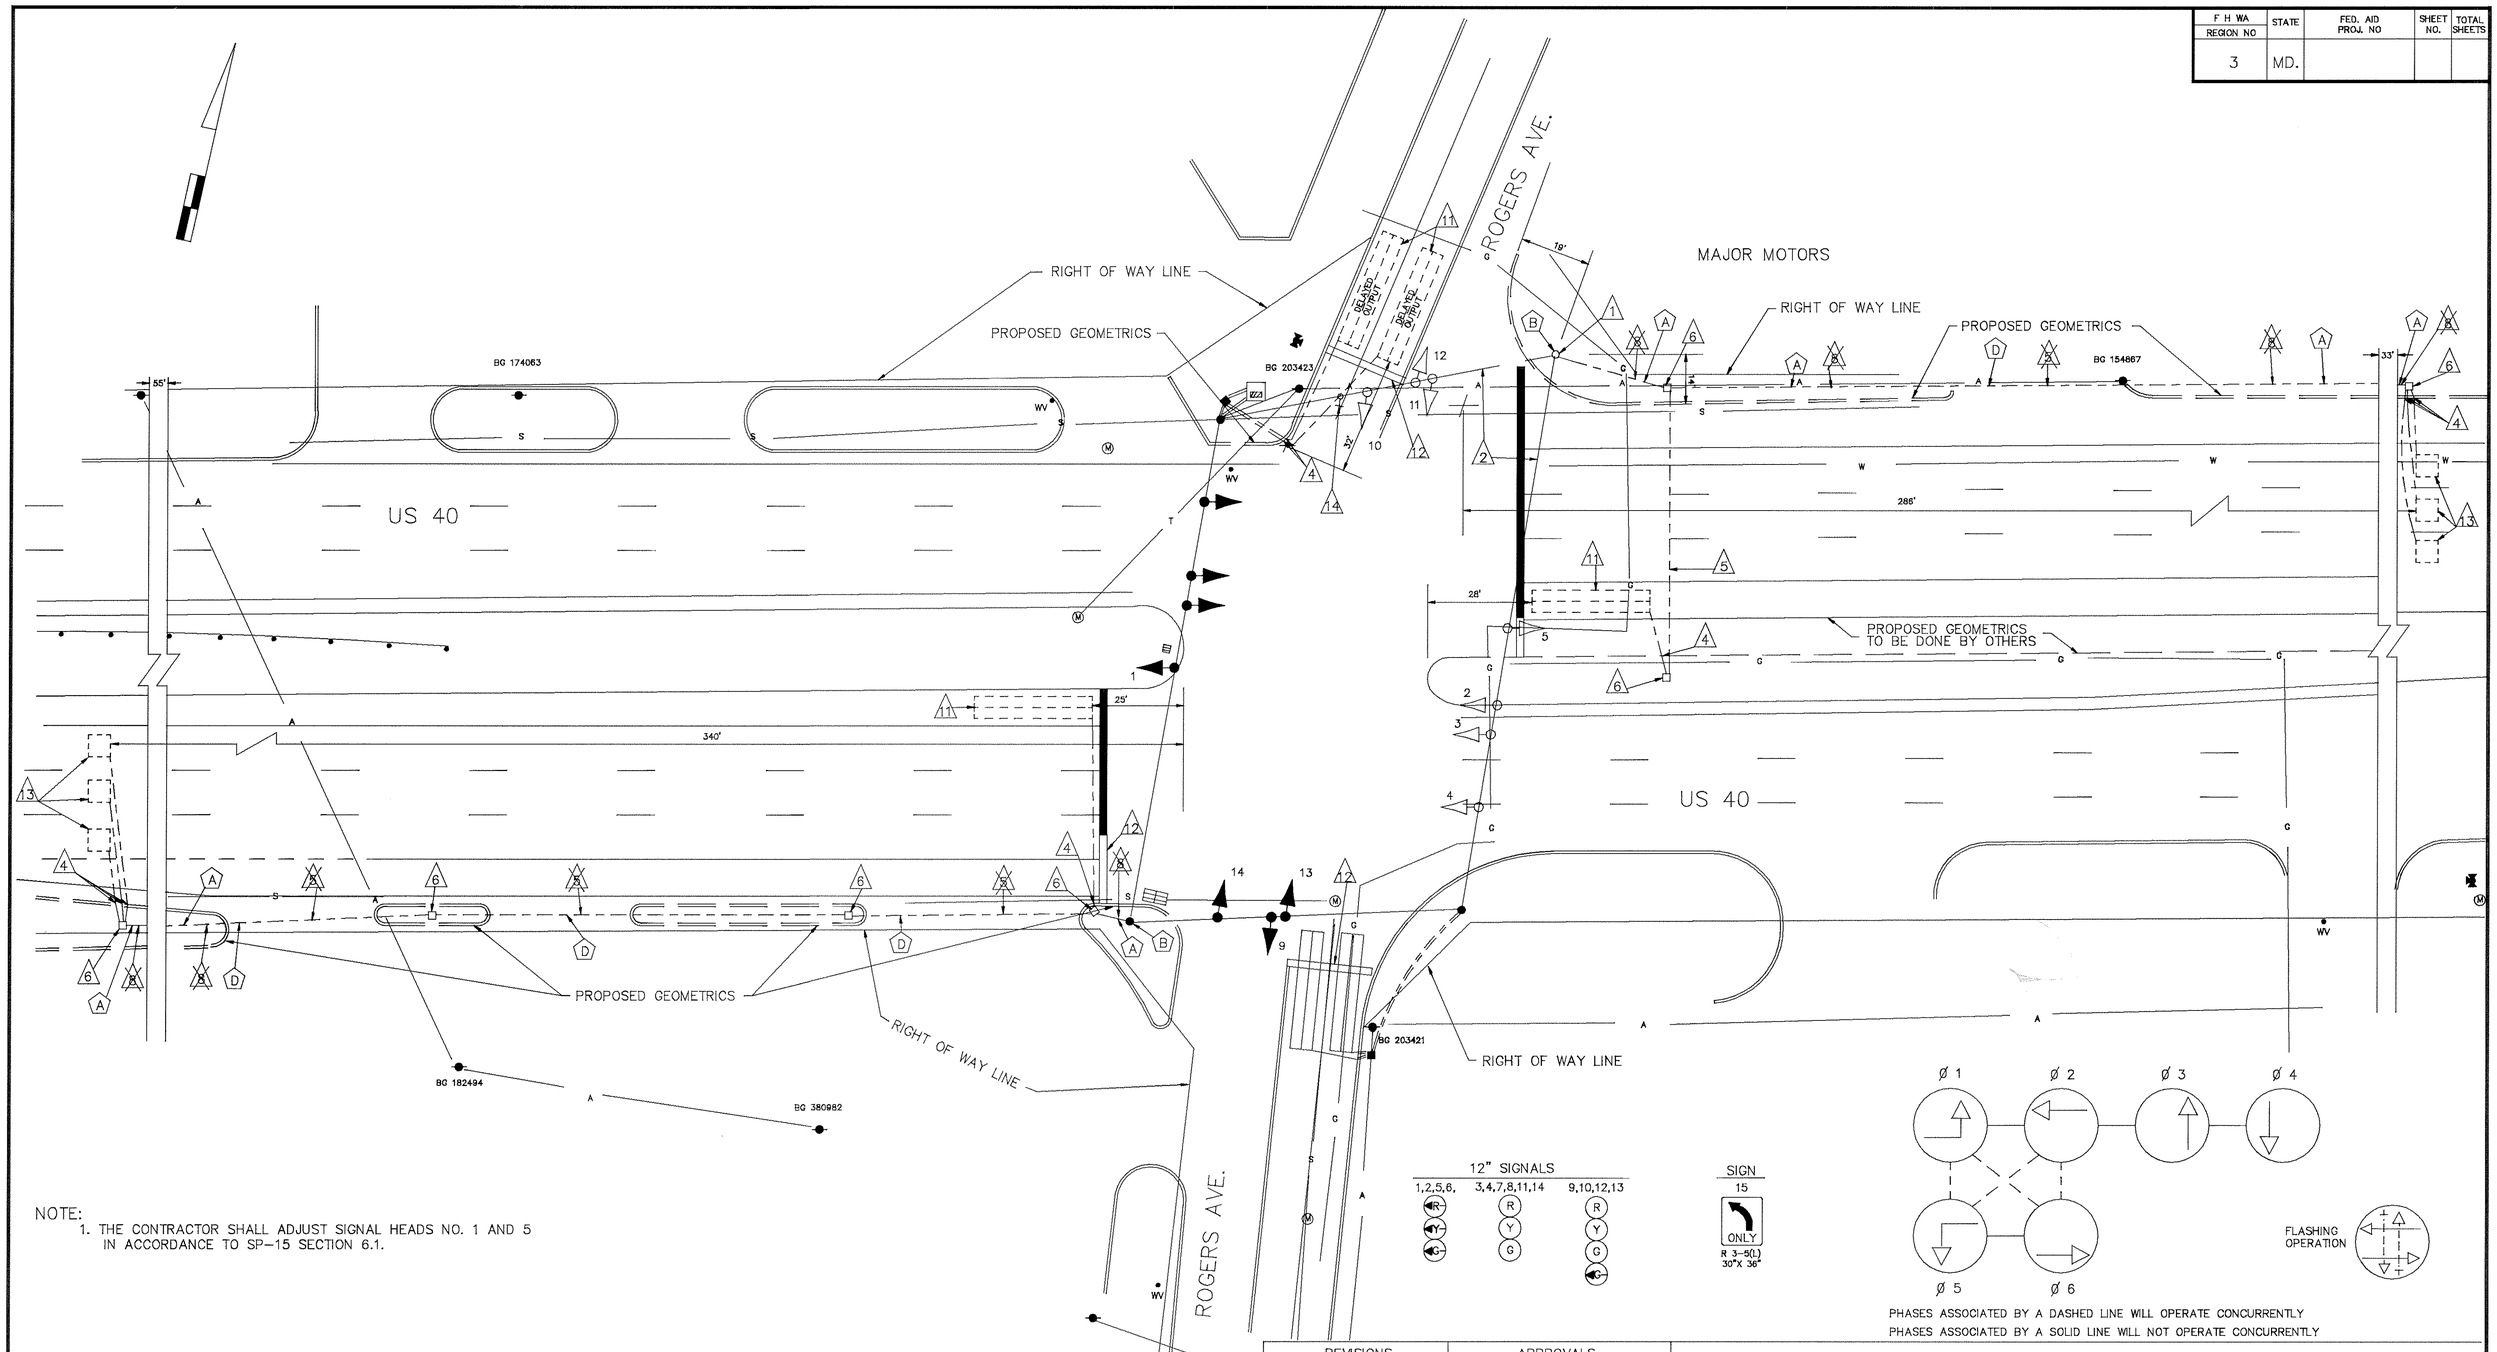


NOTE:
1. THE CONTRACTOR SHALL ADJUST SIGNAL HEADS NO. 1 AND 5 IN ACCORDANCE TO SP-15 SECTION 6.1.

PHASES ASSOCIATED BY A DASHED LINE WILL OPERATE CONCURRENTLY
PHASES ASSOCIATED BY A SOLID LINE WILL NOT OPERATE CONCURRENTLY

## UTILITY LEGEND

| | |
|---|---|
| —— G —— G —— | GAS MAIN |
| —— W —— W —— | WATER MAIN |
| —— S —— S —— | SEWER MAIN |
| —— E —— E —— | ELECTRIC CABLES |
| —— A —— A —— | AERIAL CABLES |

| REVISIONS | APPROVALS |
|---|---|
| 8/90 REDESIGNED DUE TO GEOMETRIC IMPROVEMENTS. HO-680-501-776 | CHIEF, SIGNAL DESIGN SECTION |
| SR DAZ ETP TH | ASST. DISTRICT ENGINEER, TRAFFIC |
| 2/91 CHANGE PROPOSED CONDUIT FROM 2" TO 3". HO-680-8501-776 | CHIEF, TRAFFIC ENGINEERING DIVISION |
| B S.H.A. NO. 855-26000, 4-17-86 SPLIT SIDE PHASING FOR MD 99. | DEPUTY CHIEF ENGINEER, OFFICE OF TRAFFIC |
| ERS SR DAZ ETP TH | |
| A 8/77 REDRAWN TO SHOW PROPOSED DESIGN AND INTERCONNECT. | |
| JG | |

THE ORIGINAL IS ON FILE. THIS IS A REVISION TO THE ORIGINAL S.H.A. CONTRACT NO. HO-505-501-785 1-17-78.

MARYLAND DEPARTMENT OF TRANSPORTATION
STATE HIGHWAY ADMINISTRATION – OFFICE OF TRAFFIC
TRAFFIC ENGINEERING DIVISION

DRAWN BY BRUCE THOMPSON RG
DES. BY:
CHK. BY:

US 40 and ROGERS AVE.

13004018.95

COUNTY: HOWARD

DATE: REDRAWN 2-4-90
SCALE: 1"=20'
F.A.P. NO.
S.H.A. NO.
TS/FILE NO. 474 (E)
SHEET NO. ___ OF ___

13004018.95