K&E BALTIMORE 17 0153 PHOENIX 10-75 MC 4156

F.H.W.A. REGION NO.	STATE	FED. AID PROJ. NO.	SHEET NO.	TOTAL SHEETS
3	MD.			

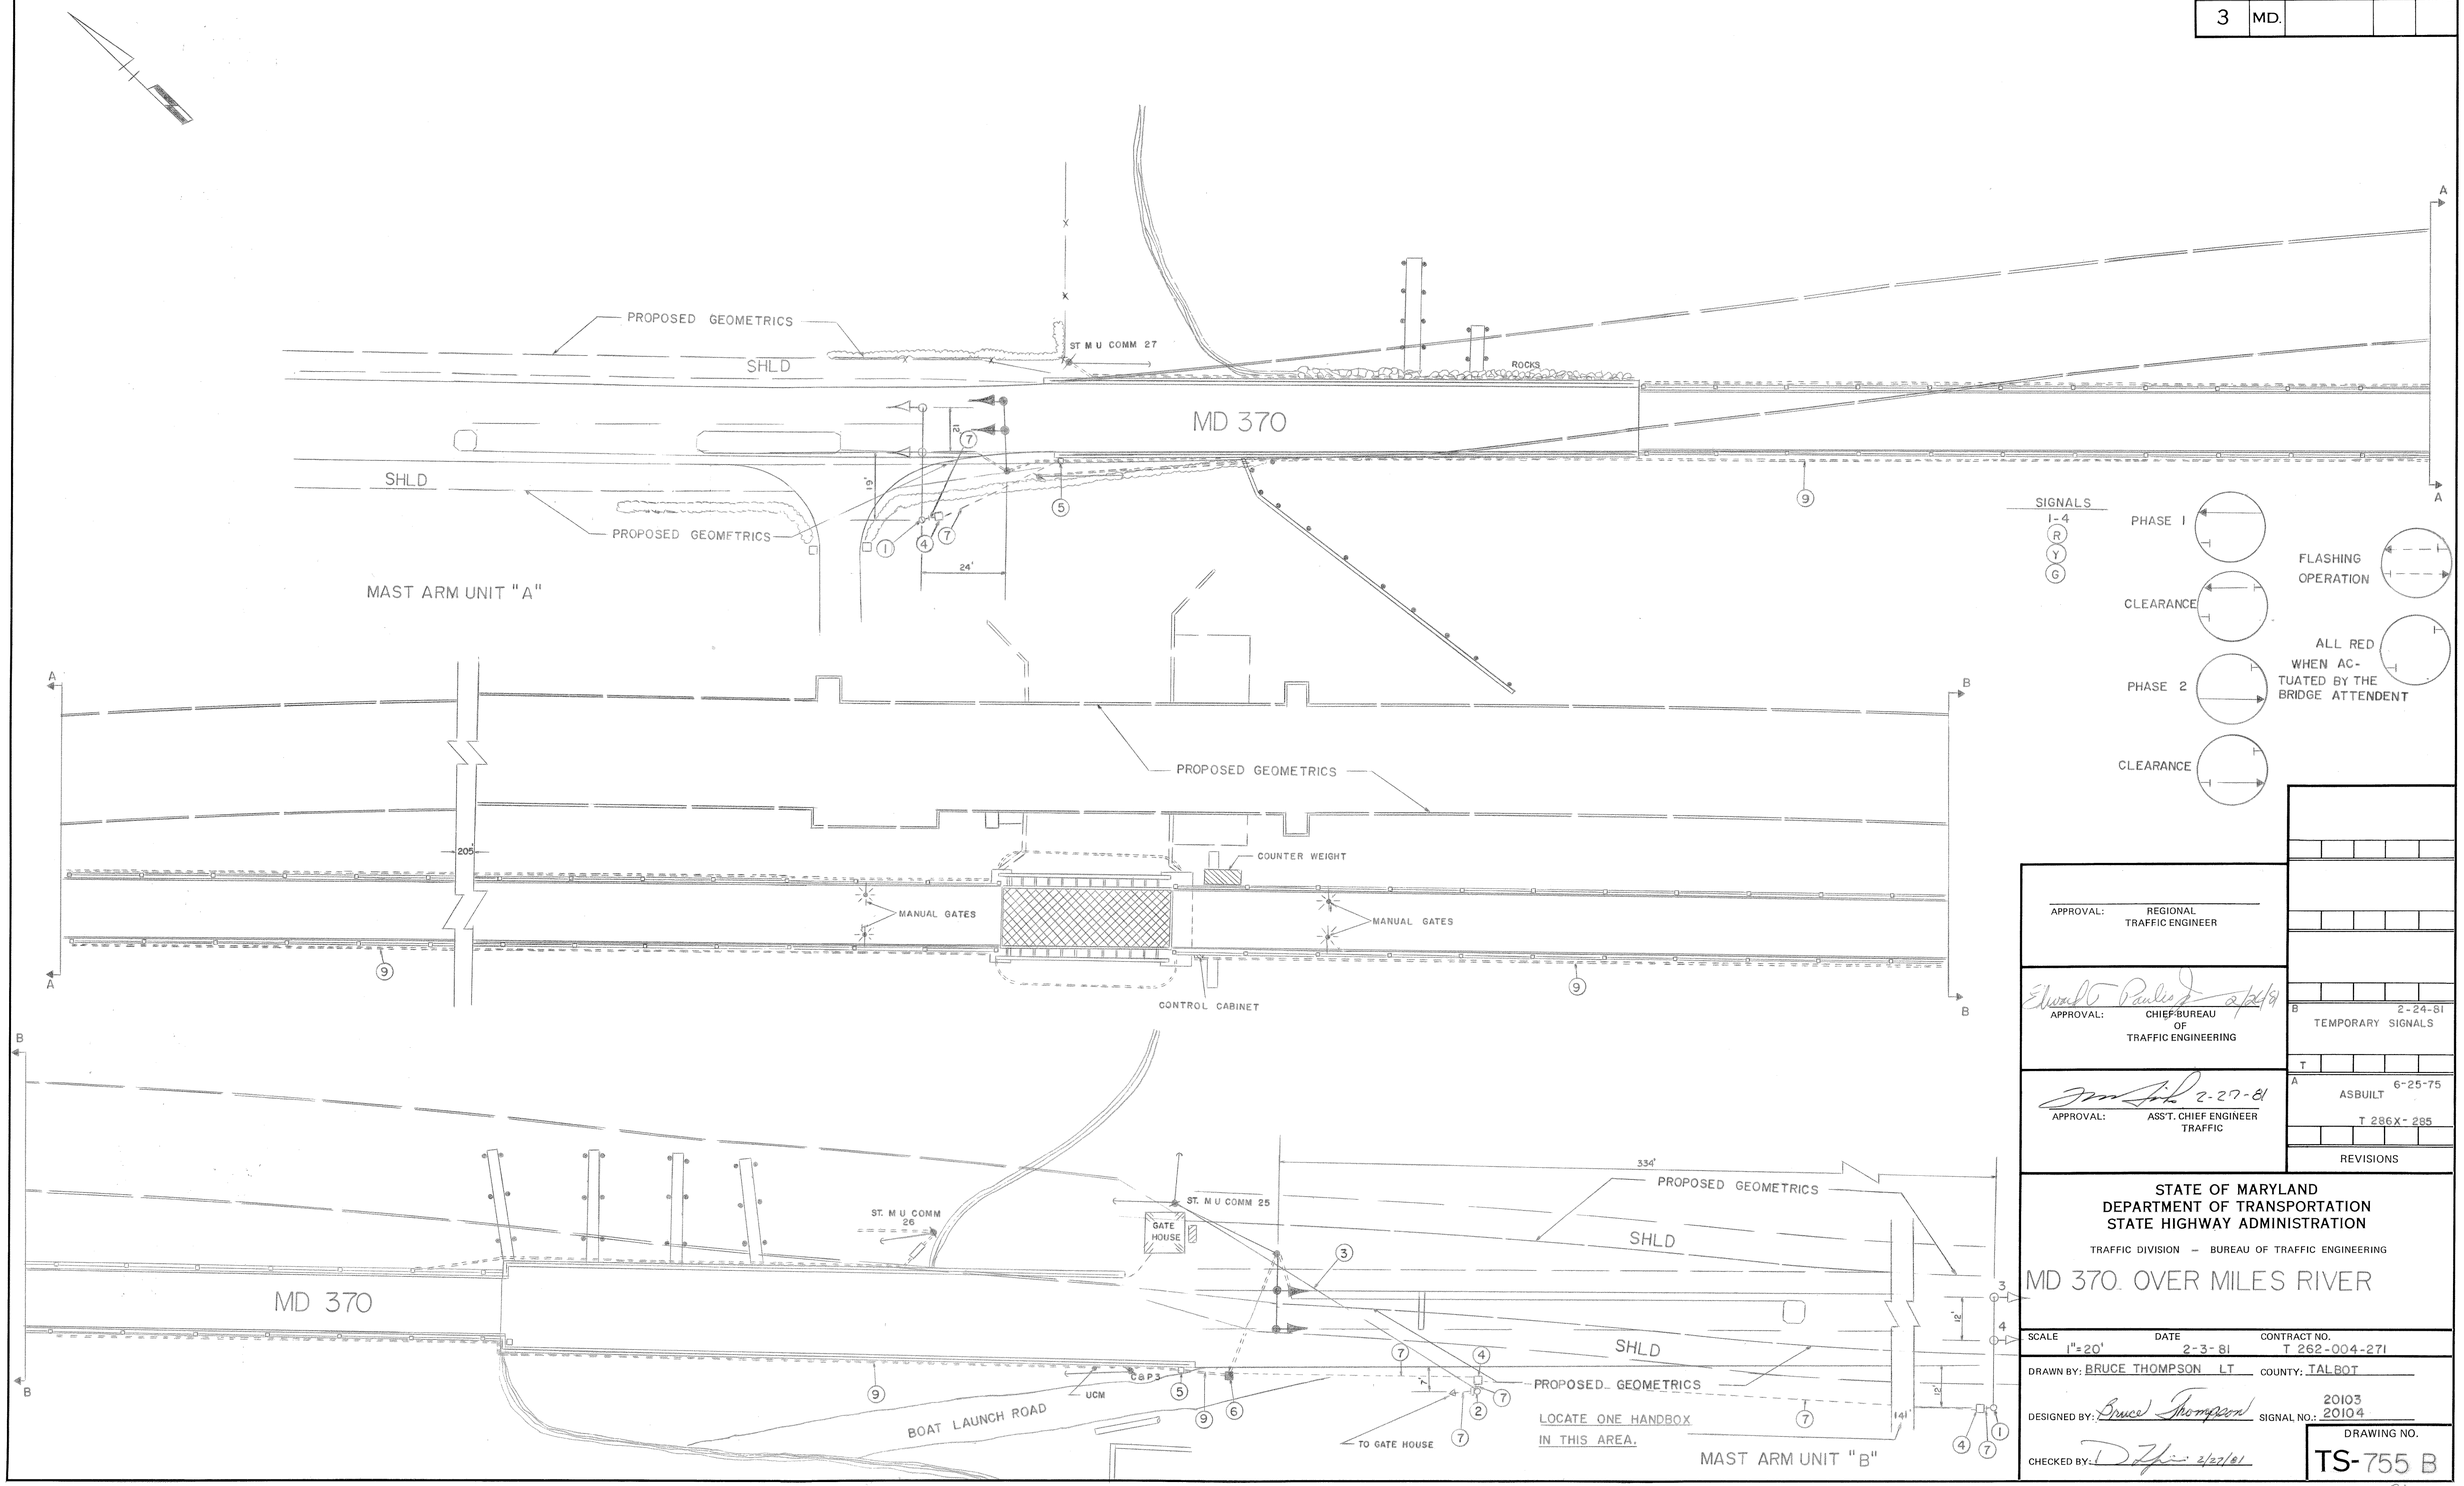

APPROVAL: REGIONAL TRAFFIC ENGINEER

APPROVAL: CHIEF BUREAU OF TRAFFIC ENGINEERING — 2/26/81

APPROVAL: ASS'T. CHIEF ENGINEER TRAFFIC — 2-27-81

B	2-24-81	TEMPORARY SIGNALS
T		
A	6-25-75	ASBUILT T 286X-285

REVISIONS

STATE OF MARYLAND
DEPARTMENT OF TRANSPORTATION
STATE HIGHWAY ADMINISTRATION

TRAFFIC DIVISION — BUREAU OF TRAFFIC ENGINEERING

MD 370. OVER MILES RIVER

SCALE	DATE	CONTRACT NO.
1"=20'	2-3-81	T 262-004-271

DRAWN BY: BRUCE THOMPSON LT COUNTY: TALBOT

DESIGNED BY: Bruce Thompson SIGNAL NO.: 20103 20104

CHECKED BY: D Zfin 2/27/81

DRAWING NO. TS-755 B