F.H.W.A. REGION NO.	STATE	FED. AID PROJ. NO.	SHEET NO.	TOTAL SHEETS
3	MD.		3	7

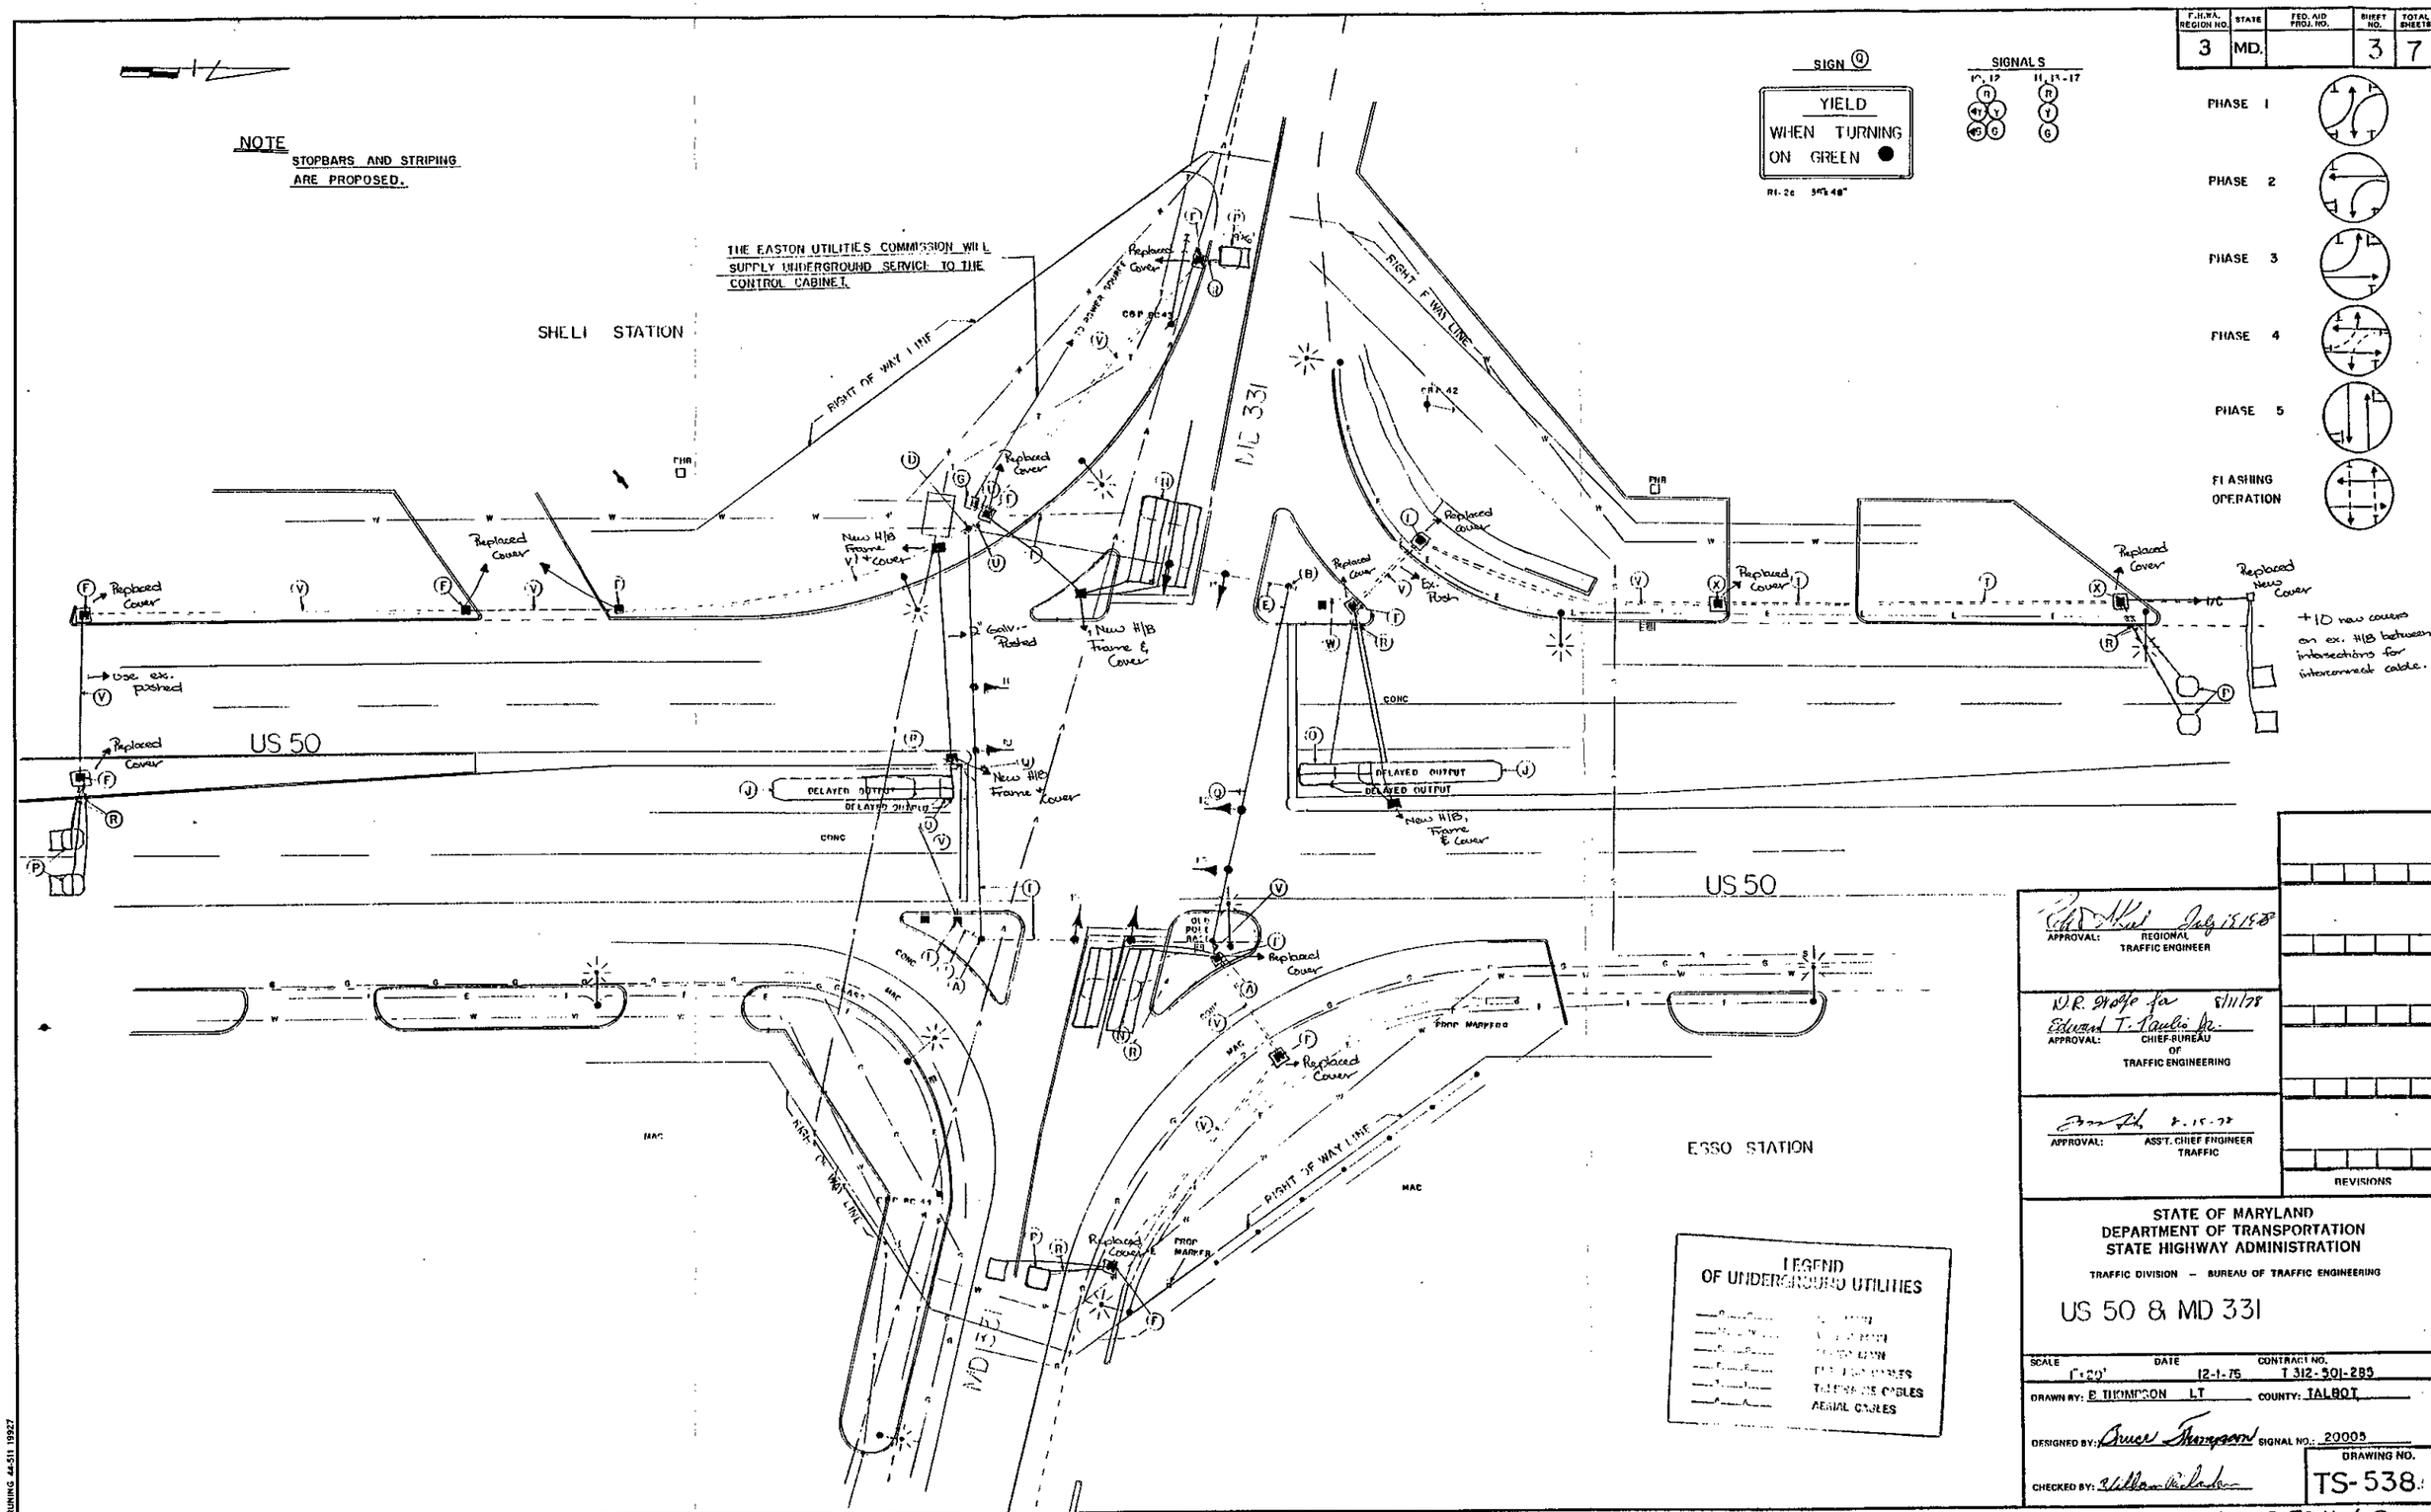

APPROVAL: REGIONAL TRAFFIC ENGINEER July 15 1978

APPROVAL: CHIEF-BUREAU OF TRAFFIC ENGINEERING 8/11/78

APPROVAL: ASS'T. CHIEF ENGINEER TRAFFIC 8-15-78

REVISIONS

STATE OF MARYLAND
DEPARTMENT OF TRANSPORTATION
STATE HIGHWAY ADMINISTRATION

TRAFFIC DIVISION – BUREAU OF TRAFFIC ENGINEERING

US 50 & MD 331

SCALE	DATE	CONTRACT NO.
1"=20'	12-1-75	T 312-501-285

DRAWN BY: B THOMPSON LT COUNTY: TALBOT

DESIGNED BY: Bruce Thompson SIGNAL NO.: 20005

CHECKED BY: William Nicholson

DRAWING NO. TS-538

20005011.60

BRUNING 44-511 19927