F.H.W.A. REGION NO.	STATE	FED. AID PROJ. NO.	SHEET NO.	TOTAL SHEETS
3	MD.			

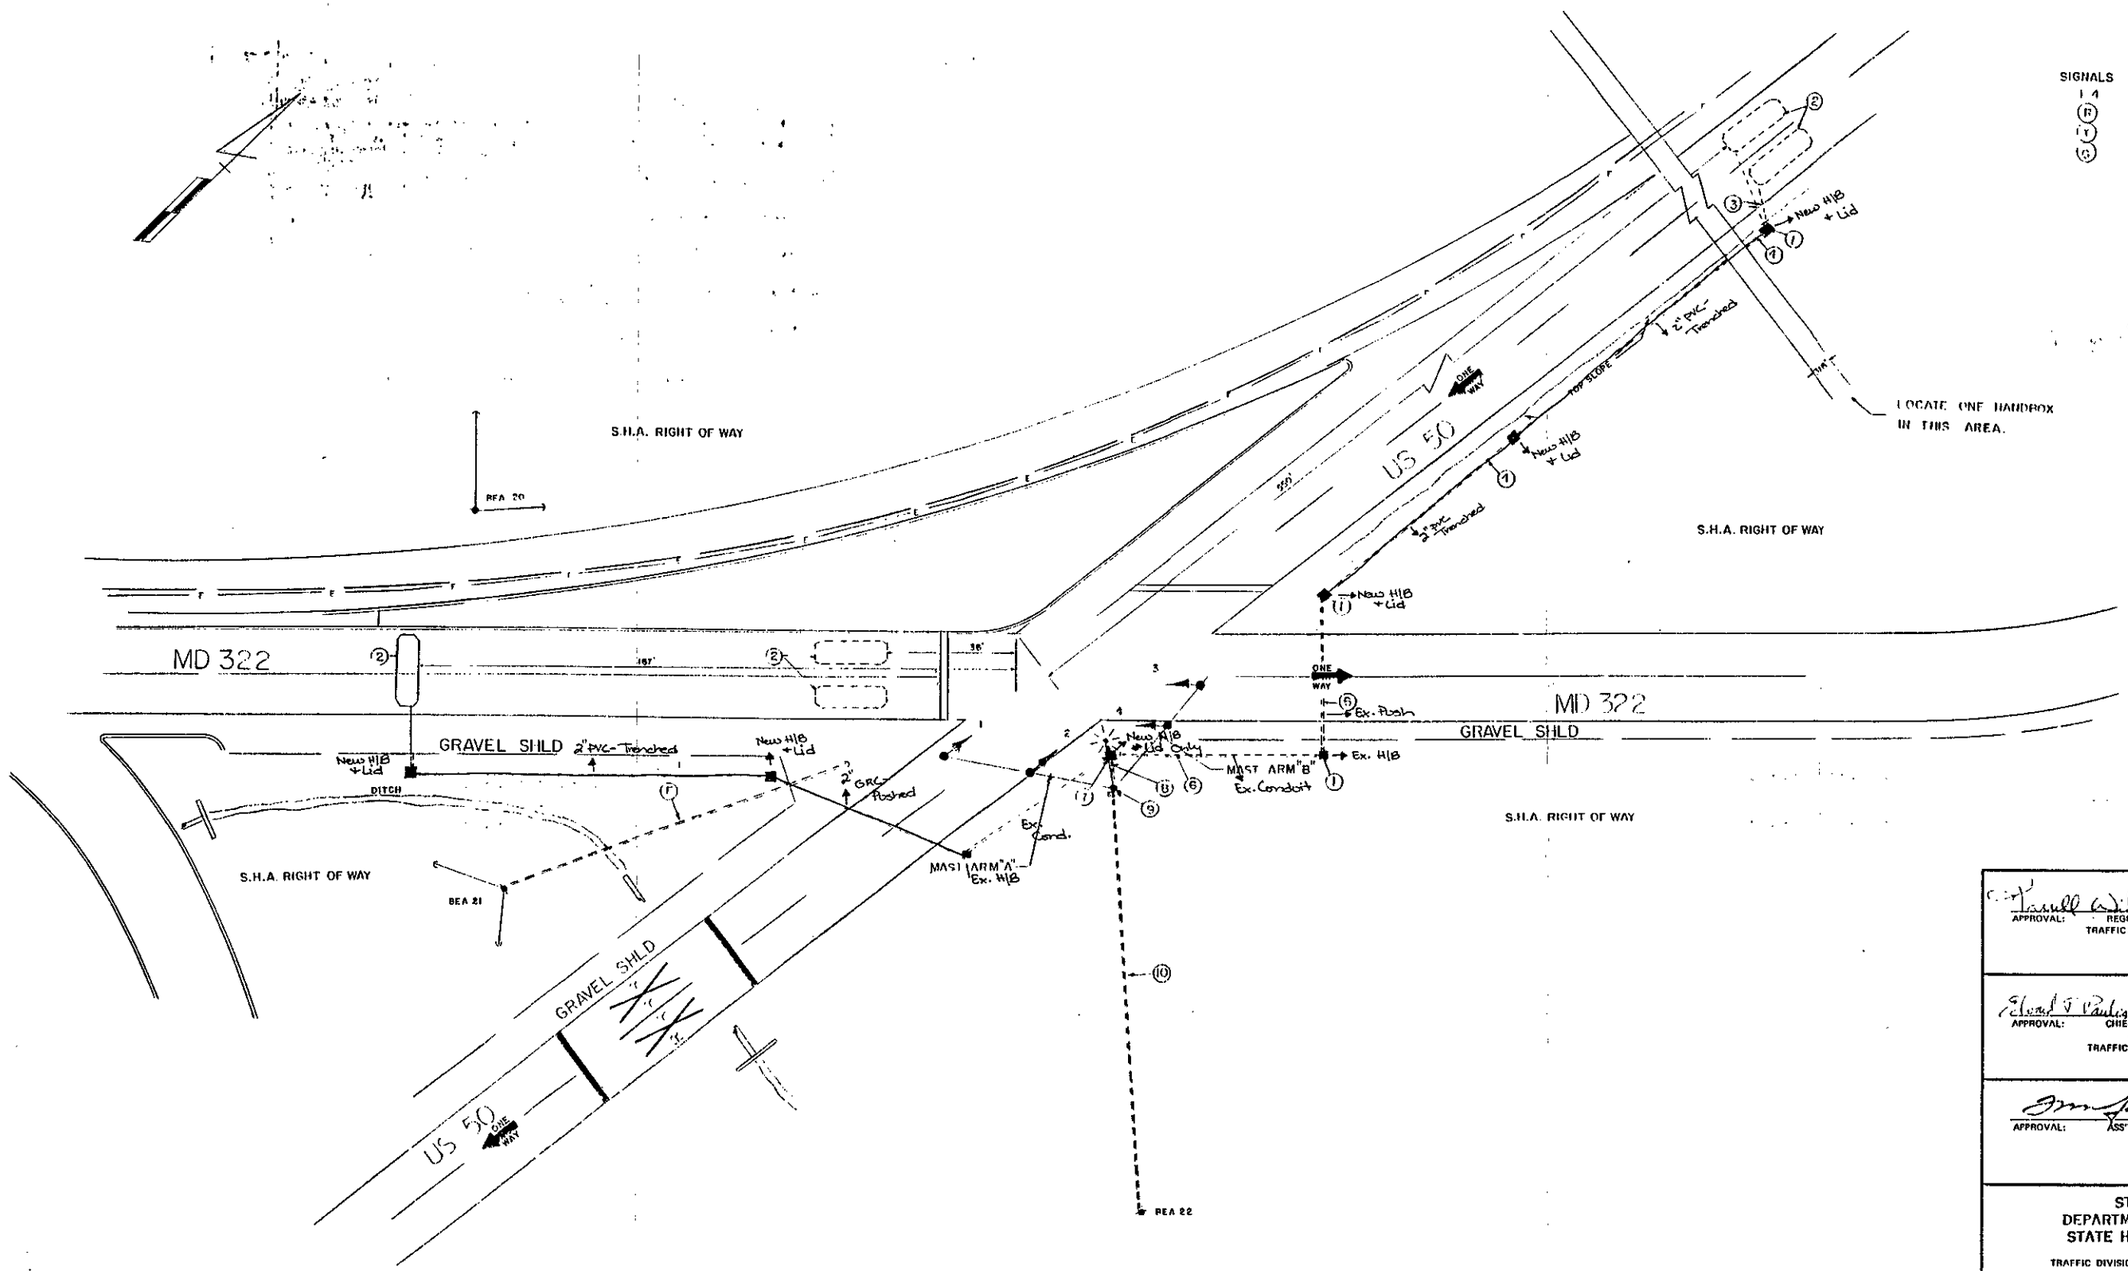

SIGNALS 1 4

PHASE 1

PHASE 2

FLASHING OPERATION

APPROVAL: REGIONAL TRAFFIC ENGINEER 7/21/74

APPROVAL: CHIEF BUREAU OF TRAFFIC ENGINEERING 7/21/74

APPROVAL: ASS'T. CHIEF ENGINEER TRAFFIC 7/24/74

B 10-26-77 AW 343-452-085 CHANGED FROM FLASHER TO FULLY ACTUATED.

A ASBUILT 10-26-76 T 290X-000-285

REVISIONS

STATE OF MARYLAND
DEPARTMENT OF TRANSPORTATION
STATE HIGHWAY ADMINISTRATION

TRAFFIC DIVISION – BUREAU OF TRAFFIC ENGINEERING

US 50 & MD 322 (FORMERLY MD 33)

SCALE	DATE	CONTRACT NO.
1" = 20'	3-1-74	AW 343-452-085

DRAWN BY: J GORDON COUNTY: TALBOT

DESIGNED BY: SIGNAL NO.:

CHECKED BY: 7-24-74

DRAWING NO. TS-557B

200050094

BRUNING 44-511 19927