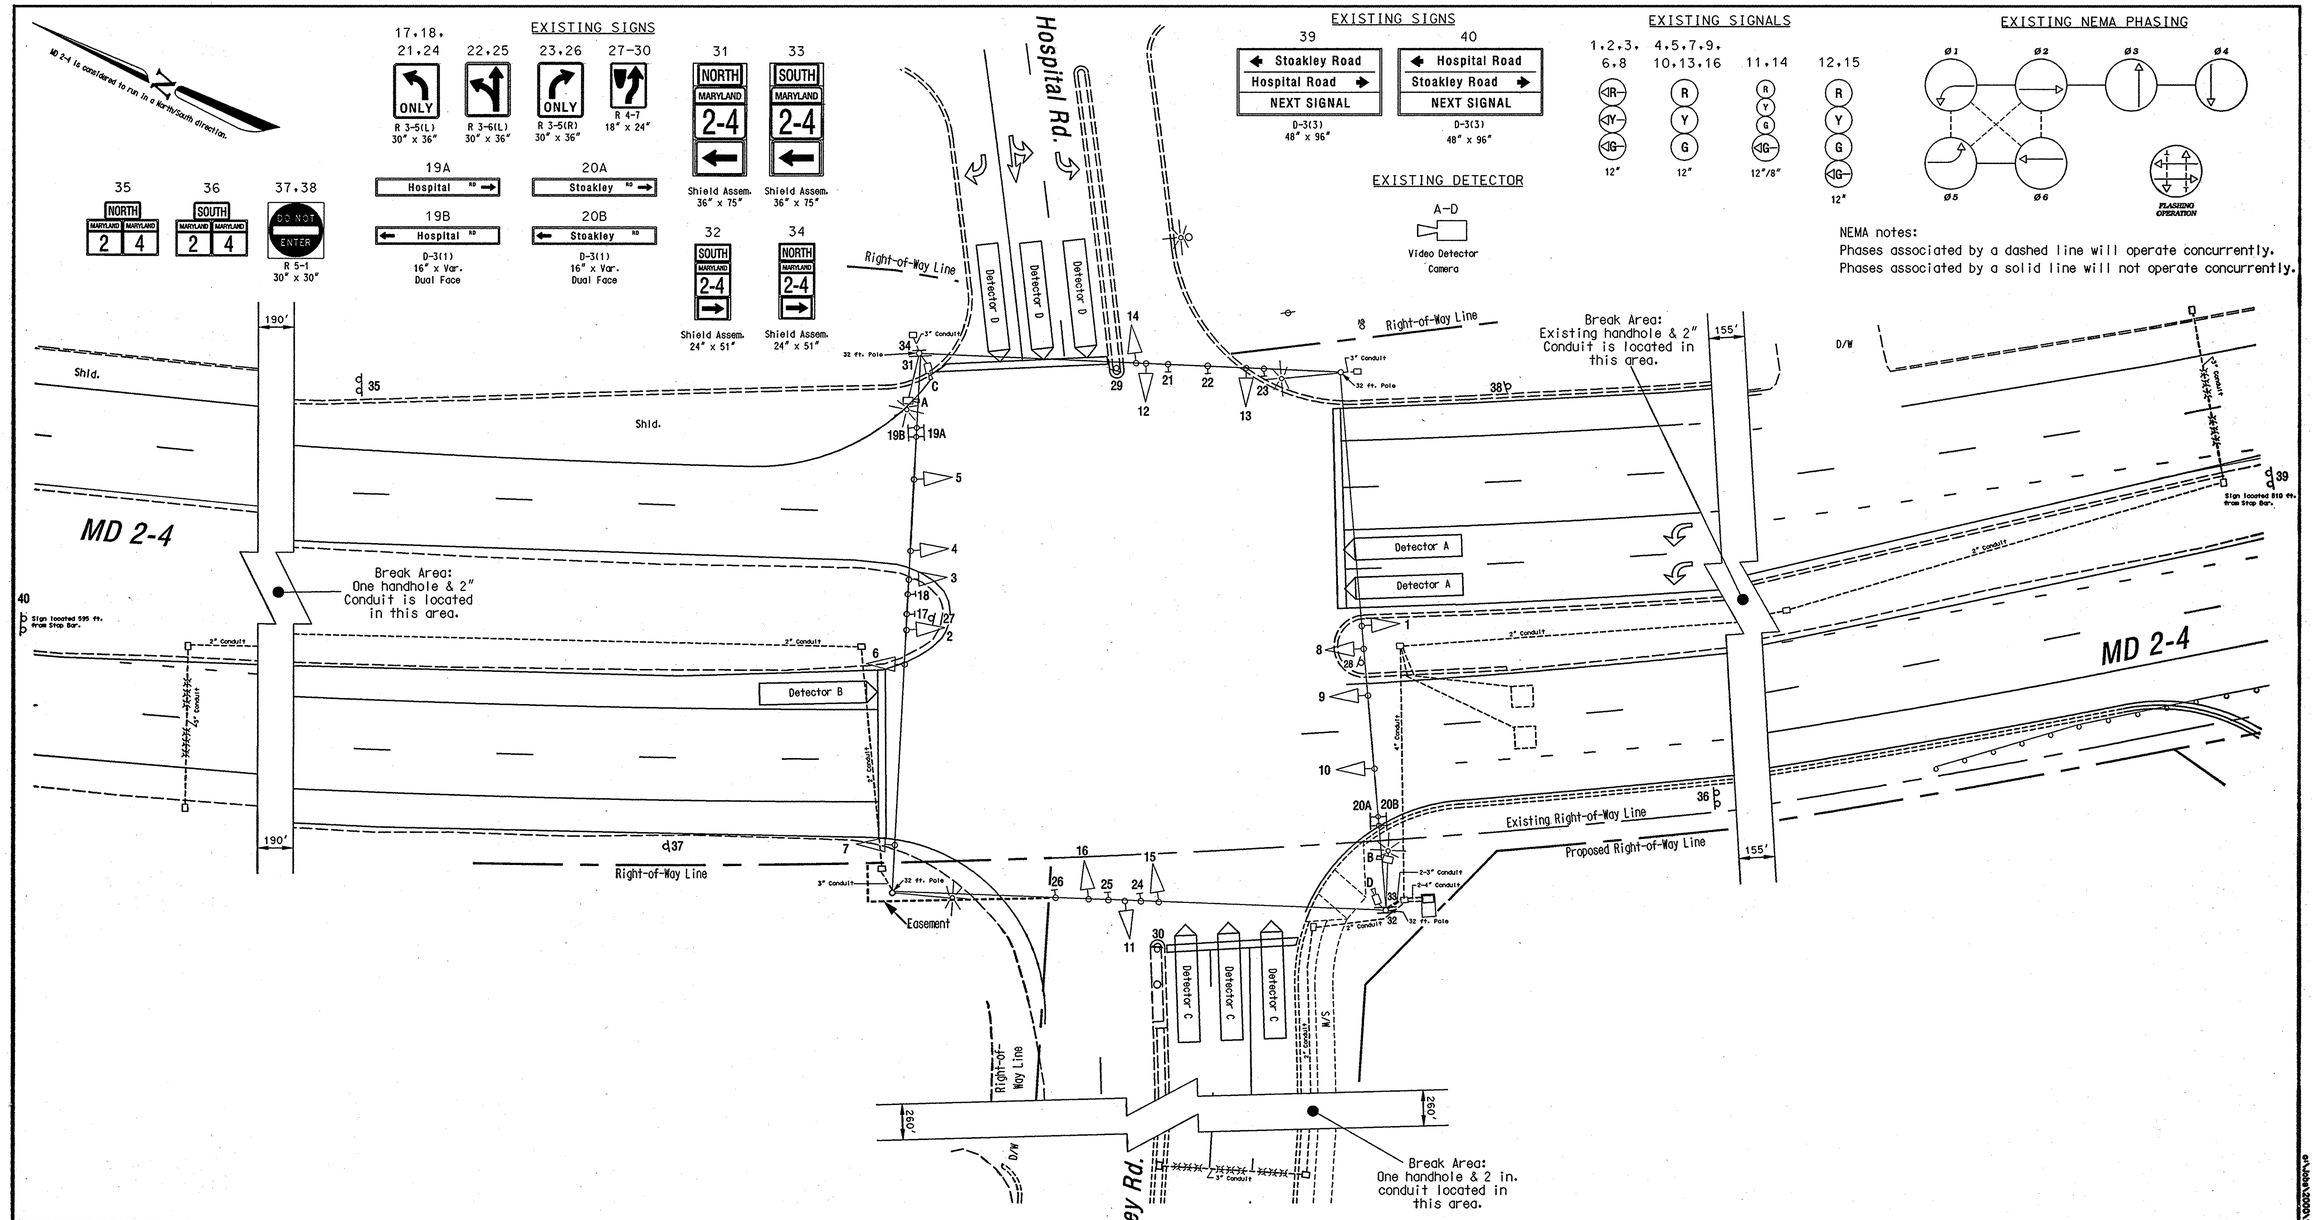

GEOMETRIC LEGEND

- EXISTING GEOMETRICS
- PROPOSED GEOMETRICS

UTILITY LEGEND

G	GAS MAIN
W	WATER MAIN
S	SEWER MAIN
E	ELECTRIC CABLES
D	STORM DRAIN
A	AERIAL CABLES
T	TELEPHONE CABLES

As-Built 01/06

The Traffic Group
The Traffic Group, Inc.
410-931-6600
Fax 410-931-6601

REVISIONS

As-Built		Jan. 10, 2006
HJK		
J	Rebuild traffic signal due to intersection improvements. S.H.A. No.:IM9596M2	April 9, 2004
JES		
H	Upgrade detection. S.H.A. No.:CA4865177	August, 2001
TMD	SWA	
G	Install exclusive NB and SB left turns on MD 2-4. S.H.A. No.:AW-104-501-585	April 7, 1996
WM	DJD DAZ BRK TH	

APPROVALS

TEAM LEADER, TRAFFIC ENGINEERING DESIGN DIVISION

ASST. CHIEF TRAFFIC ENGINEERING DESIGN DIVISION

CHIEF, TRAFFIC ENGINEERING DESIGN DIVISION

DIRECTOR, TRAFFIC & SAFETY

ORIGINAL ON FILE

MARYLAND DOT - STATE HIGHWAY ADMINISTRATION
Office of Traffic & Safety
TRAFFIC ENGINEERING DESIGN DIVISION
(Traffic Signal Plan)

MD 2-4 at Stoakley Rd./ Hospital Road

DRAWN BY:	Robert Ligon	F.A.P. NO.	N/A	TS NO. 1260J	SHEET NO.
CHECKED BY:	Robert Ligon	S.H.A. NO.	C 319X-000-585		
SCALE:	1" = 20'	COUNTY:	Calvert	T.I.M.S. NO. G200	1 OF 1
DATE:	April, 1988	LOG MILE:	04002021.52		

e:\dgns\2000\2000-0410\dgn\As-Built sig(on.dgn 2/13/2006