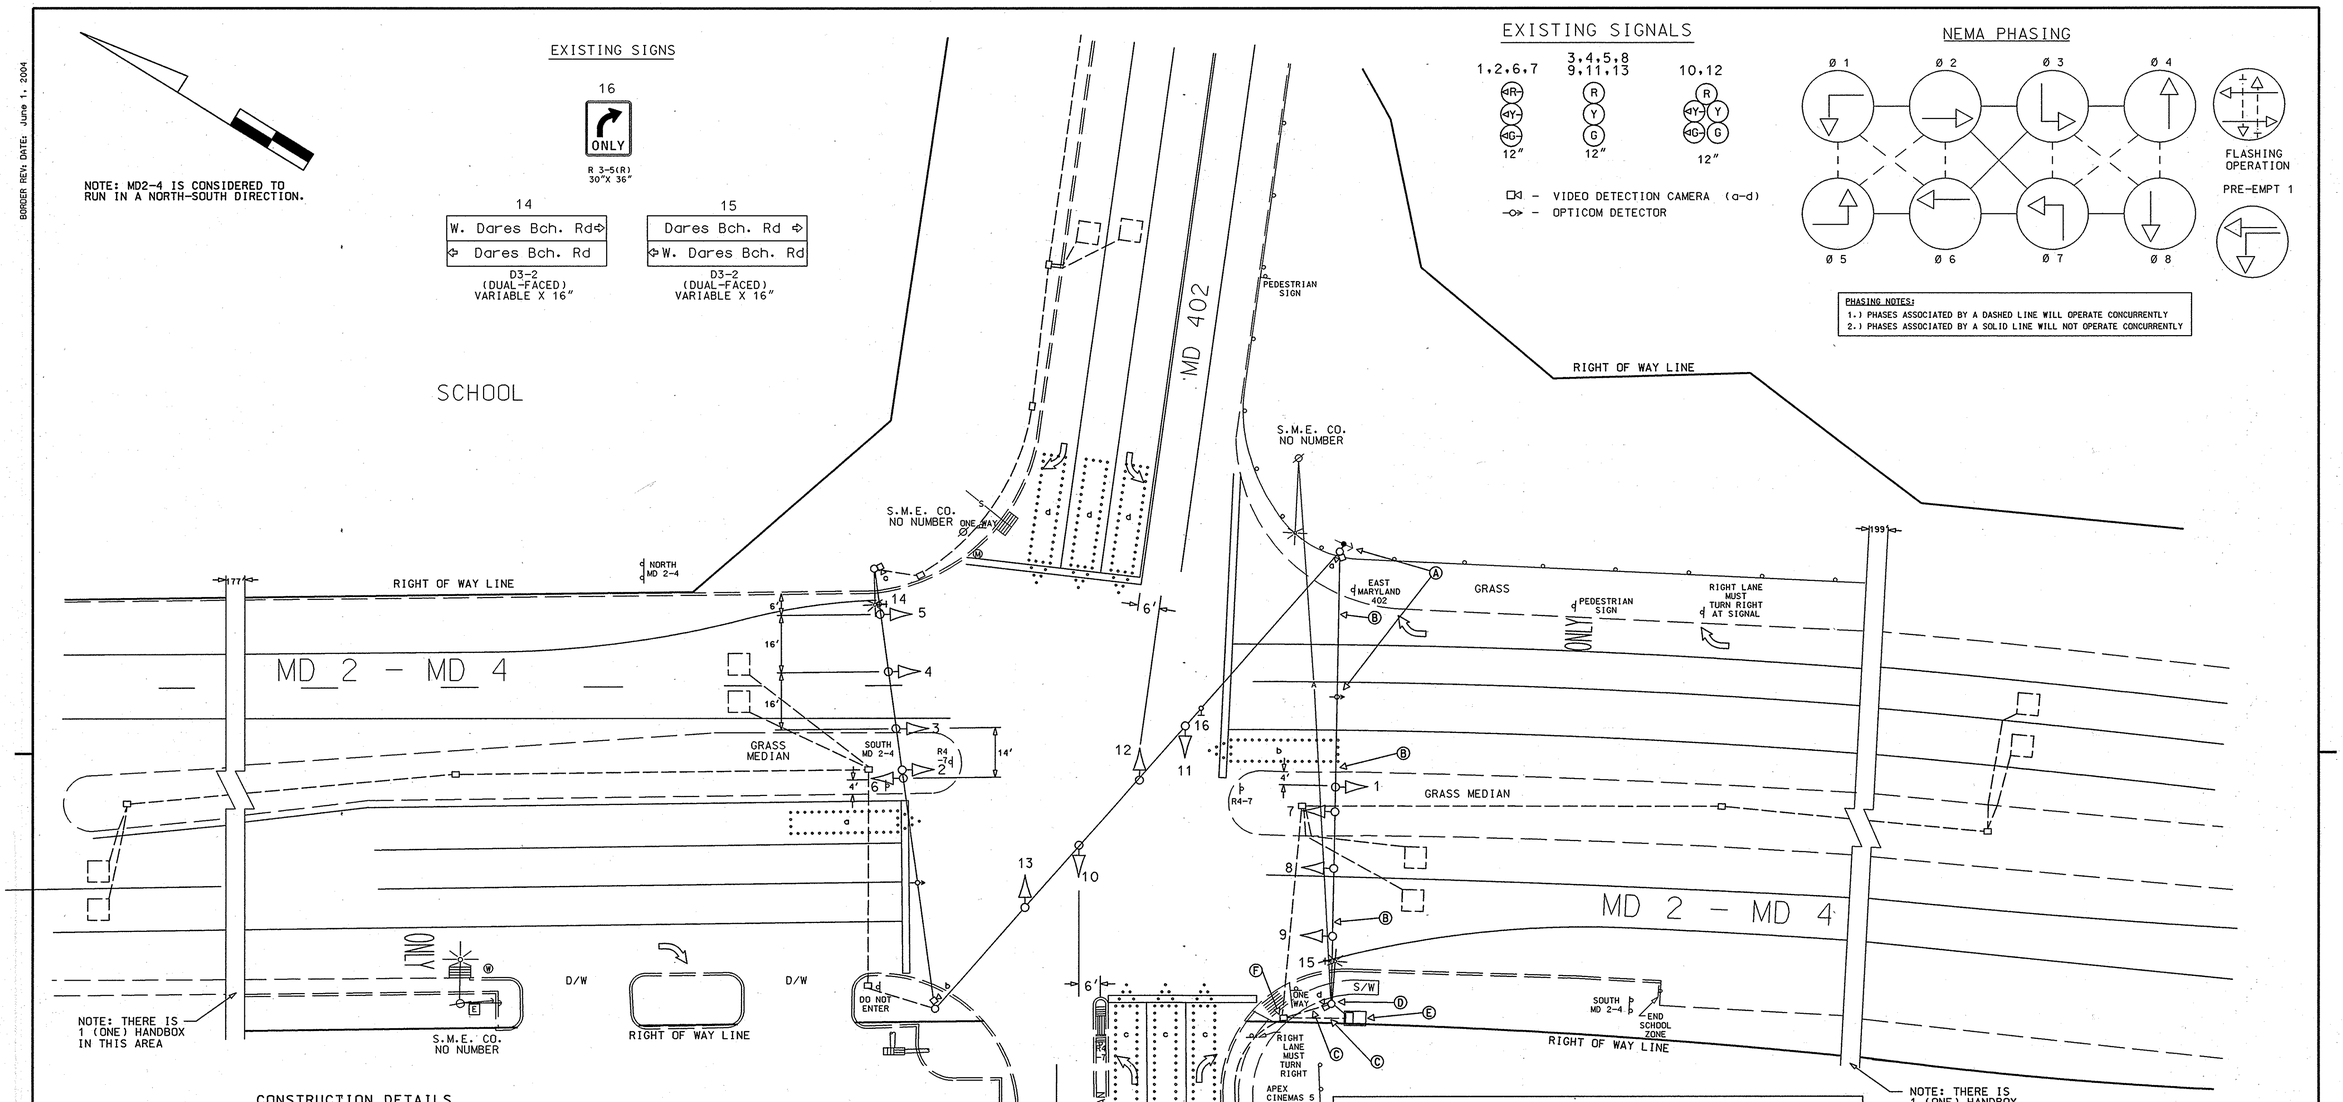

CONSTRUCTION DETAILS

A. RELOCATE EXISTING OPTICOM EYE
B. INSTALL OPTICOM CABLE USING EXISTING SPAN WIRE
C. USE EXISTING CONDUIT
D. USE EXISTING STRAIN POLE
E. USE EXISTING CABINET AND CONTROLLER
F. USE EXISTING HAND HOLE

GENERAL NOTES:

1. All underground utilities shown on these plans are schematic only and may not be complete. The contractor shall be responsible for notifying "MISS UTILITY" prior to construction so that all utilities may be located in the field. If the contractor perceives that a conflict between the utilities and the traffic signal will occur, the contractor shall notify the project engineer immediately so that the conflict may be resolved.
2. The contractor shall remove all unused wiring.

GEOMETRIC LEGEND
PROPOSED
EXISTING

LEGEND OF UNDERGROUND AND OVERHEAD UTILITIES
AERIAL CABLE — A — A —
ELECTRIC — E — E —
TELEPHONE — T — T —
GAS — G — G —
SEWER — S — S —
WATER — W — W —
CABLE TV — TV — TV —

STATE OF MARYLAND
DEPARTMENT OF TRANSPORTATION
STATE HIGHWAY ADMINISTRATION

MD 2 - MD 4 AND MD 402

PRINCE FREDERICK, MARYLAND

TRAFFIC SIGNAL PLAN

SCALE 1"= 20' DATE 4/88 CONTRACT NO. CA472A531B53

DESIGNED BY DCD CGH COUNTY CALVERT
DRAWN BY MR LOGMILE 04000220.59
CHECKED BY TIMS NO. 1540
F.A.P. NO. TOD NO.

TS NO. 333H | DRAWING NO. 1 OF 2 | SHEET NO. OF

APPROVALS
TEAM LEADER
ASST. DIV. CHIEF
DIVISION CHIEF
OFFICE DIRECTOR
ORIGINAL ON FILE

REVISIONS
(H) RELOCATE EXISTING OPTICOM EYE FOR NORTH BOUND MD 2-4 07/07
FJA
(G) UPGRADE ALL SIGNAL HEADS TO L.E.D. SHA.#: AT7825185 2/23/07
JWA | SGR | DBD | MAR | WH | WH/TH
F REPLACE LOOP DETECTORS MILLED OUT 10/99
JAH

PLOTTED: WEDNESDAY, JULY 11, 2007 AT 2:12:35 PM
FILE: MD 2-4 @ 402PL.DGN

BORDER REV: DATE: June 1, 2004

DRILL HOLES
DRILL HOLES
DRILL HOLES