F.H.W.A. REGION NO.	STATE	FED. AID PROJ. NO.	SHEET NO.	TOTAL SHEETS
3	MD.	HES-000S(62)	2	8

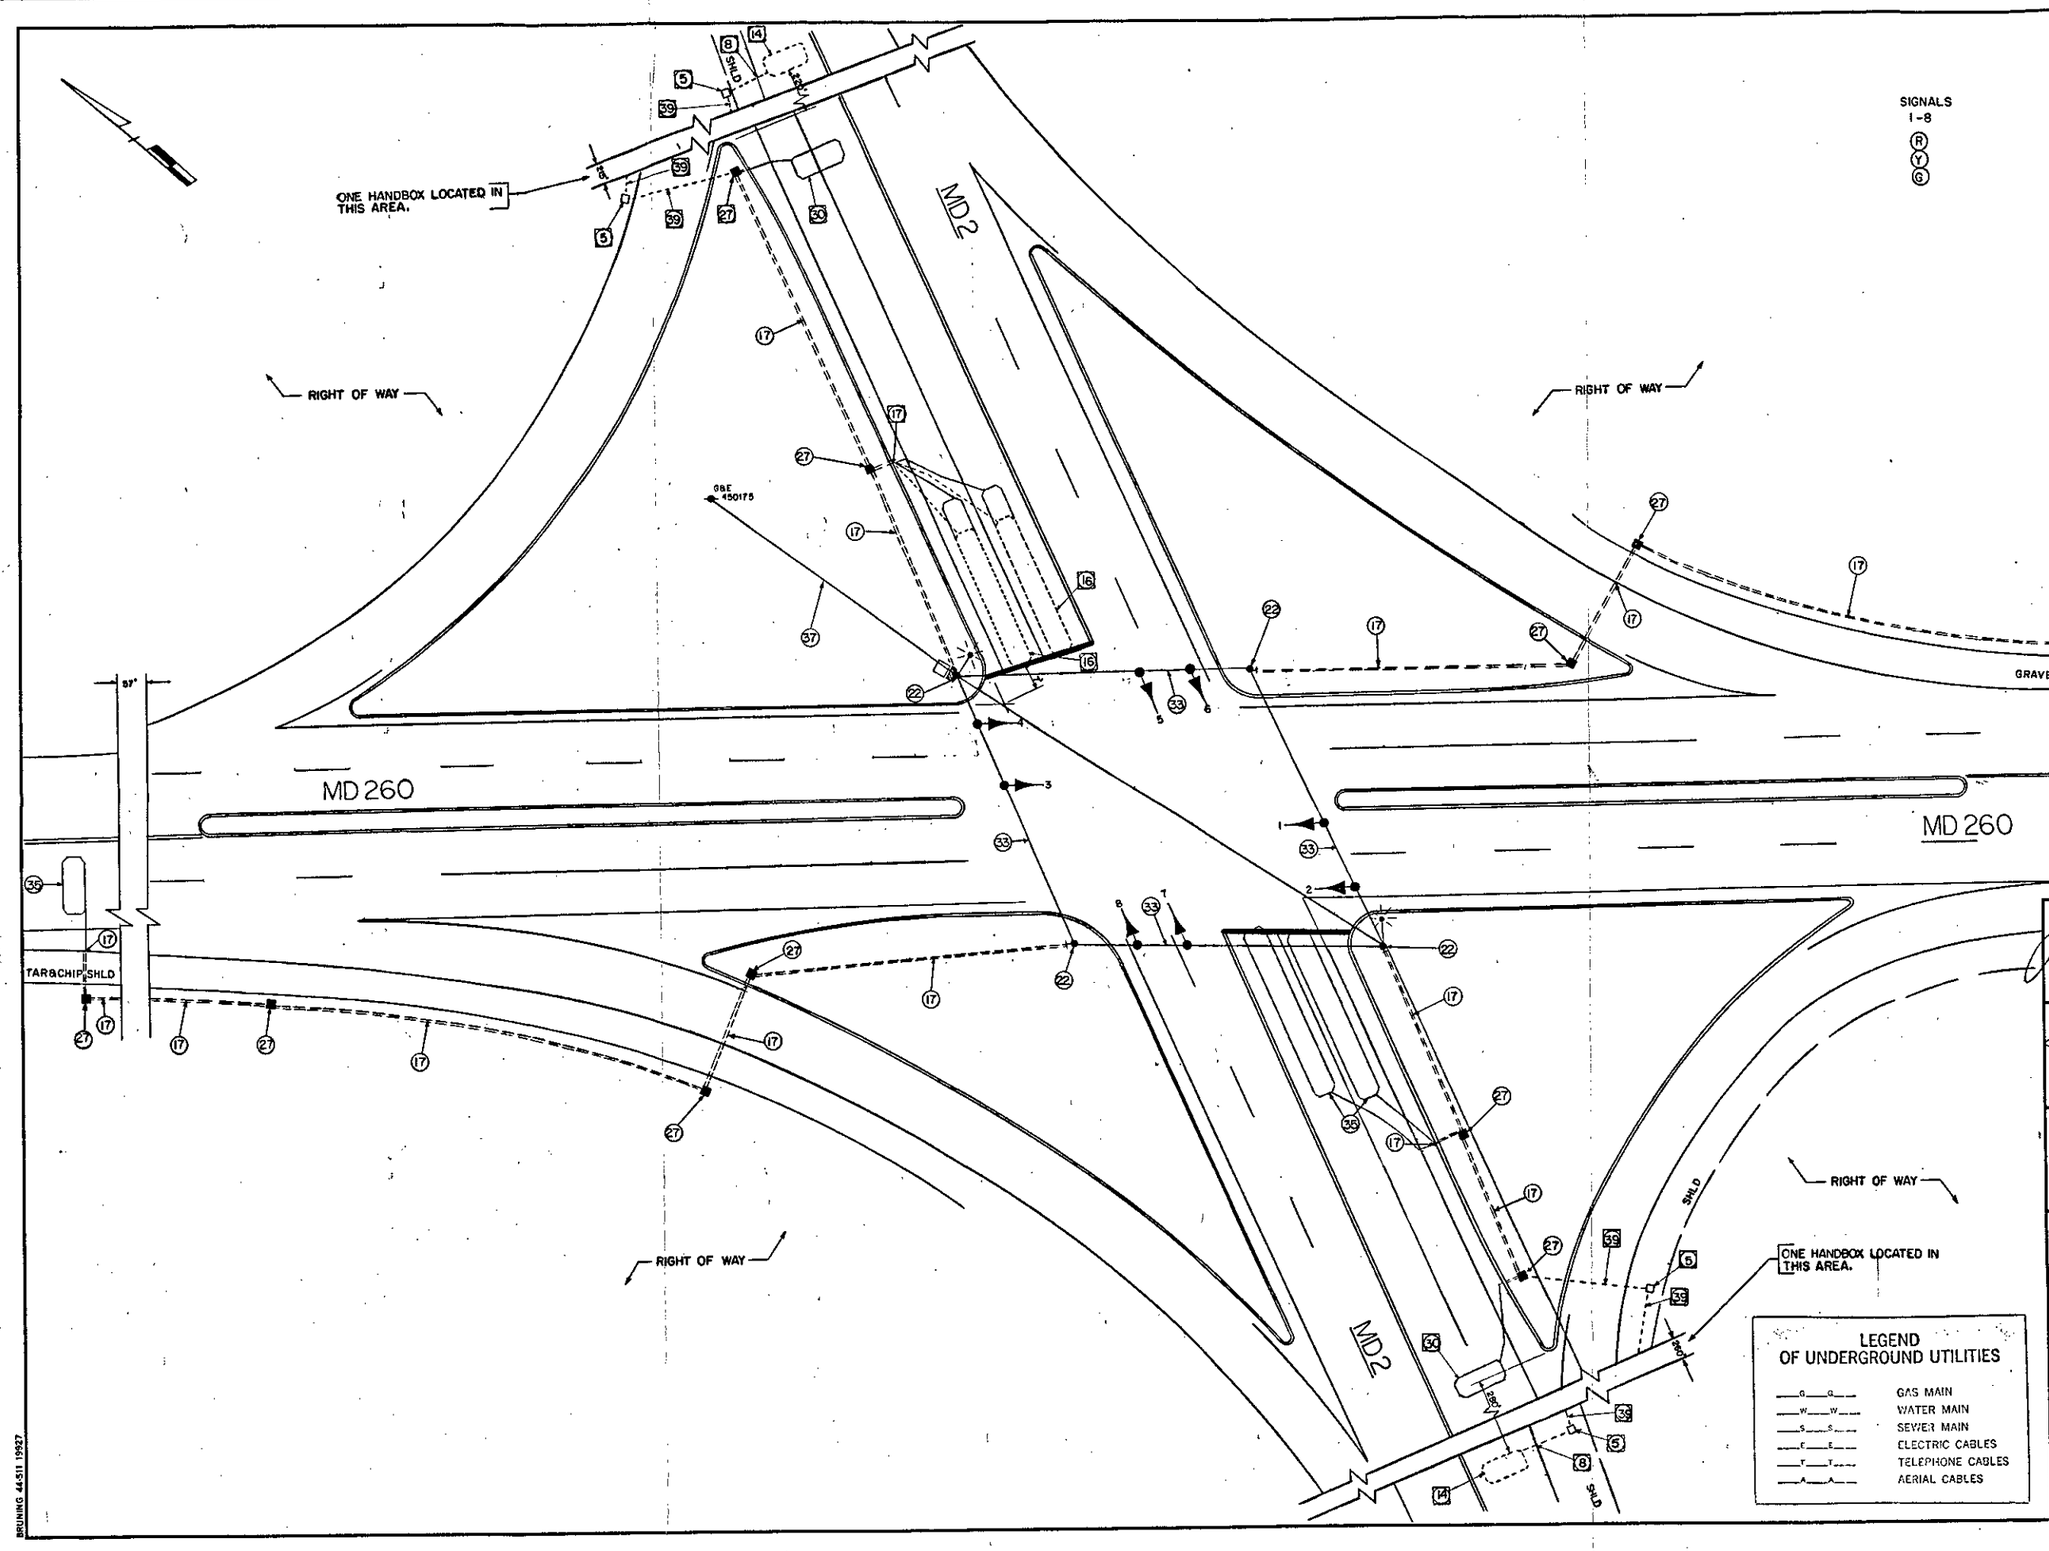

APPROVAL: REGIONAL TRAFFIC ENGINEER — 8/11/75

APPROVAL: CHIEF BUREAU OF TRAFFIC ENGINEERING — 8/11/75

APPROVAL: ASS'T. CHIEF ENGINEER TRAFFIC — 8-11-75

B MAR, 1982 RECUT VEHICLE LOOP DETECTOR WHICH IS BAD.

A 9-7-78 ASBUILT C-321X-000-585

REVISIONS

STATE OF MARYLAND
DEPARTMENT OF TRANSPORTATION
STATE HIGHWAY ADMINISTRATION

TRAFFIC DIVISION – BUREAU OF TRAFFIC ENGINEERING

MD 2 & MD 260

SCALE 1"=20' DATE 5-1-75 CONTRACT NO. AW 603-505-576

DRAWN BY: DIMITRIOS A ZAFIRIS COUNTY: CALVERT

DESIGNED BY: SIGNAL NO.: 04 001

CHECKED BY: A. Budnichuk 8/11/75

DRAWING NO. TS-1308B

04000234.06

BRUNING 44-511 19927