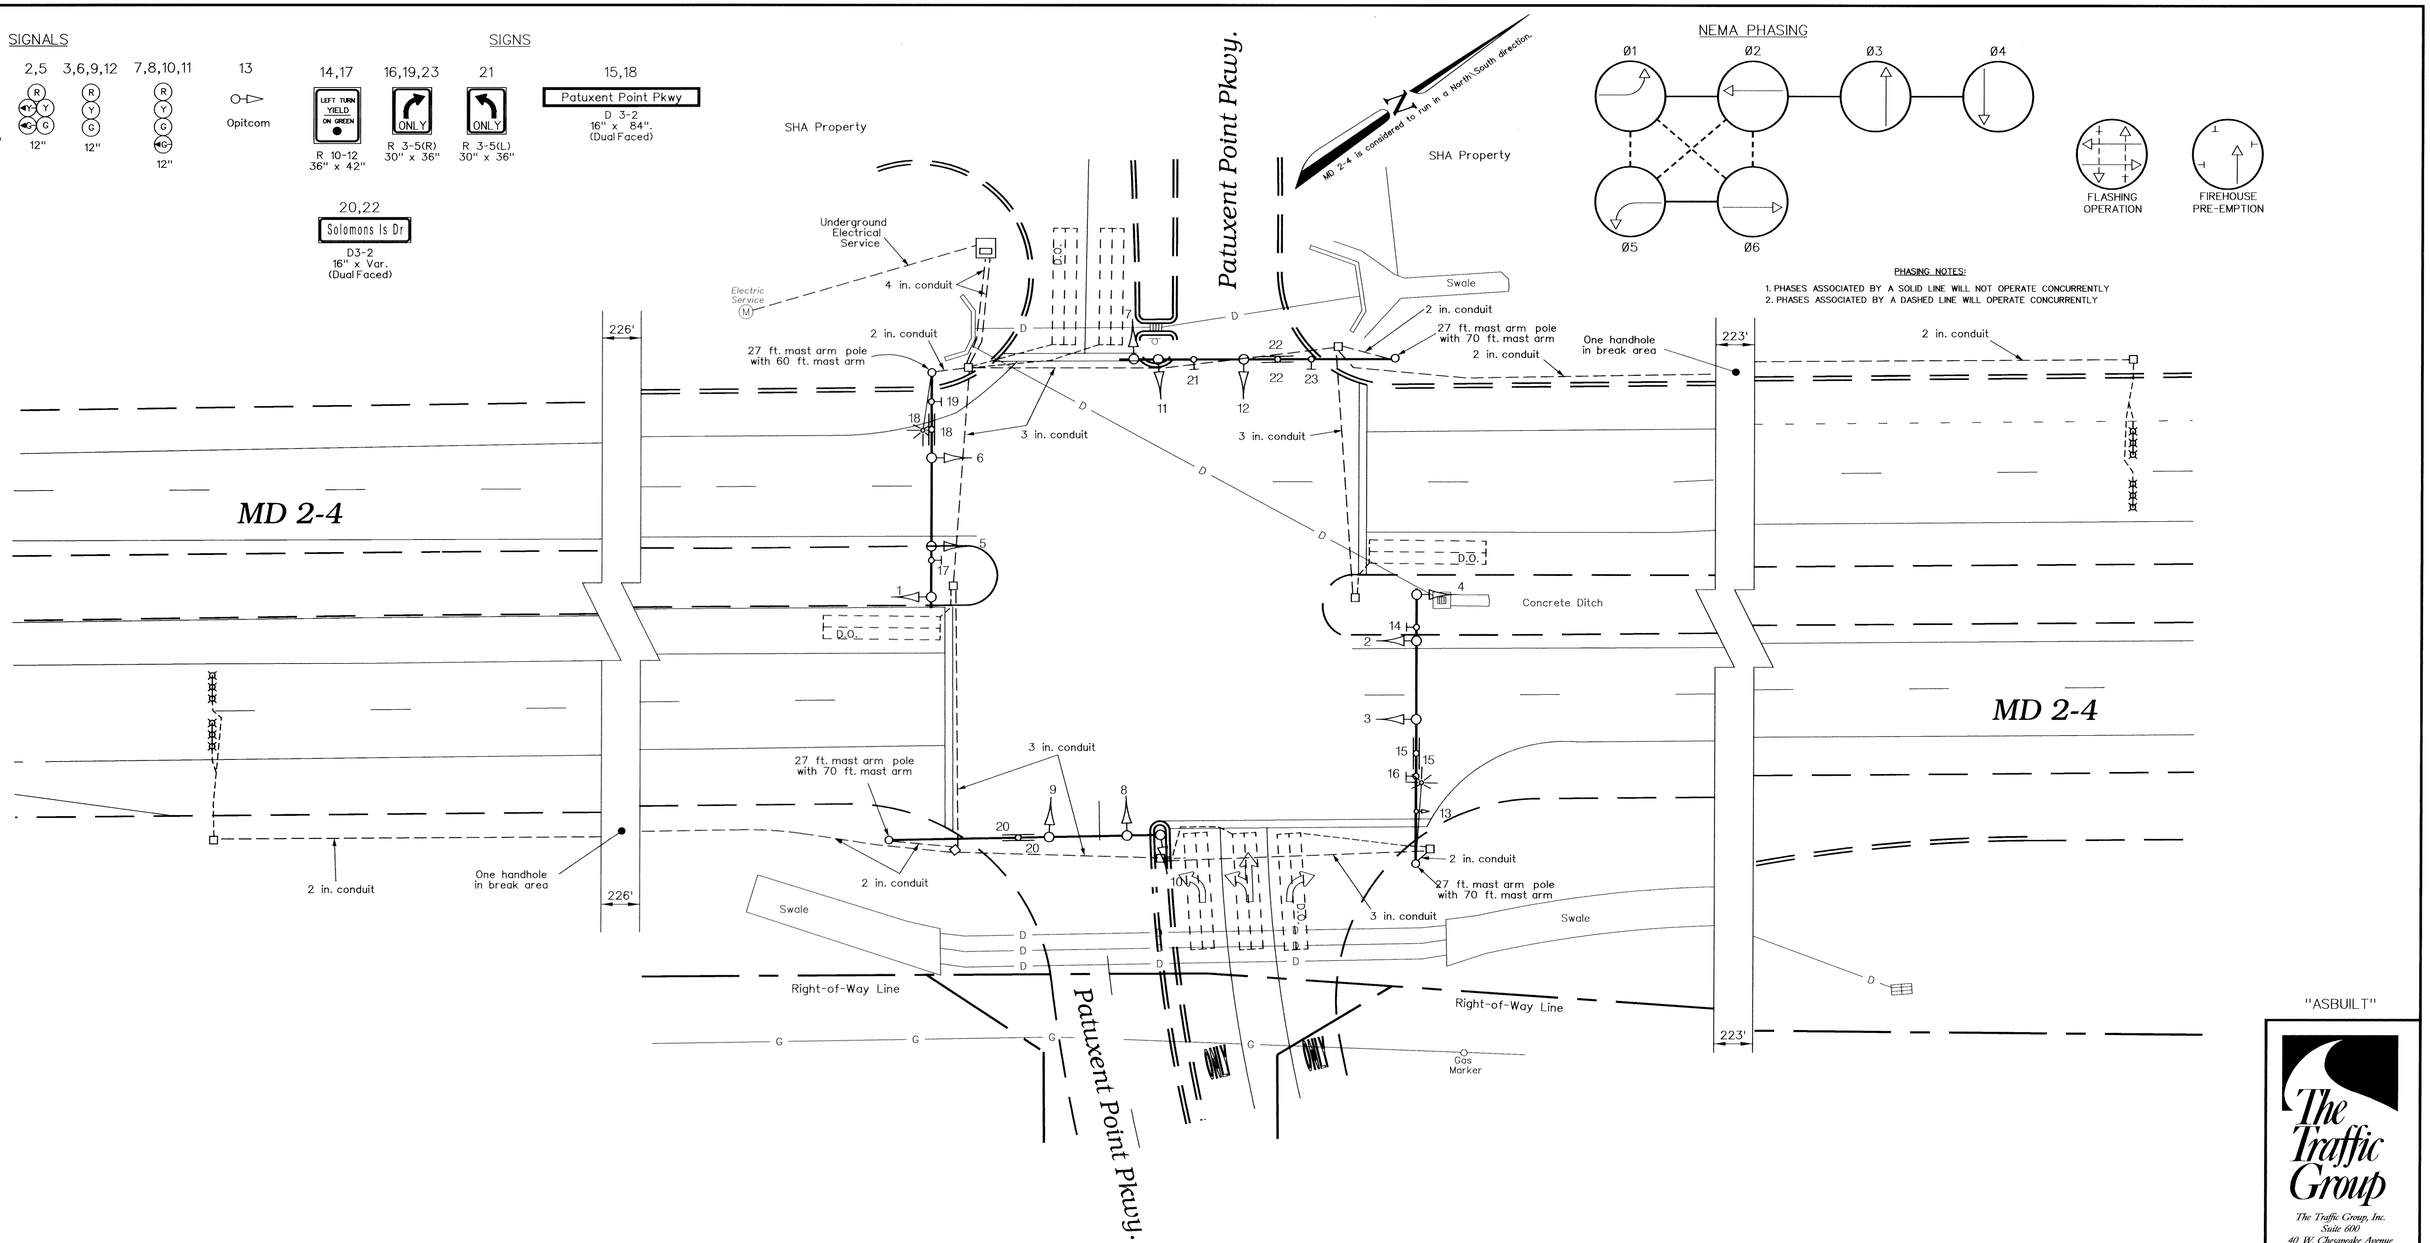

"ASBUILT"

The Traffic Group

The Traffic Group, Inc.
Suite 600
40 W. Chesapeake Avenue
Towson, Maryland 21204
410-583-8405
1-800-583-8411
Fax 410-321-8458
Job. No. 970713
ASBUILT.DGN

GEOMETRIC LEGEND

EXISTING GEOMETRICS
PROPOSED GEOMETRICS

UTILITY LEGEND

G	GAS MAIN
W	WATER MAIN
S	SEWER MAIN
E	ELECTRIC CABLES
D	STORM DRAIN
A	AERIAL CABLES
T	TELEPHONE CABLES

REVISIONS

(A) ASBUILT August 12, 1998
S.H.A. No. BW998M82
FTH

APPROVALS

ORIGINAL ON FILE

ASST. TRAFFIC ENGINEERING DESIGN DIVISION
ASST. DISTRICT ENGINEER - TRAFFIC
CHIEF, TRAFFIC ENGINEERING DESIGN DIVISION
DIRECTOR, OFFICE OF TRAFFIC & SAFETY

MDOT – STATE HIGHWAY ADMINISTRATION
Office of Traffic & Safety
TRAFFIC ENGINEERING DESIGN DIVISION
(Traffic Signal Plan)

MD 2-4 at Patuxent Point Pkwy.

DATE: January 6, 1998 LOG MILE • LOG MILE •

DRAWN BY:	J. Storck	F.A.P. NO.	N/A	PLAN SHEET NO.:	SHEET NO.
CHK. BY:	B. Thompson	S.H.A. NO.	BW996M82	3750A	1 of 1
SCALE:	1" = 20'	COUNTY:	CALVERT		

e:\asbuilt.dgn 17 AUG 98