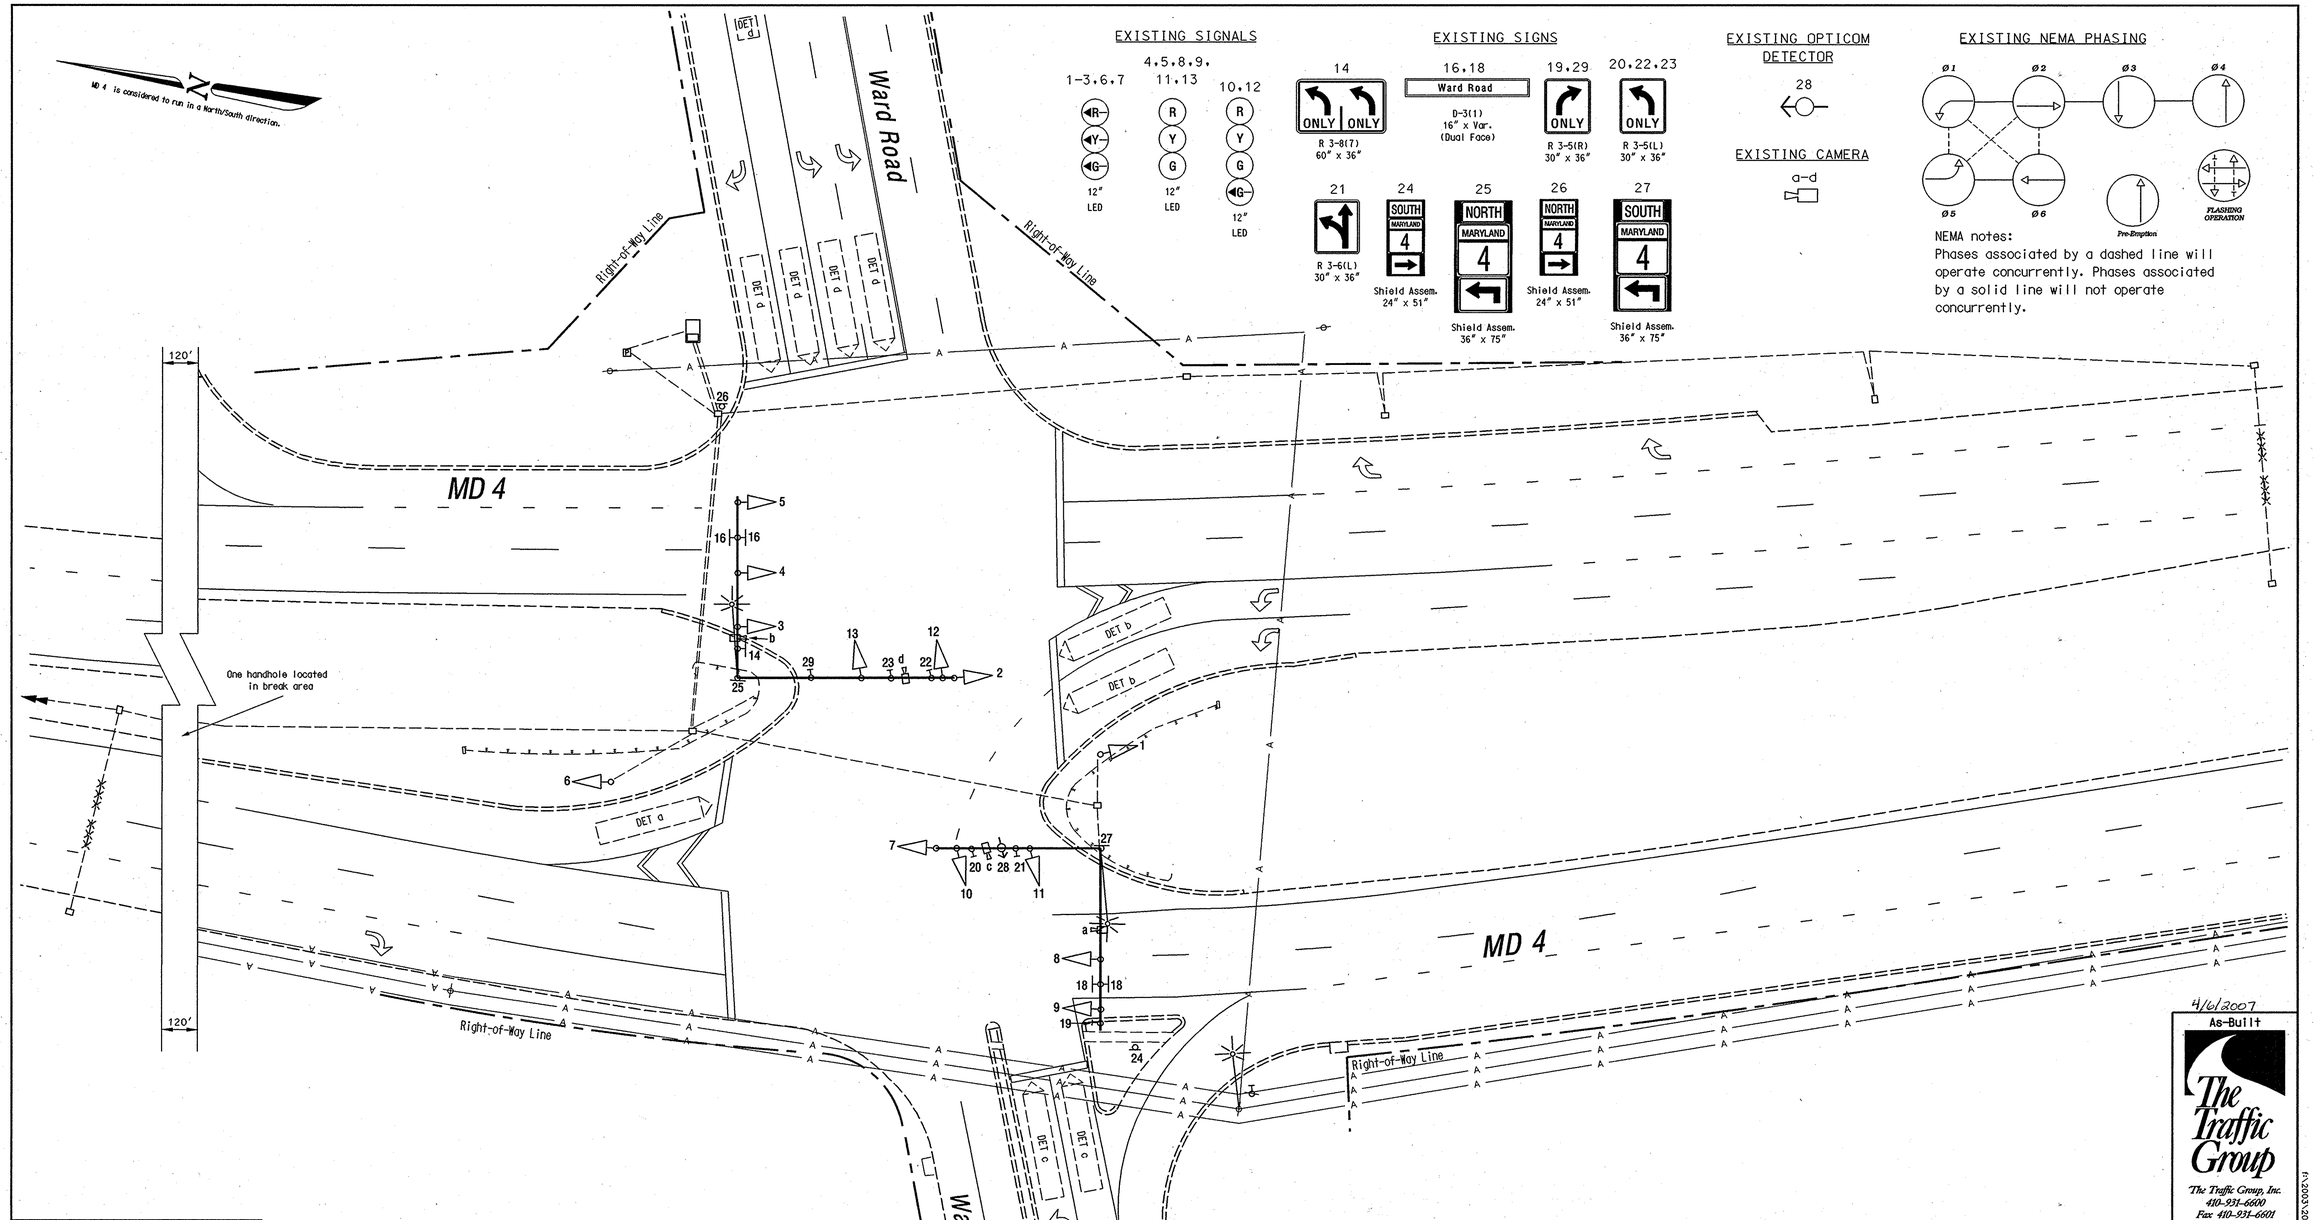

GEOMETRIC LEGEND

- EXISTING GEOMETRICS
- PROPOSED GEOMETRICS

UTILITY LEGEND

- G — GAS MAIN
- W — WATER MAIN
- S — SEWER MAIN
- E — ELECTRIC CABLES
- D — STORM DRAIN
- A — AERIAL CABLES
- T — TELEPHONE CABLES

REVISIONS

C	Reconstruct traffic signal due to geometric changes. S.H.A. No.: BW996M82	Nov. 2, 2005
fjh/jes		
B	Remove firehouse signal S.H.A. No.: BW996M82	January 23, 2003
fjh		
A	Install opticom pre-emtion for firehouse signal S.H.A. No.: BW996M82	March 12, 1992

APPROVALS

TEAM LEADER, TRAFFIC ENGINEERING DESIGN DIVISION

ASST. CHIEF TRAFFIC ENGINEERING DESIGN DIVISION

CHIEF, TRAFFIC ENGINEERING DESIGN DIVISION

DIRECTOR, TRAFFIC & SAFETY

ORIGINAL ON FILE

MARYLAND DOT - STATE HIGHWAY ADMINISTRATION

Office of Traffic & Safety

TRAFFIC ENGINEERING DESIGN DIVISION

(Traffic Signal Plan)

MD 4 at Ward Road

DRAWN BY:	J. Dirndorfer	F.A.P. NO.	N/A	TS NO. 3171C	SHEET NO.
CHECKED BY:	J. Dirndorfer	S.H.A. NO.	BW-467-802-512		
SCALE:	1" = 20'	COUNTY:	Calvert	T.I.M.S. NO. G921	1 OF 2
DATE:	March 12 , 1992	LOG MILE:	04000433.23		

f:\2003\2003-0301\Ward Rd As-built.dgn 4/6/2007