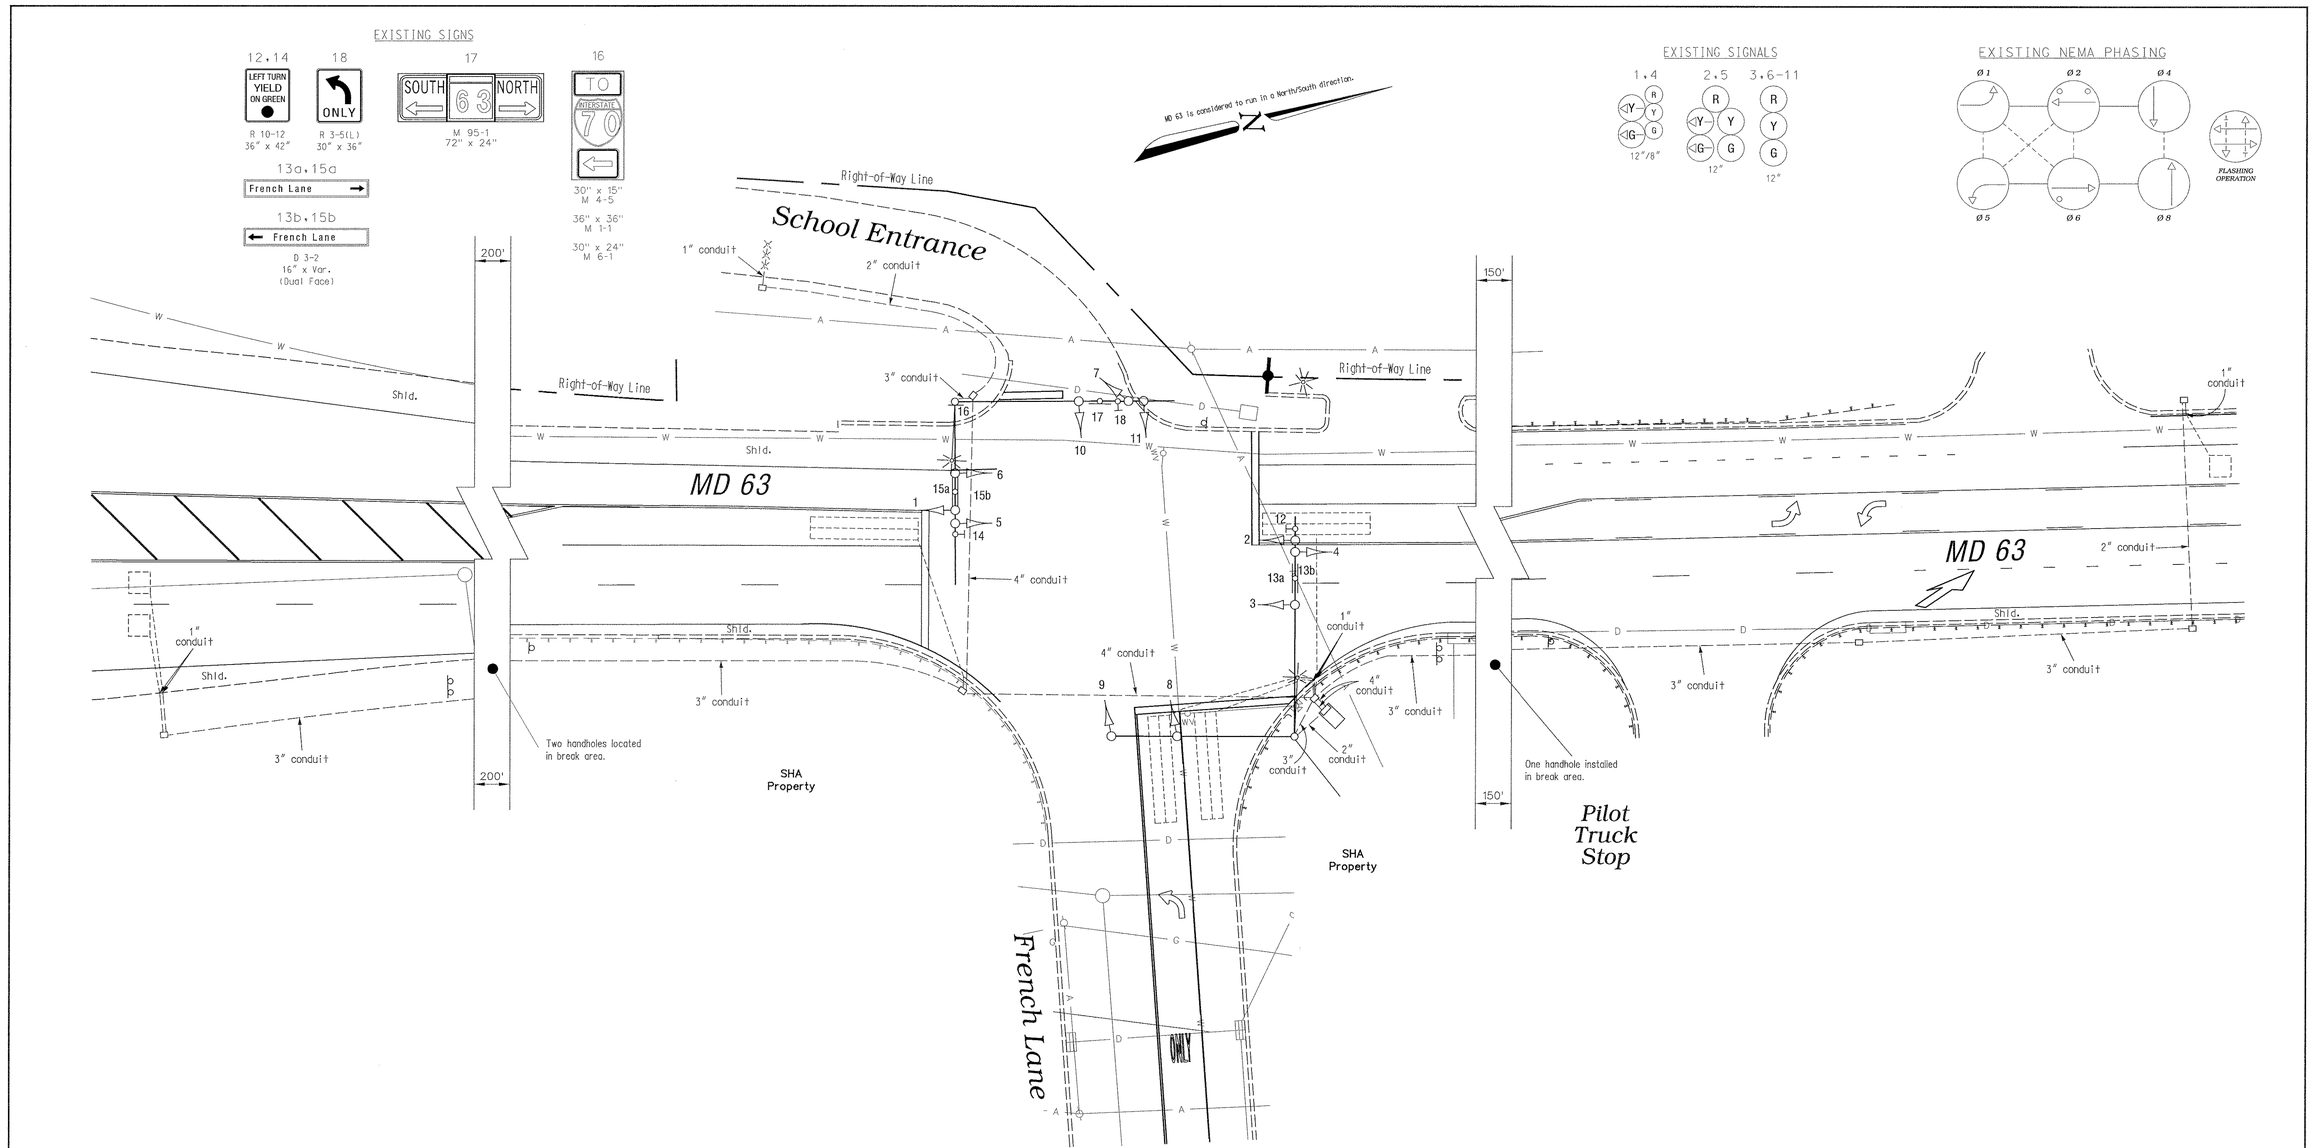

GEOMETRIC LEGEND

EXISTING GEOMETRICS

PROPOSED GEOMETRICS

UTILITY LEGEND

G	GAS MAIN
W	WATER MAIN
S	SEWER MAIN
E	ELECTRIC CABLES
D	STORM DRAIN
A	AERIAL CABLES
T	TELEPHONE CABLES

"As-Built"

The Traffic Group

The Traffic Group, Inc.
410-931-6600
Fax 410-931-6601

REVISIONS

As-Built March 7, 2000

S.H.A. No.:BW996M82

JES

APPROVALS

TEAM LEADER, TRAFFIC ENGINEERING DESIGN DIVISION

ASST. CHIEF TRAFFIC ENGINEERING DESIGN DIVISION

CHIEF, TRAFFIC ENGINEERING DESIGN DIVISION

DIRECTOR, TRAFFIC & SAFETY

ORIGINAL ON FILE

MARYLAND DOT - STATE HIGHWAY ADMINISTRATION

Office of Traffic & Safety

TRAFFIC ENGINEERING DESIGN DIVISION

(Traffic Signal Plan)

MD 63 at French Lane

DRAWN BY:	J. Storck	F.A.P. NO.	N/A	TS NO. 3942	SHEET NO.
CHECKED BY:	D. Doda	S.H.A. NO.	BW996M82		
SCALE:	1" = 20'	COUNTY:	Washington	T.I.M.S. NO. D525	1 OF 1
DATE:	October 15, 1999	LOG MILE:	21063010.42		

f:\990713\dea\asbuilt.dgn 08 MAR 2000