K&E BALTIMORE 17 0153 PHOENIX 10-75 MC 4156

F.H.W.A. REGION NO.	STATE	FED. AID PROJ. NO.	SHEET NO.	TOTAL SHEETS
3	MD.		2	5

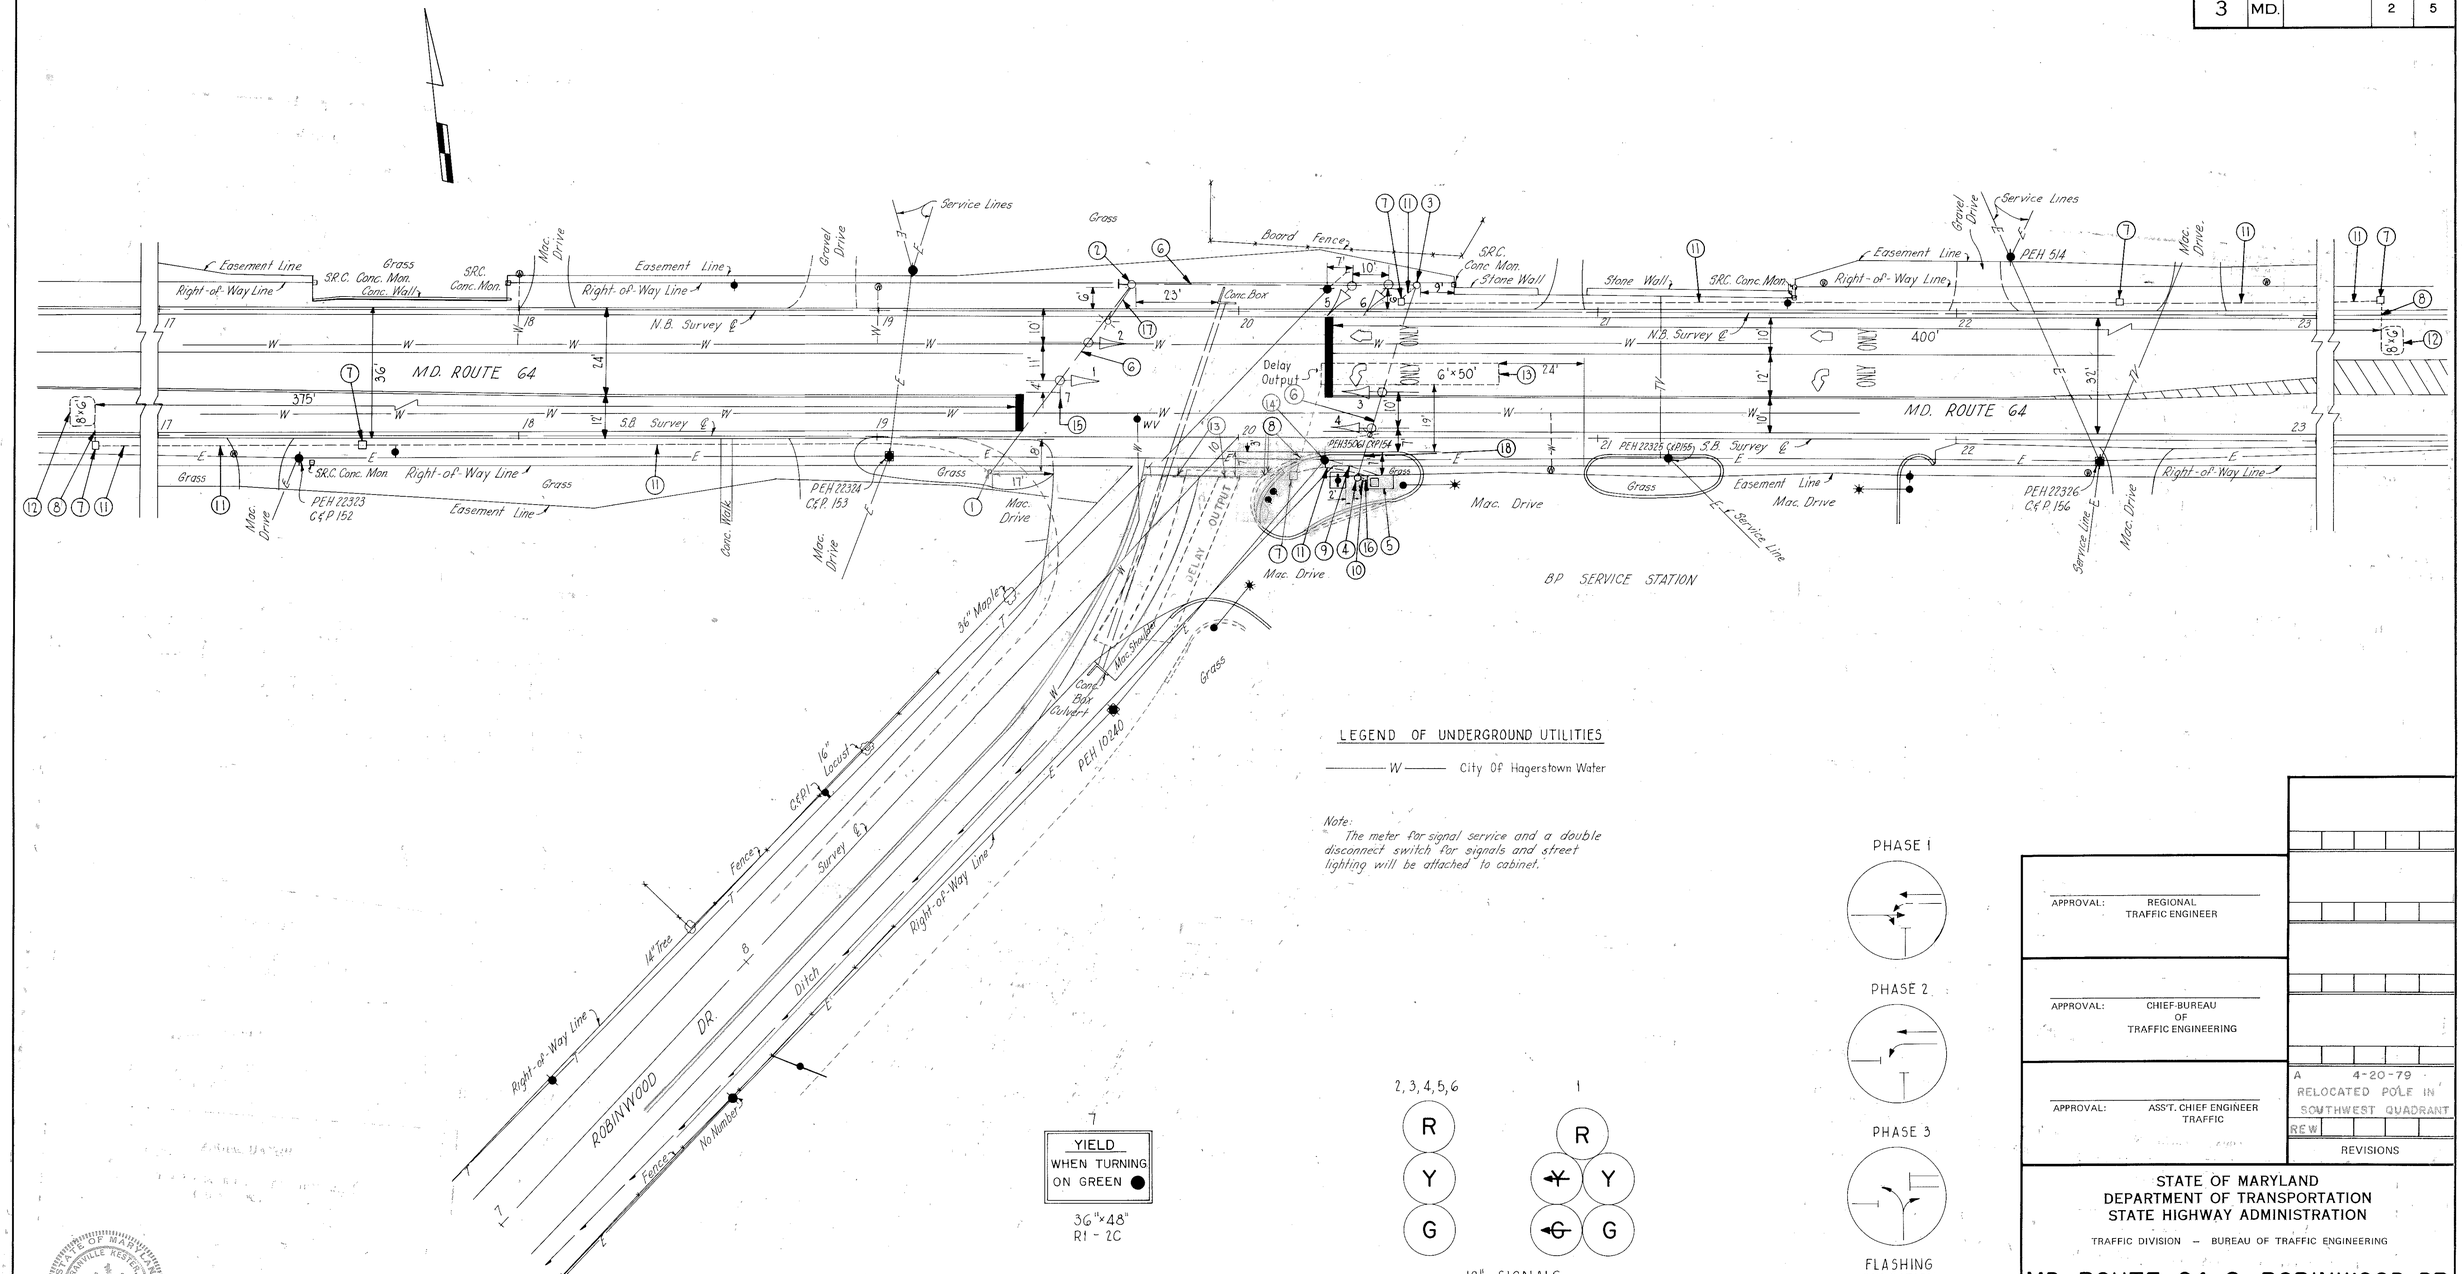

LEGEND OF UNDERGROUND UTILITIES

——— W ——— City Of Hagerstown Water

Note:
The meter for signal service and a double disconnect switch for signals and street lighting will be attached to cabinet.

7

YIELD
WHEN TURNING
ON GREEN ●

36"×48"
R1 - 2C

12" SIGNALS

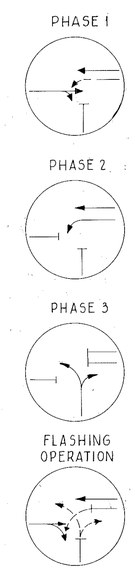

APPROVAL: REGIONAL TRAFFIC ENGINEER

APPROVAL: CHIEF-BUREAU OF TRAFFIC ENGINEERING

APPROVAL: ASS'T. CHIEF ENGINEER TRAFFIC

A 4-20-79 RELOCATED POLE IN SOUTHWEST QUADRANT REW

REVISIONS

STATE OF MARYLAND
DEPARTMENT OF TRANSPORTATION
STATE HIGHWAY ADMINISTRATION

TRAFFIC DIVISION – BUREAU OF TRAFFIC ENGINEERING

MD. ROUTE 64 & ROBINWOOD DR.

SCALE 1" = 20' DATE CONTRACT NO. W-712-501-685

DRAWN BY: BLH COUNTY: WASHINGTON

DESIGNED BY: JWH SIGNAL NO.:

CHECKED BY: DHB

DRAWING NO. TS-1600A

STATE OF MARYLAND GRANVILLE KESTER JR. No. 8136 REGISTERED PROFESSIONAL ENGINEER

Granville Kester Jr.

PREPARED BY
MICHAEL BAKER, JR., INC.
— Engineers and Surveyors —
HARRISBURG, PA. 17105
DATE: 10/20/78