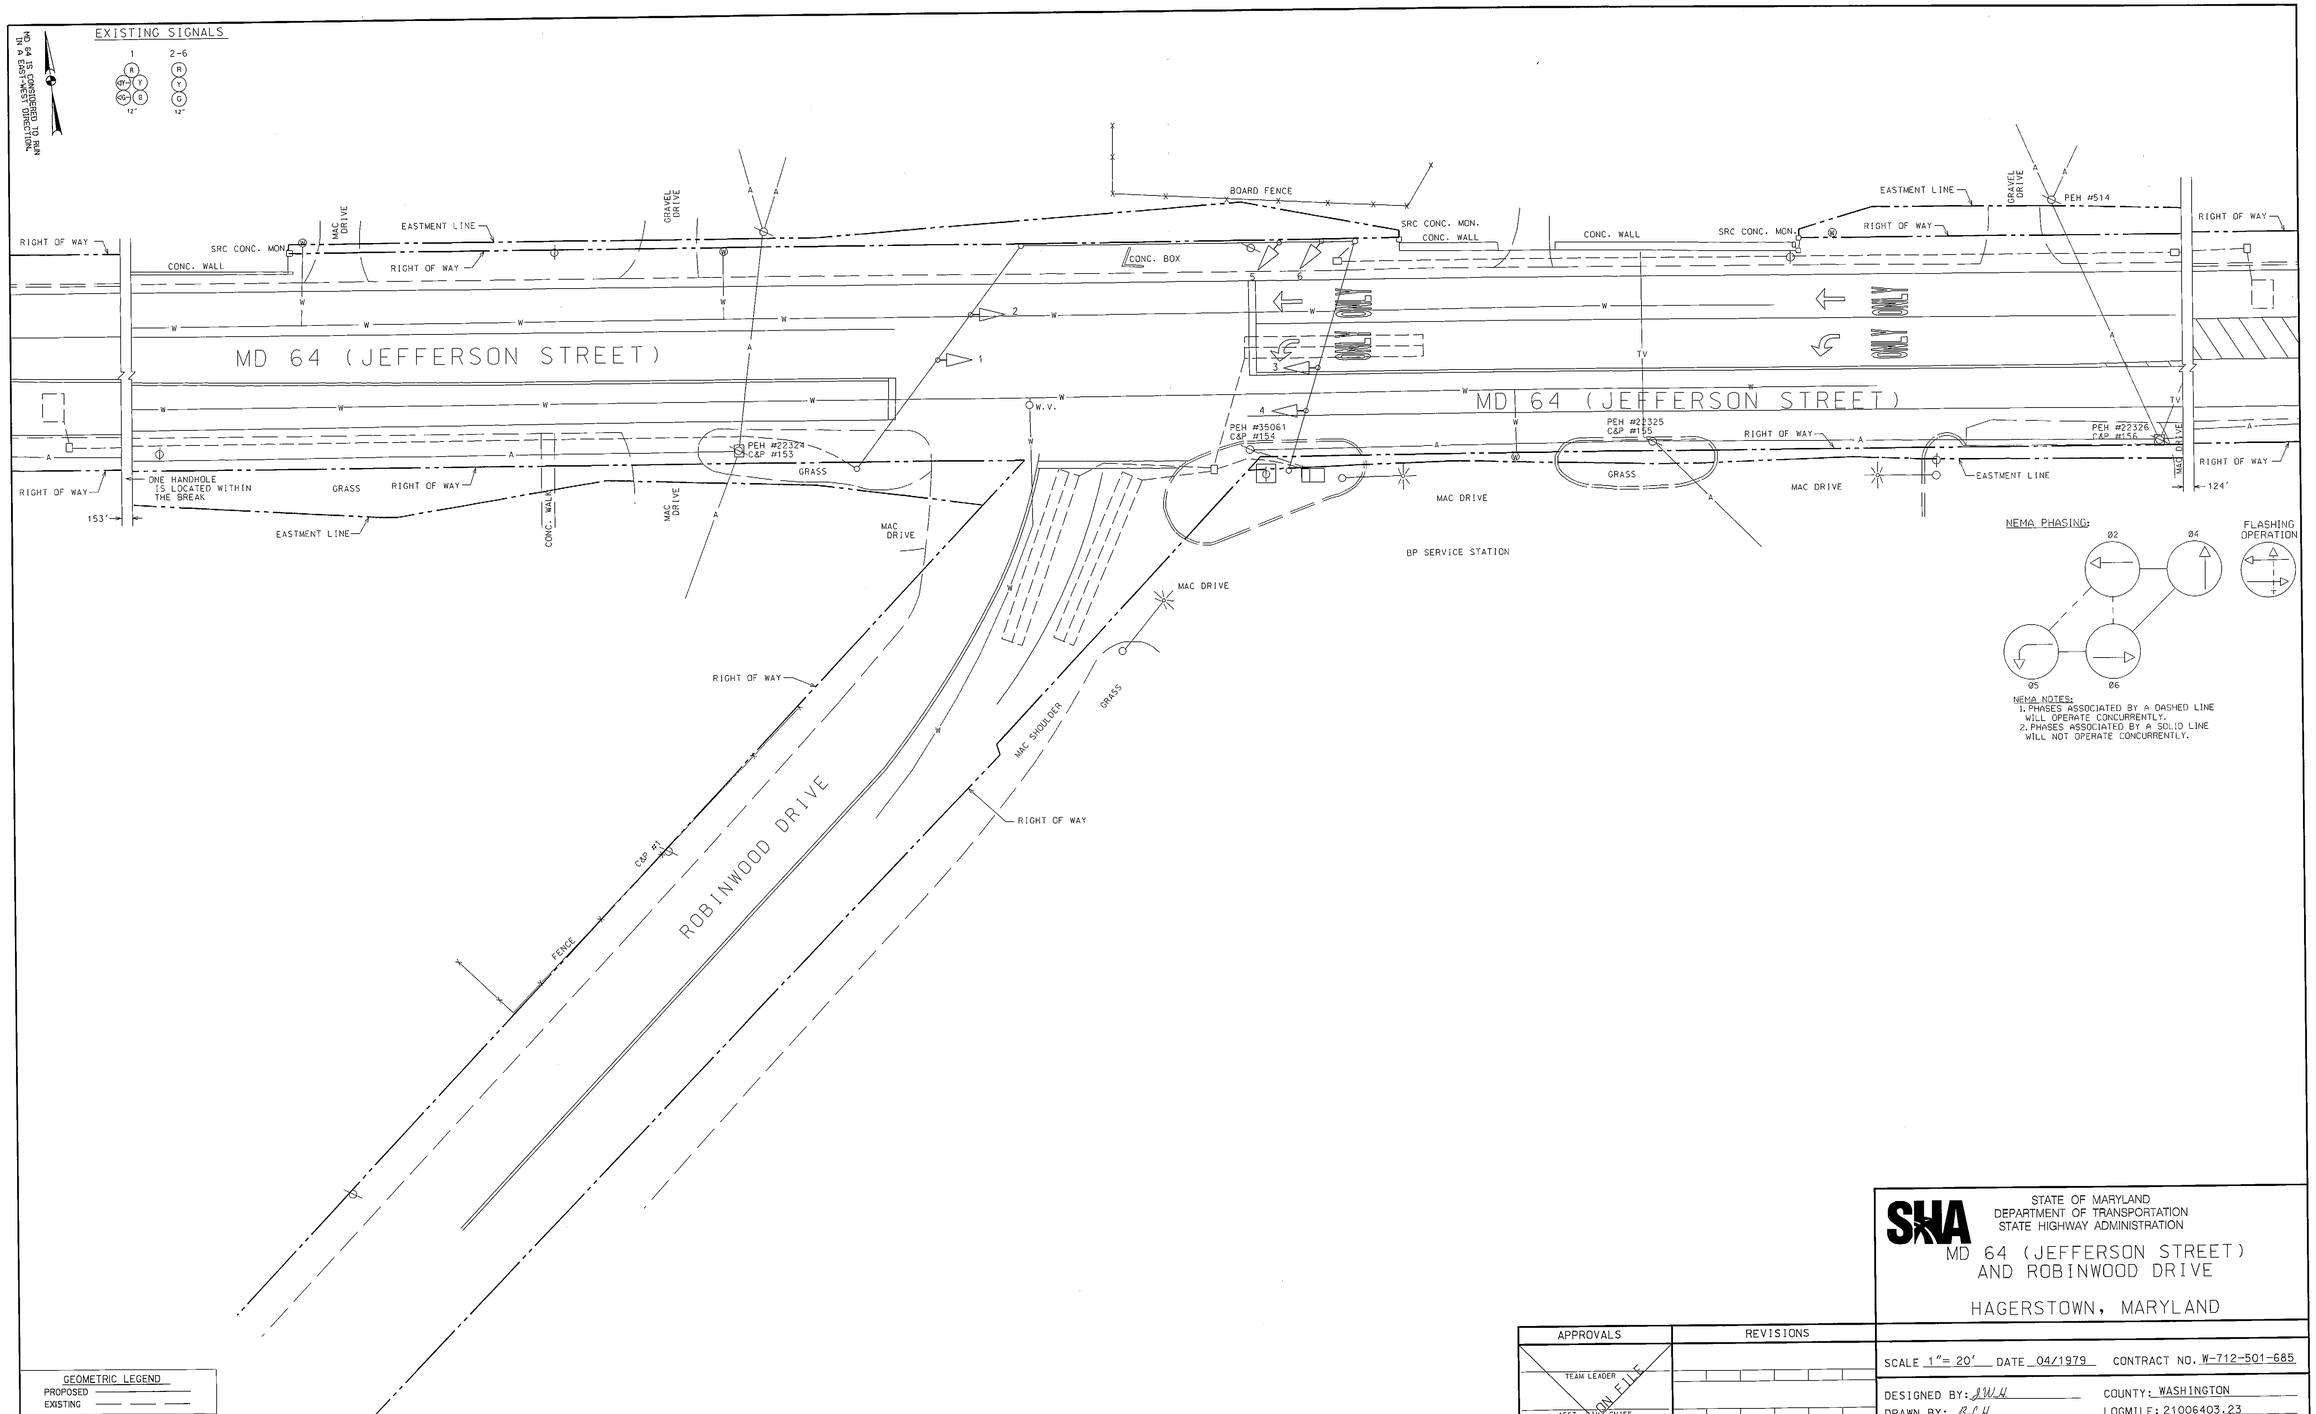

DRILL HOLES

DRILL HOLES

GEOMETRIC LEGEND
PROPOSED
EXISTING

UTILITY LEGEND
G — GAS MAIN
W — WATER MAIN
S — SEWER MAIN
E — ELECTRIC CABLES
A — AERIAL CABLES
T — TELEPHONE CABLES
D — STORM DRAIN

APPROVALS	REVISIONS
TEAM LEADER	
ASST. DIV. CHIEF	B. 07/2010 - UPDATED THE PLAN TO SHOW THE CHANGE OF THE EXISTING LAG LEFT TURN TO A LEADING LEFT TURN AS COMPLETED BY THE SHA SIGNAL SHOP; SHA NO. AX108551 TIMS NO. K589
DIVISION CHIEF	A. 04/20/1979 - RELOCATED POLE IN THE SOUTHWEST QUADRANT
OFFICE DIRECTOR	SHA NO. RZW

ORIGINAL ON FILE

STATE OF MARYLAND
DEPARTMENT OF TRANSPORTATION
STATE HIGHWAY ADMINISTRATION

MD 64 (JEFFERSON STREET)
AND ROBINWOOD DRIVE

HAGERSTOWN, MARYLAND

SCALE 1"= 20' DATE 04/1979 CONTRACT NO. W-712-501-685

DESIGNED BY: JWH
DRAWN BY: BCH
CHECKED BY: DHB
F.A.P. NO.:

COUNTY: WASHINGTON
LOGMILE: 21006403.23
TIMS NO.: K589
TOD NO.:

DRAWING NO. 1600 B - OF

SHEET NO. 1 OF 1