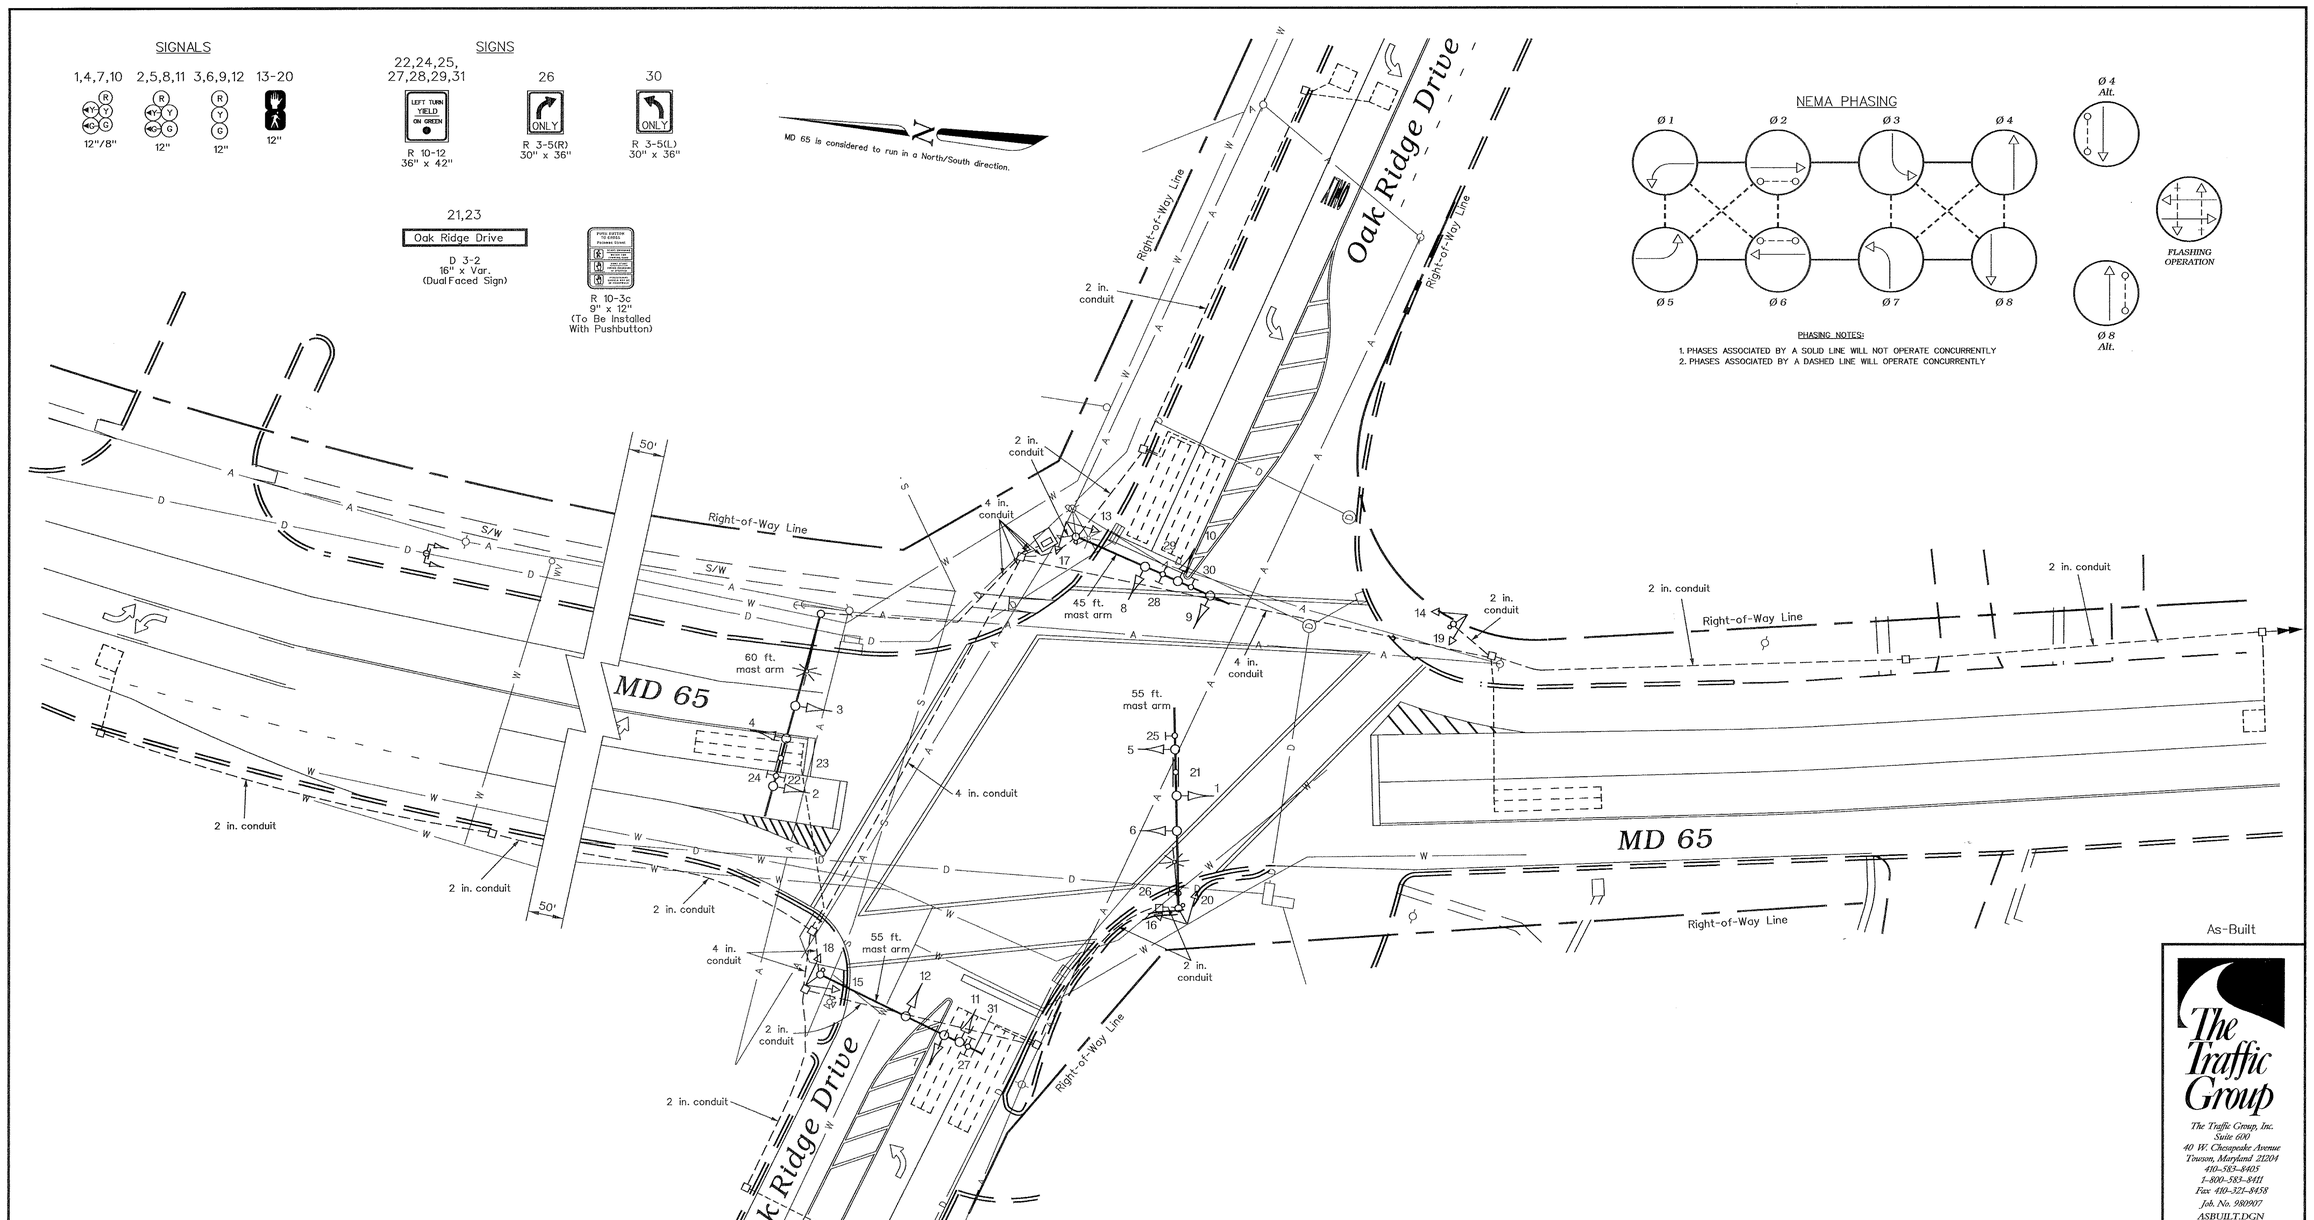

The Traffic Group

The Traffic Group, Inc.
Suite 600
40 W. Chesapeake Avenue
Towson, Maryland 21204
410-583-8605
1-800-583-8411
Fax 410-321-8458
Job. No. 980907
ASBUILT.DGN

GEOMETRIC LEGEND

EXISTING GEOMETRICS
PROPOSED GEOMETRICS

UTILITY LEGEND

G G	GAS MAIN
W W	WATER MAIN
S S	SEWER MAIN
E E	ELECTRIC CABLES
D D	STORM DRAIN
A A	AERIAL CABLES
T T	TELEPHONE CABLES

REVISIONS

(1) Asbuilt — September 1,1999
S.H.A. No.:BW996M82
JES

H	INSTALL OPTICOM PRE-EMPTION FOR E/B AND W/B OAK RIDGE DRIVE — 6/1/1999
G	MODIFY FOR NEW GEOMETRICS AND ADD PED X-ING SHA NO. BW996M82 — DECEMBER 9, 1998
F	MODIFY DUE TO GEOMETRIC CHANGES AND INSTALL IC CABLE SHA NO. BW996M82 — MARCH 12, 1988

JES BT DD BRK TH,BRK

APPROVALS

ORIGINAL ON FILE

ASST. TRAFFIC ENGINEERING DESIGN DIVISION
ASST. DISTRICT ENGINEER - TRAFFIC
CHIEF, TRAFFIC ENGINEERING DESIGN DIVISION
DIRECTOR, OFFICE OF TRAFFIC & SAFETY

MDOT - STATE HIGHWAY ADMINISTRATION
Office of Traffic & Safety
TRAFFIC ENGINEERING DESIGN DIVISION
(Traffic Signal Plan)

MD 65 (Potomac Street) at Oak Ridge Drive

DATE: July 12, 1972 — LOG MILE • 21006511.01

DRAWN BY:	L.Townsend/DCD	F.A.P. NO.	N/A	PLAN SHEET NO.:	SHEET NO.
CHK. BY:	W. W. Fitch	S.H.A. NO.	W-565X-675	172.1	1 of
SCALE:	1" = 20'	COUNTY:	WASHINGTON		

08 SEP 1999