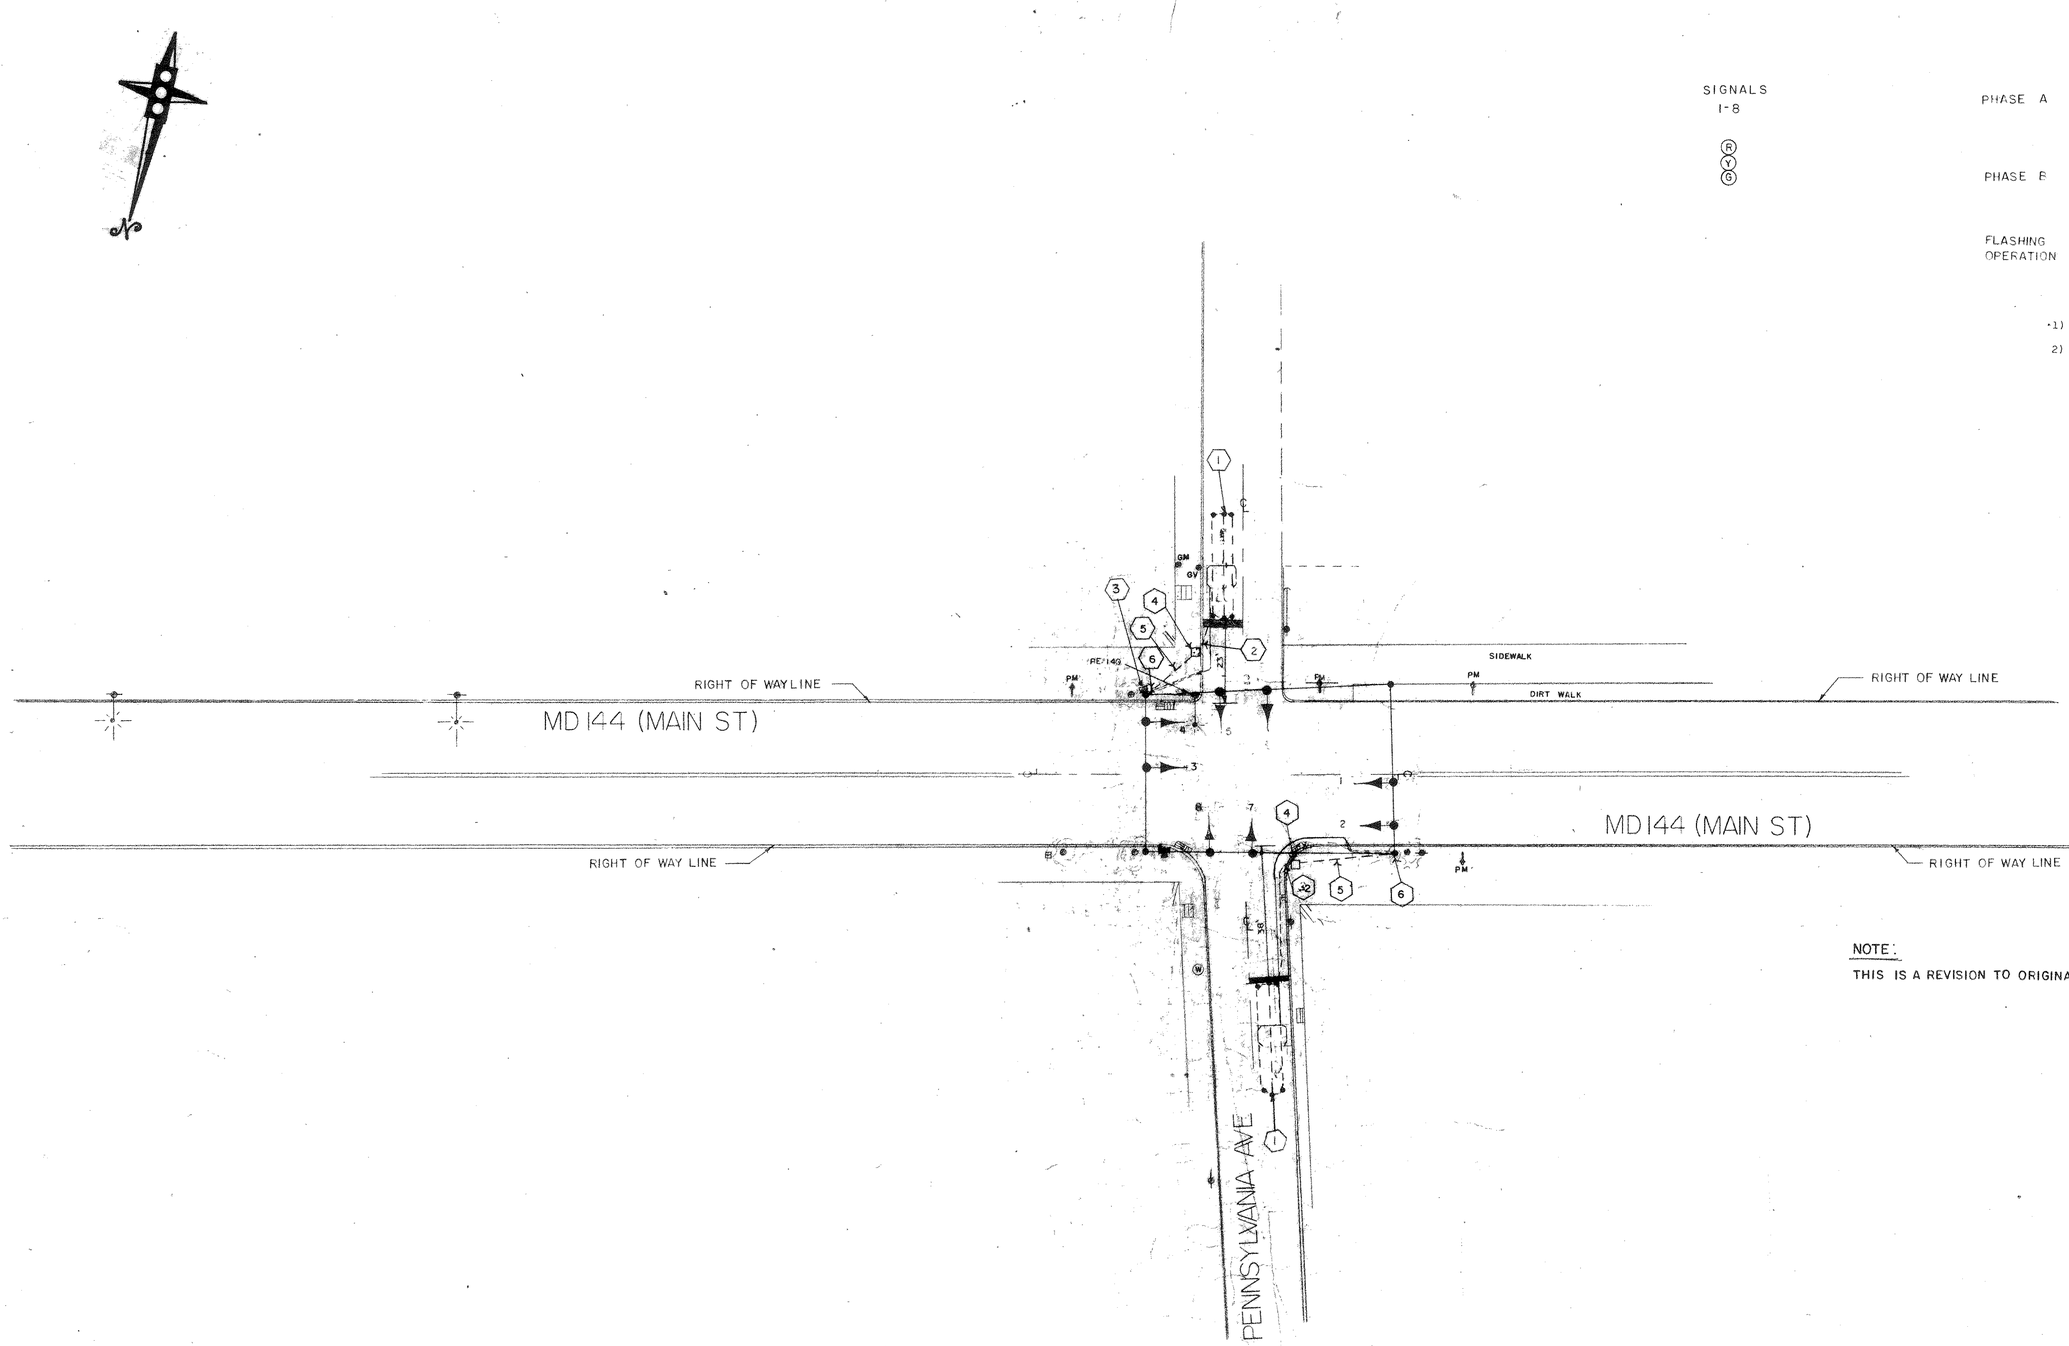

1) Phases associated by a solid line will not operate concurrently.

2) Phase associated by a dashed line will operate concurrently.

NOTE:

THIS IS A REVISION TO ORIGINAL CONTRACT W-567X-675

REVISED LOOP DETECTION 4-17-86
SHA NO 855-25005
JJD
AS BUILT
FMD 7-2-73
REVISIONS

Gene R Straub 8-22-72
APPROVAL: CHIEF - ~~BUREAU~~ RTE OF TRAFFIC ENGINEERING

8-22-72
APPROVAL: ASS'T CHIEF ENGINEER TRAFFIC SAFETY

MARYLAND STATE ROADS COMMISSION
DIVISION OF TRAFFIC SAFETY
BUREAU OF TRAFFIC ENGINEERING

MD 144 & PENNSYLVANIA AVE

DATE
SCALE 1"=20'
DRAWN BY: W RICHARDSON
CONTRACT NO W-567X-675
COUNTY WASHINGTON
CHECKED BY:

DRAWING NO.
TS-524 B