F.H.WA. REGION NO.	STATE	FED. AID PROJ. NO.	SHEET NO.	TOTAL SHEETS
3	MD.			

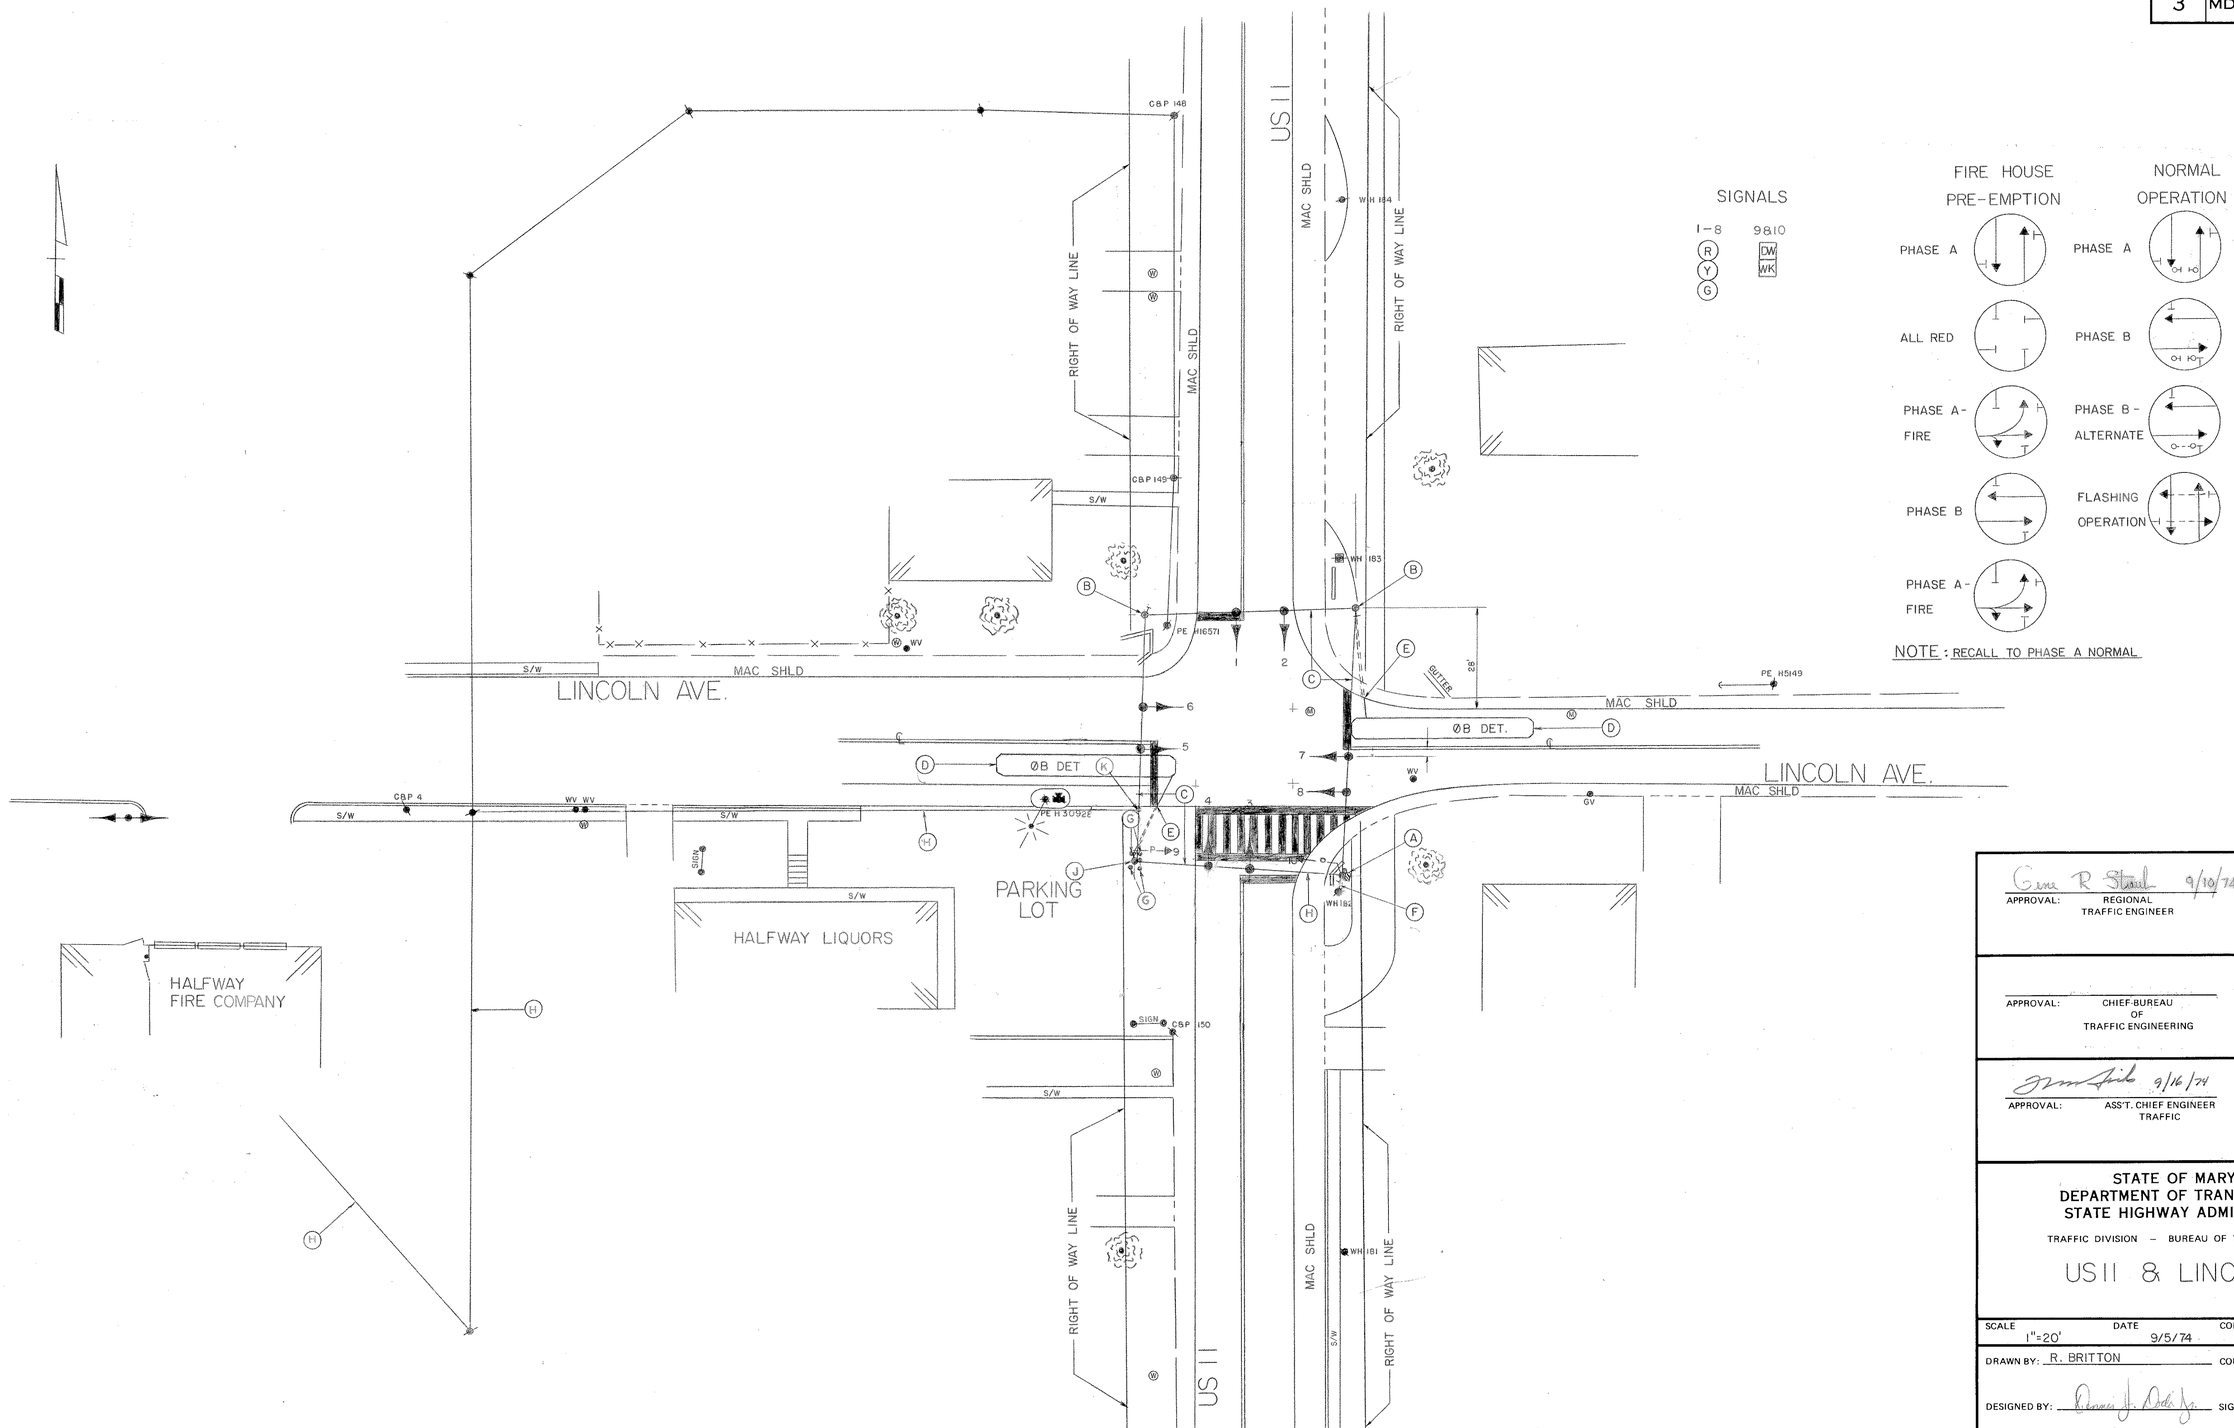

APPROVAL: REGIONAL TRAFFIC ENGINEER 9/10/74

APPROVAL: CHIEF-BUREAU OF TRAFFIC ENGINEERING

APPROVAL: ASS'T. CHIEF ENGINEER TRAFFIC 9/16/74

A ASBUILT 7/20/82 W-572X-000-685

KM: B.J. 2/1/82

REVISIONS

STATE OF MARYLAND
DEPARTMENT OF TRANSPORTATION
STATE HIGHWAY ADMINISTRATION

TRAFFIC DIVISION – BUREAU OF TRAFFIC ENGINEERING

US 11 & LINCOLN AVE.

SCALE 1"=20' DATE 9/5/74 CONTRACT NO.

DRAWN BY: R. BRITTON COUNTY: WASHINGTON

DESIGNED BY: Dennis J. Dodd Jr. SIGNAL NO.: 21038

CHECKED BY: A. Budnichick

DRAWING NO. TS-642A

BRUNING 44-511 19927