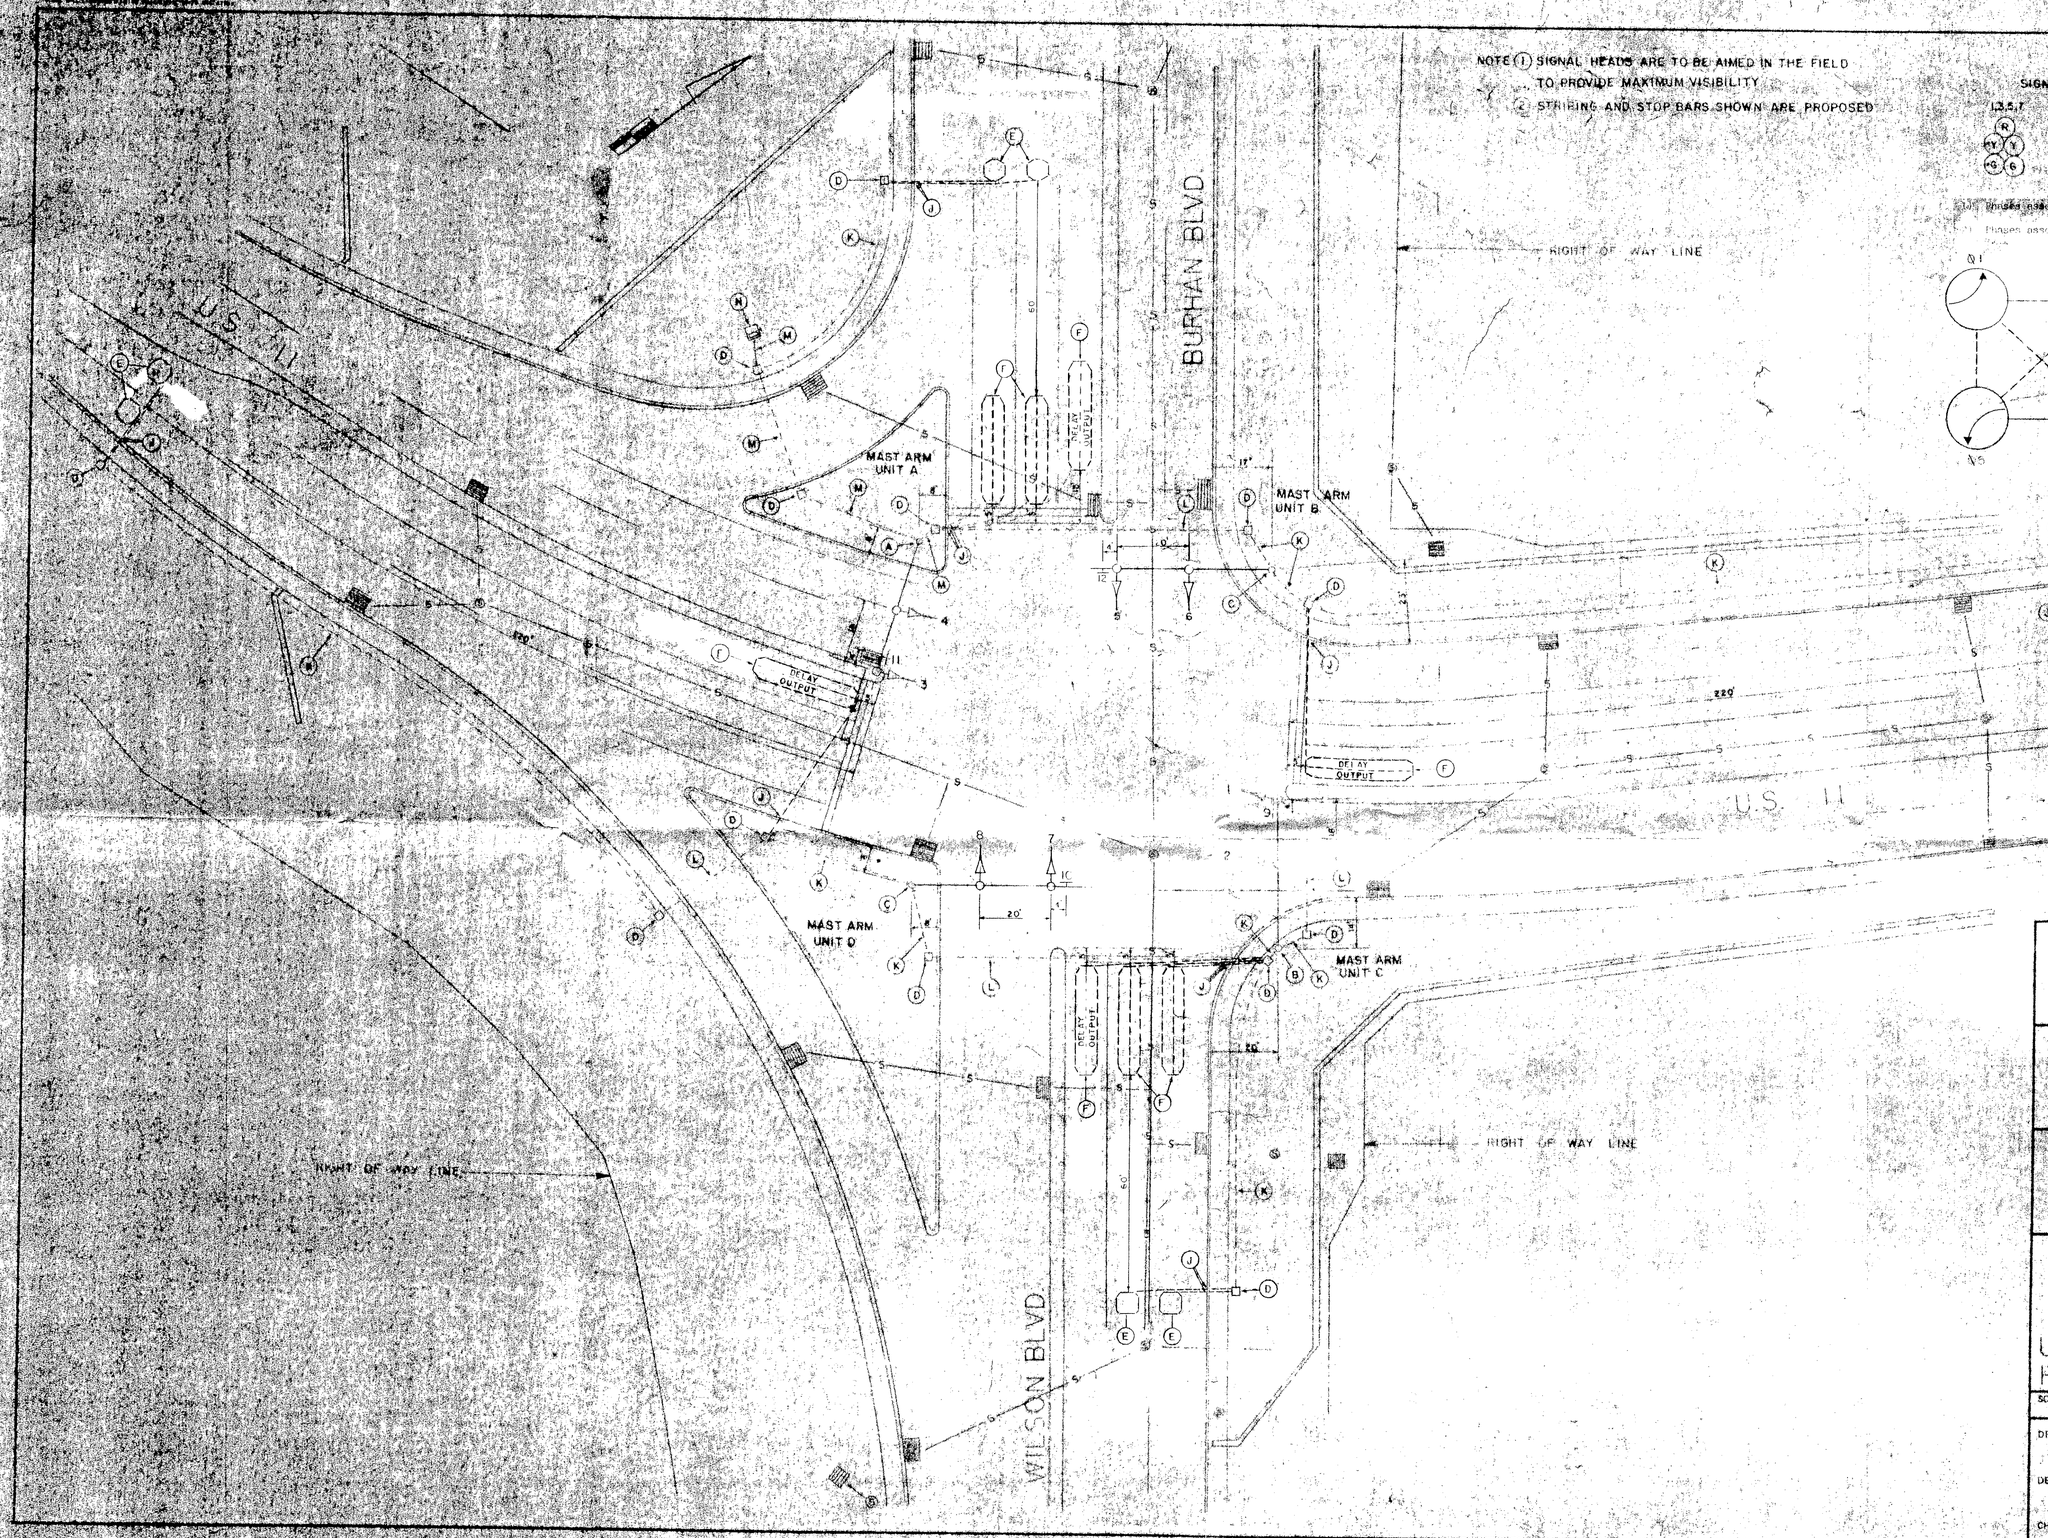

F.H.W.A. REGION NO.	STATE	FED. RD. PROJ. NO.	SHEET NO.	TOTAL SHEETS
3	MD		2	5

APPROVAL: REGIONAL TRAFFIC ENGINEER

APPROVAL: CHIEF BUREAU OF TRAFFIC ENGINEERING

APPROVAL: ASS'T. CHIEF ENGINEER TRAFFIC

A 8/23/83 REVISED PHASING AND DETECTION

JG

REVISIONS

STATE OF MARYLAND
DEPARTMENT OF TRANSPORTATION
STATE HIGHWAY ADMINISTRATION

TRAFFIC DIVISION — BUREAU OF TRAFFIC ENGINEERING

US 11 AT WILSON BLVD. & BURHANS BLVD.

SCALE 1 inch = 20 feet DATE 6-1-79 CONTRACT NO. W-446-052-671

DRAWN BY: P. KNASE COUNTY: WASHINGTON

DESIGNED BY: SIGNAL NO.:

CHECKED BY:

DRAWING NO. TS-1683

~~21001108-30~~
21001105.69