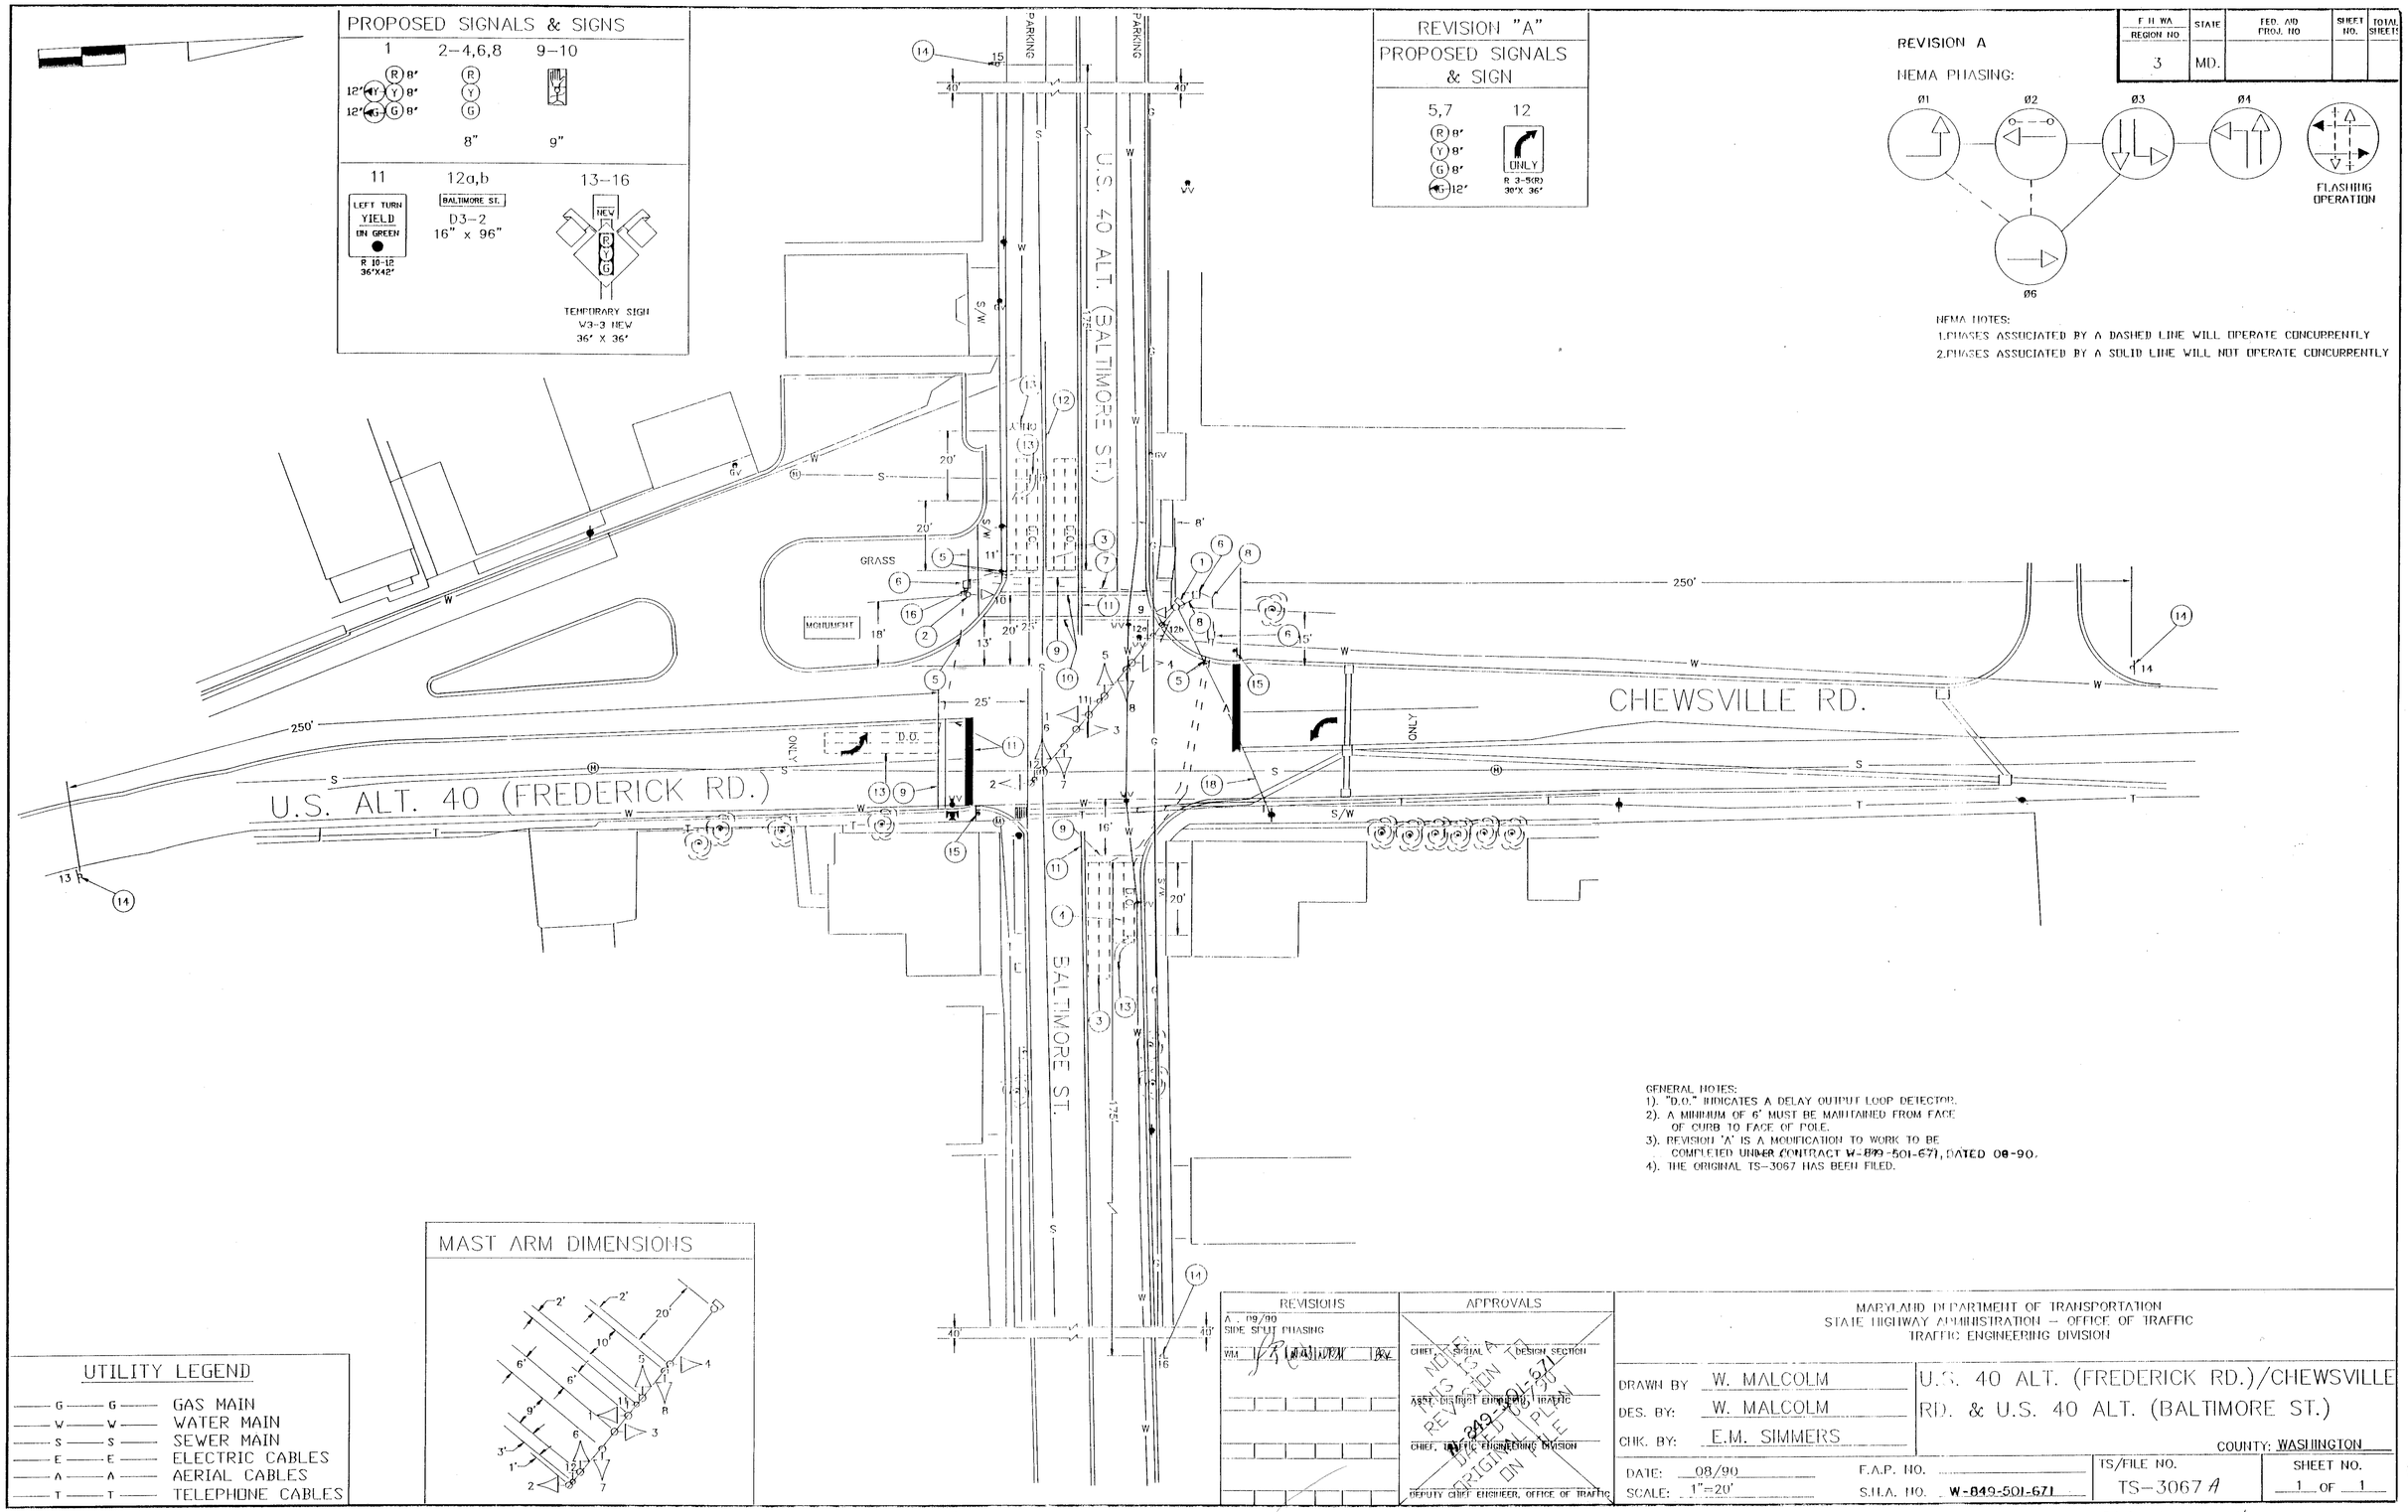

F H WA REGION NO	STATE	FED. AID PROJ. NO	SHEET NO.	TOTAL SHEETS
3	MD.			

GENERAL NOTES:
1). "D.O." INDICATES A DELAY OUTPUT LOOP DETECTOR.
2). A MINIMUM OF 6' MUST BE MAINTAINED FROM FACE OF CURB TO FACE OF POLE.
3). REVISION 'A' IS A MODIFICATION TO WORK TO BE COMPLETED UNDER CONTRACT W-849-501-671, DATED 08-90.
4). THE ORIGINAL TS-3067 HAS BEEN FILED.

21A04000.24