F.H.WA. REGION NO.	STATE	FED. AID PROJ. NO.	SHEET NO.	TOTAL SHEETS
3	MD.			

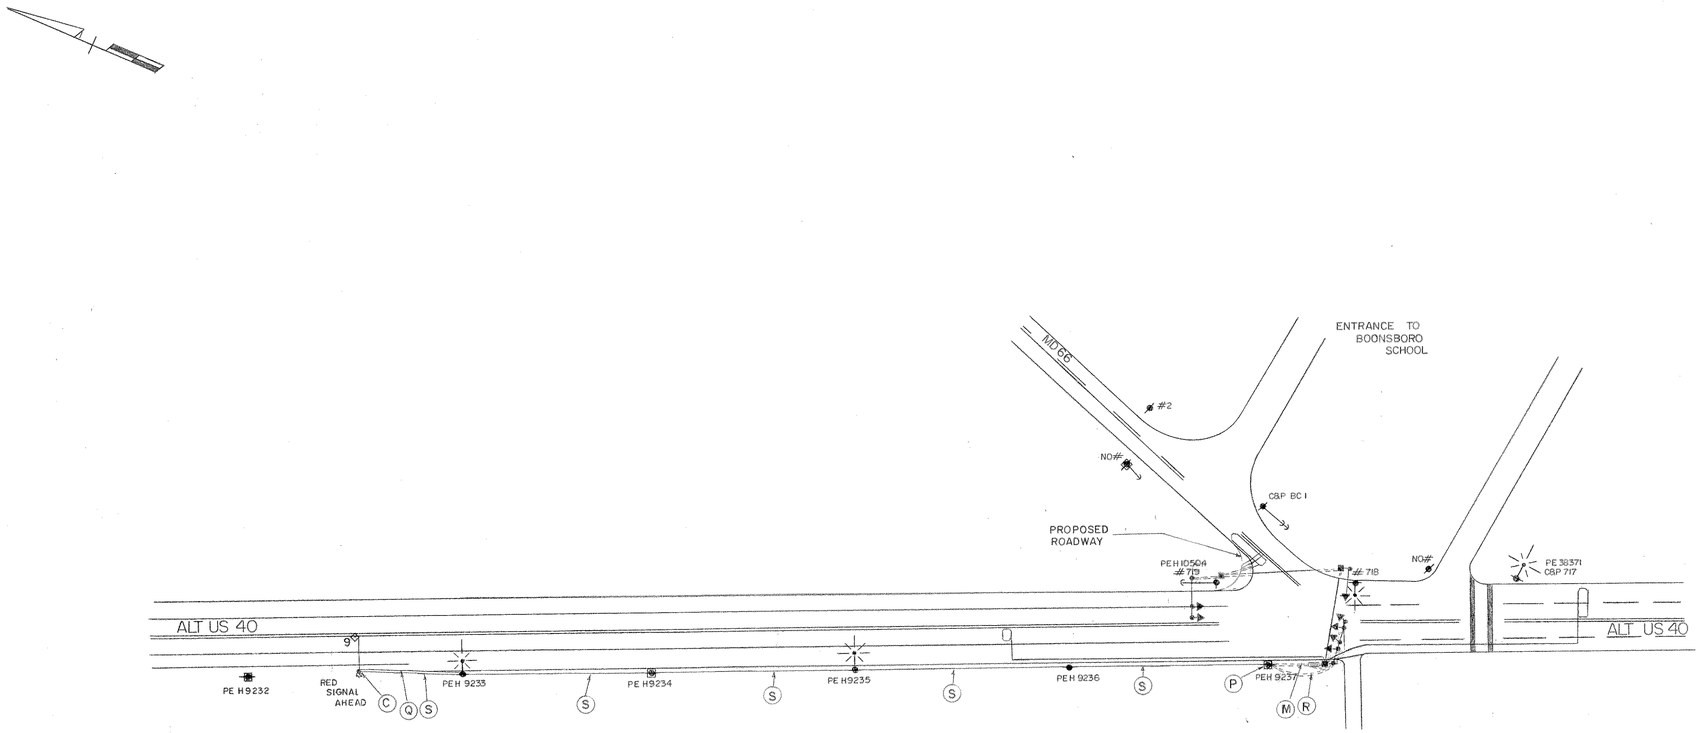

Gene R Strauch 1/22/75
APPROVAL: REGIONAL TRAFFIC ENGINEER

Edward F Paulis Jr 1/22/75
APPROVAL: CHIEF-BUREAU OF TRAFFIC ENGINEERING

[signature] 1/22/75
APPROVAL: ASS'T. CHIEF ENGINEER TRAFFIC

A ASBUILT
7-20-82
W605X-000-685
JH [signature]
REVISIONS

STATE OF MARYLAND
DEPARTMENT OF TRANSPORTATION
STATE HIGHWAY ADMINISTRATION

TRAFFIC DIVISION – BUREAU OF TRAFFIC ENGINEERING

ALT US 40 & MD 66 INTERCONNECT
FOR FLASHING RED SIGNAL AHEAD

SCALE 1" = 50' DATE 11-23-73 CONTRACT NO.

DRAWN BY: M LINARDI COUNTY: WASHINGTON

DESIGNED BY: [signature] SIGNAL NO.: 21112

CHECKED BY: A. Budnichuk 1/21/75

DRAWING NO.
TS-1055X1A

BRUNING 44-511 19927

21A 04009.85