

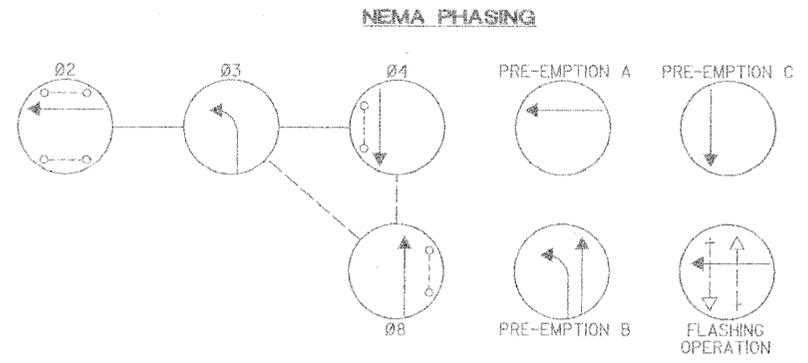


U.S. 40 WEST (WEST FRANKLIN STREET) IS ASSUMED TO RUN IN AN EAST-WEST DIRECTION.

PROPOSED VIDEO DETECTION
a,b,c

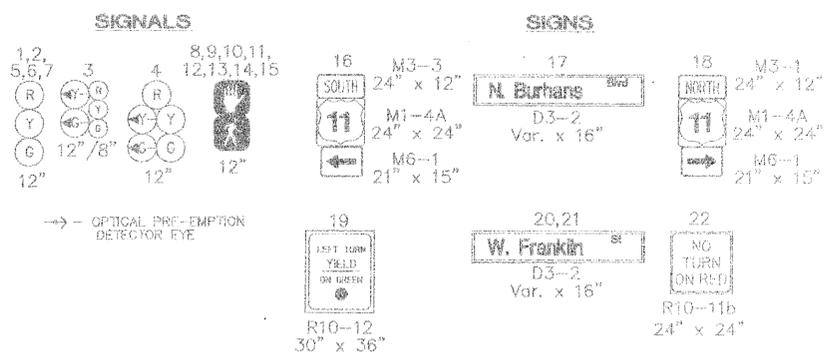

PHASING NOTES:
1. PHASES ASSOCIATED BY A SOLID LINE WILL NOT OPERATE CONCURRENTLY
2. PHASES ASSOCIATED BY A DASHED LINE WILL OPERATE CONCURRENTLY

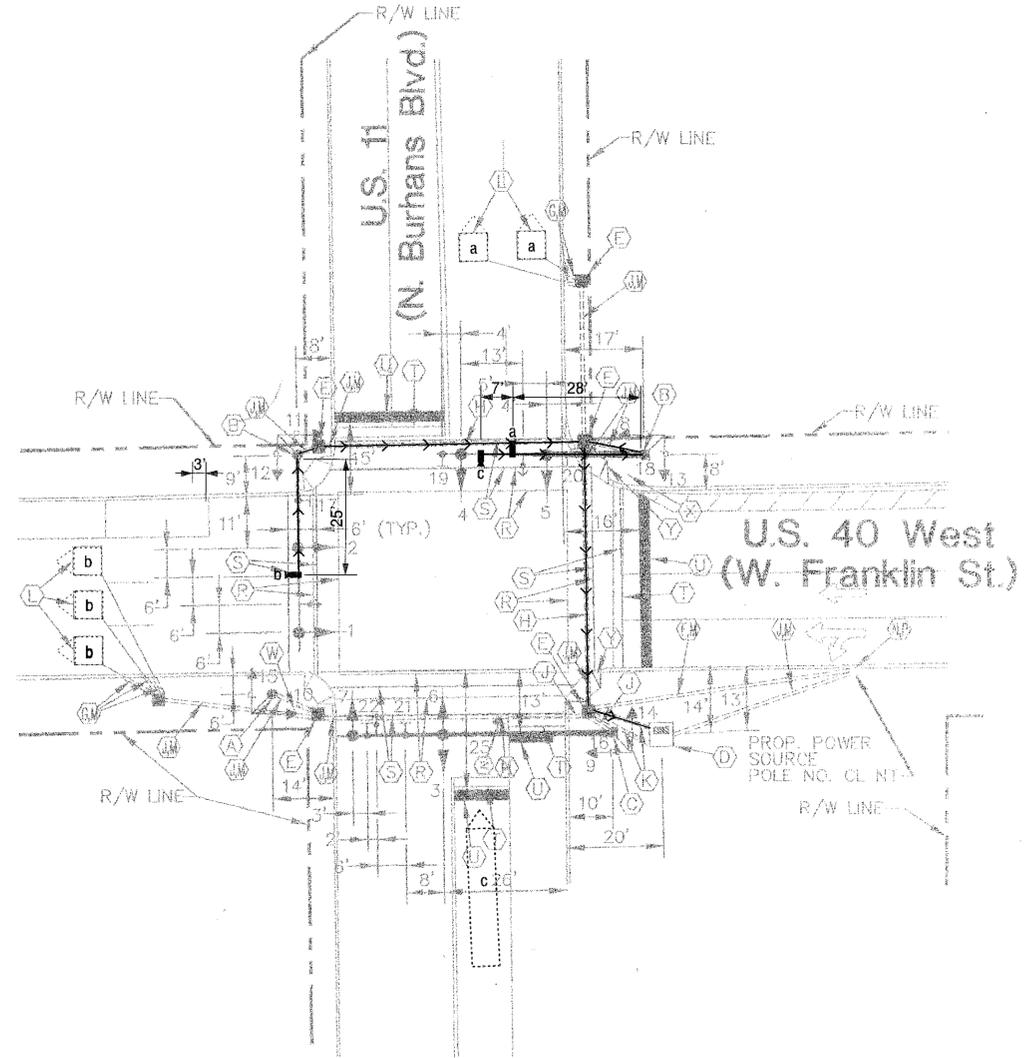


GENERAL NOTES

- VIDEO CAMERA LOCATION / ALIGNING SHALL BE COORDINATED WITH THE SHA ENGINEER.
- THE CONTRACTOR SHALL CONTACT SHA TO SCHEDULE RETROFITTING OF THE CONTROLLER EQUIPMENT IN ORDER TO OPERATE VIDEO DETECTION EQUIPMENT.
- THE CONTRACTOR SHALL BE RESPONSIBLE FOR TERMINATING ALL VIDEO DETECTION CAMERA CABLES TO THE APPROPRIATE TERMINALS AND PROPERLY LABEL EACH CABLE SO THAT SHA FORCES CAN MAKE THE FINAL CONNECTIONS.
- THE INSTALLATION OF PROPOSED VIDEO DETECTION EQUIPMENT SHALL NECESSITATE THE REMOVAL OF EXISTING CABLES ASSOCIATED WITH THE PRESENCE LOOP DETECTORS BEING REPLACED BY VIDEO DETECTION.
- ALL EXISTING TRAFFIC SIGNAL EQUIPMENT REMOVED SHALL BECOME THE PROPERTY OF THE SIGNAL CONTRACTOR UPON COMPLETION OF THE SIGNAL MODIFICATIONS.
- ALL UNUSED SIGNAL CABLES SHALL BE REMOVED AND DISPOSED.

A. EQUIPMENT TO BE SUPPLIED BY THE ADMINISTRATION.			
ITEM NO.	DESCRIPTION	UNITS	QUANTITY
9086	VIDEO DETECTION INTERFACE EQUIPMENT 1-4 CAMERAS	EA	1

B. EQUIPMENT TO BE FURNISHED AND/OR INSTALLED BY THE CONTRACTOR.			
ITEM NO.	DESCRIPTION	UNITS	QUANTITY
8058	VIDEO DETECTION CAMERA	EA	3
8009	CONTROL CABLE, 300 FOOT VIDEO DETECTION CAMERA TO CONTROLLER	EA	3

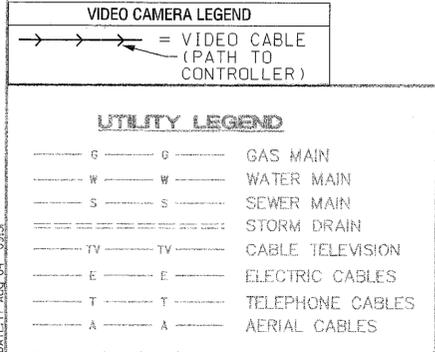

SABRA, WANG & ASSOCIATES, INC.
1504 JOH. AVENUE
SUITE 160
BALTIMORE, MD 21227
(410) 737-8564
WWW.SABRA-WANG.COM

REVISIONS	APPROVALS
① INSTALL VIDEO DETECTION 10/15/04 SHA NO. AT 10/15/04 SWA [Signature]	CHIEF, TRAFFIC ENGINEERING DESIGN DIVISION
	ASSIST. DISTRICT ENGINEER, TRAFFIC
	CHIEF, TRAFFIC ENGINEERING DESIGN DIVISION
	DIRECTOR, OFFICE OF TRAFFIC & SAFETY


SHA MDOT - STATE HIGHWAY ADMINISTRATION
Office of Traffic & Safety
TRAFFIC ENGINEERING DESIGN DIVISION LOG ML 2100H07.37

DRAWN BY: M. GESELL
DES. BY: J. LAWRENCE
CHK. BY: M. [Signature] 6-7-99

DATE: 05/30/97 F.A.P. NO. STPG-218-1(7)E TS . NO. SHEET NO. 12 OF 66
SCALE: 1" = 20' S.H.A. NO. WA9535J85 3695A

US 40 West (West Franklin St.)
at US 11 (North Burhans Blvd.)
COUNTY: WASHINGTON

FILE: F:\2005\12_2005\12\cv\cask32\cpgn\us11us40wb.dgn DATE: 12/20/05 09:53