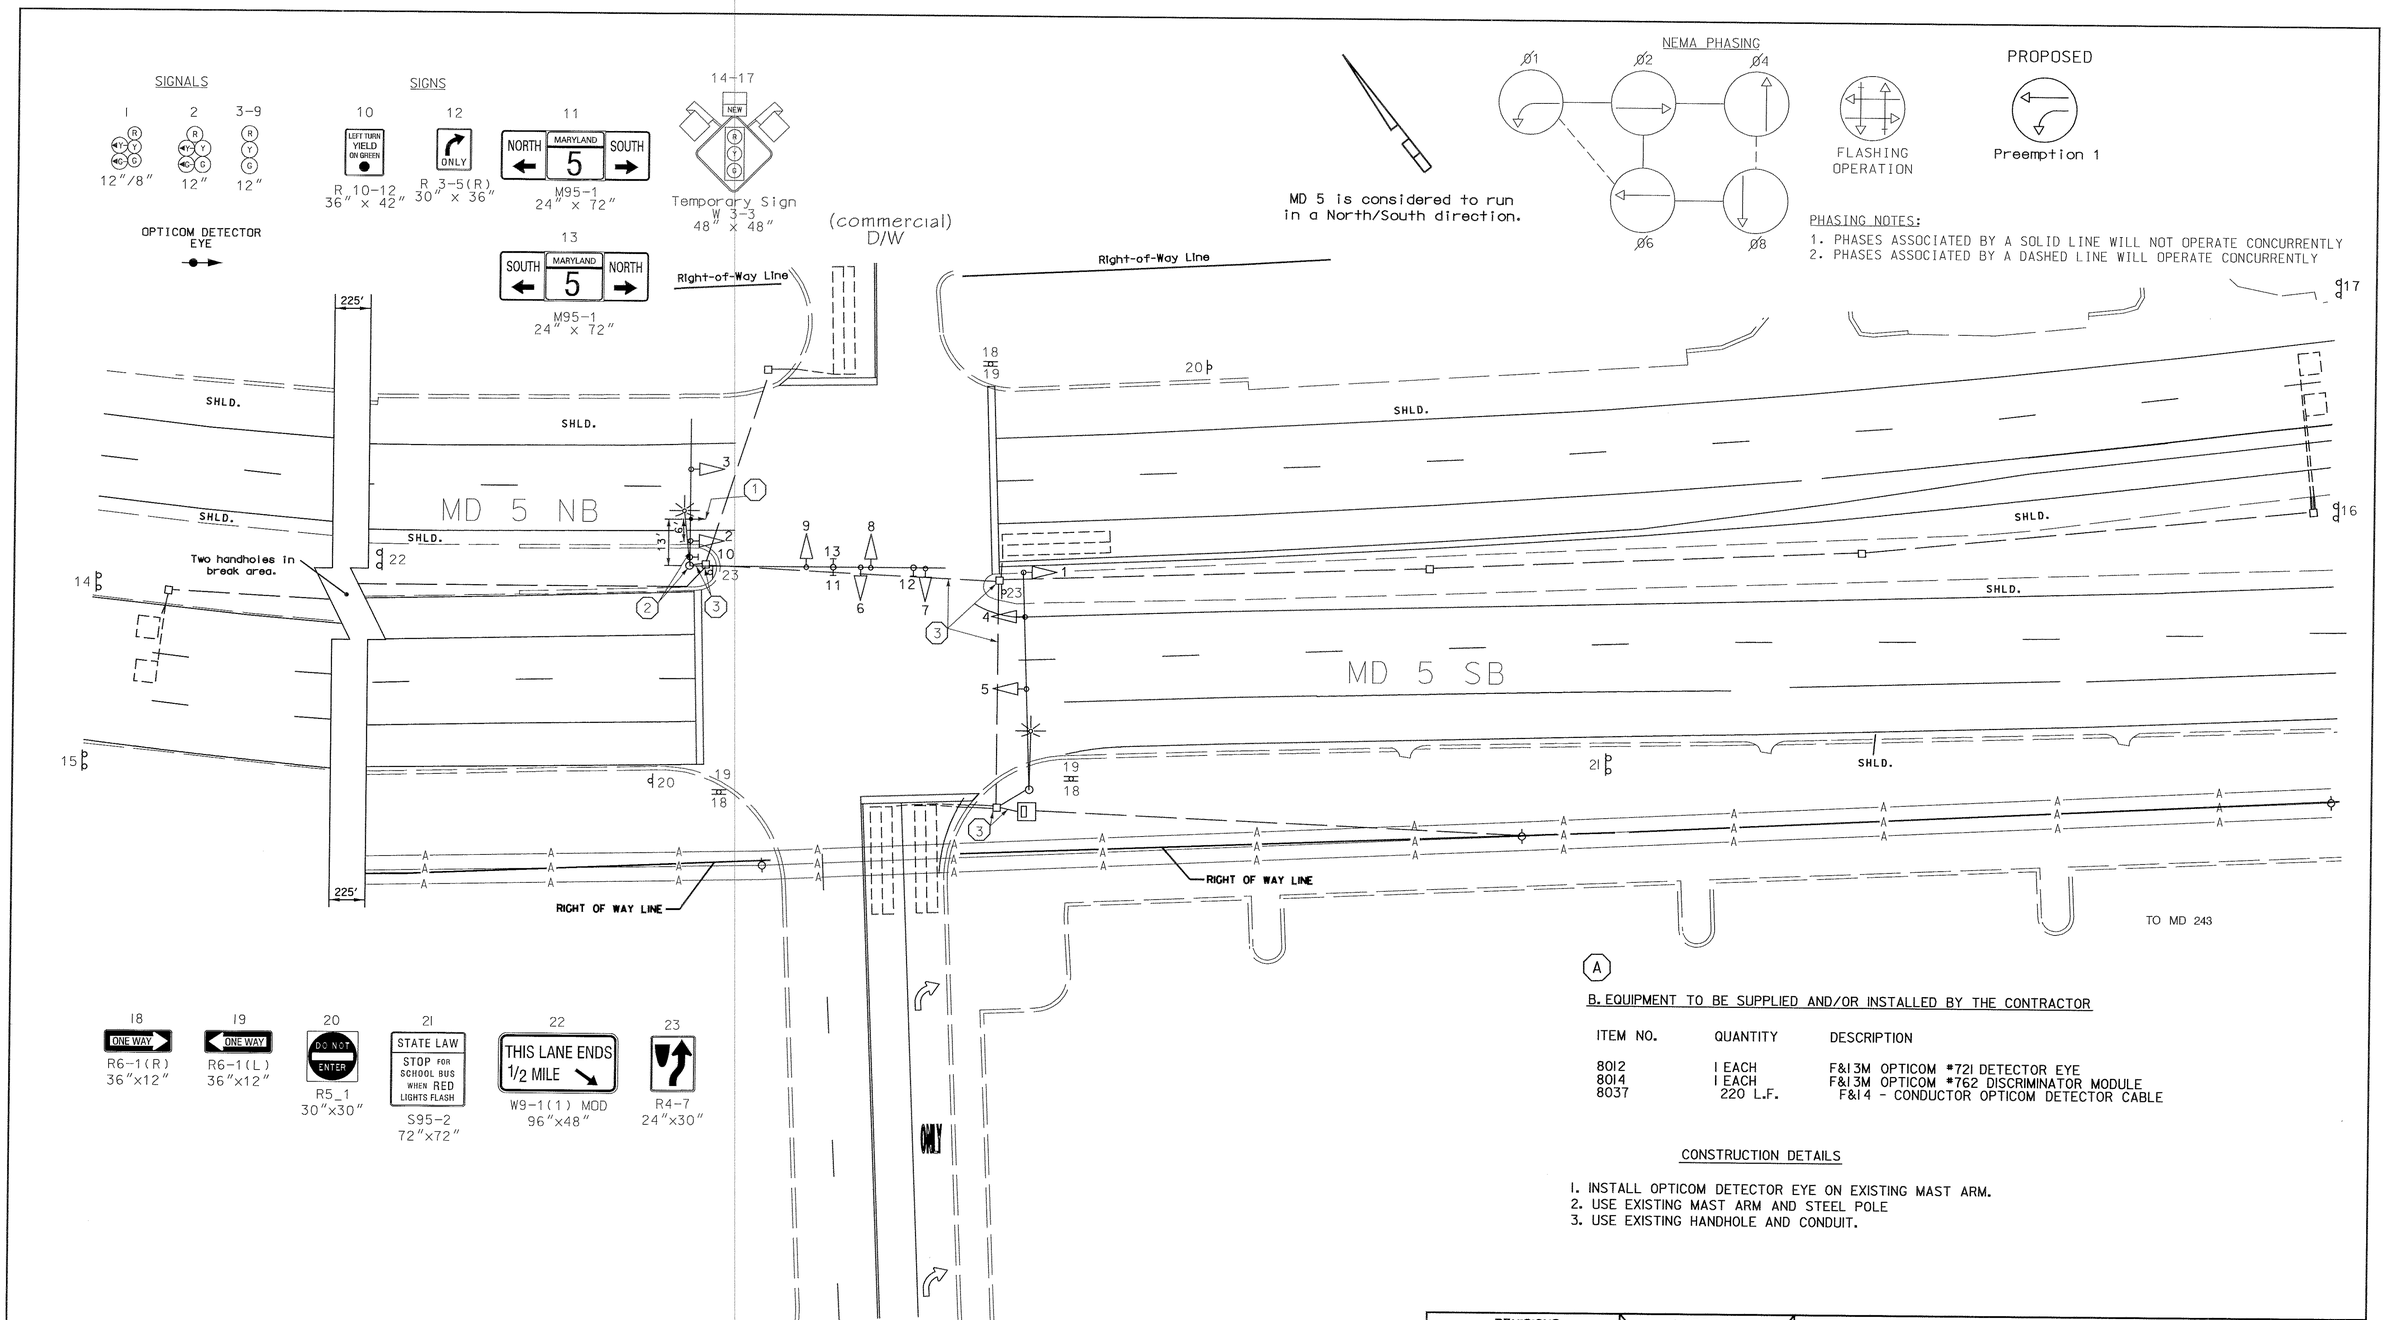


A

B. EQUIPMENT TO BE SUPPLIED AND/OR INSTALLED BY THE CONTRACTOR

| ITEM NO. | QUANTITY | DESCRIPTION |
|---|---|---|
| 8012 | 1 EACH | F&I 3M OPTICOM #721 DETECTOR EYE |
| 8014 | 1 EACH | F&I 3M OPTICOM #762 DISCRIMINATOR MODULE |
| 8037 | 220 L.F. | F&I 4 - CONDUCTOR OPTICOM DETECTOR CABLE |

CONSTRUCTION DETAILS

1. INSTALL OPTICOM DETECTOR EYE ON EXISTING MAST ARM.
2. USE EXISTING MAST ARM AND STEEL POLE
3. USE EXISTING HANDHOLE AND CONDUIT.

CENTURY ENGINEERING, INC.
CONSULTING ENGINEERS - PLANNERS
32 WEST ROAD
TOWSON, MARYLAND 21204

| REVISIONS | |
|---|---|
| A | INSTALL OPTICOM DETECTOR EYE NB MD 5 3/00 |
| CEI | |

APPROVALS
ORIGINAL
ASST. TRAFFIC ENGINEERING DESIGN DIVISION
ON
ASST. DISTRICT ENGINEER, TRAFFIC
FILE
CHIEF, TRAFFIC ENGINEERING DESIGN DIVISION
DIRECTOR, TRAFFIC & SAFETY

MARYLAND DOT - STATE HIGHWAY ADMINISTRATION
*Office of Traffic & Safety*
TRAFFIC ENGINEERING DESIGN DIVISION

MD 5 AT ENTRANCE TO SHOPS AT BRETON BAY

| | | | | | |
|---|---|---|---|---|---|
| RE-DRAWN BY: SPP | F.A.P. NO. AC-STPG-000S(683)E | TS NO. 3943 A | SHEET NO. 6 OF 6 |
| CHECKED BY: TMH | S.H.A. NO. SM7RAWALBSH | | |
| SCALE: 1"= 20' | COUNTY: ST. MARYS | T.I.M.S. NO. D690 | |
| DATE: 3/10/00 | LOG MILE: 18005031.00 | | |

cc:#crosdsgn#17006#23#d690pa06.dgn
12 APR 2000