



EXISTING SIGNS

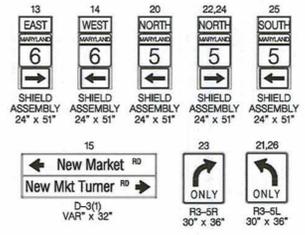


PROPOSED SIGNS

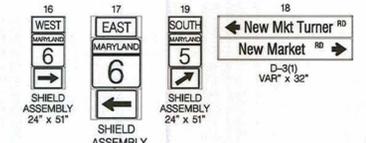


EXISTING OPTICOM DETECTOR




EXISTING SIGNALS

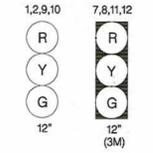

PROPOSED SIGNALS

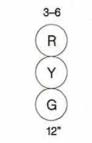

NEMA PHASING

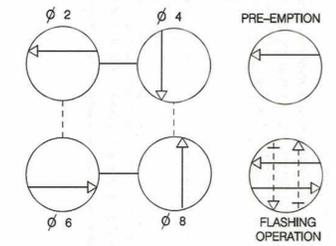

PHASING NOTES:
 1.) PHASES ASSOCIATED BY A SOLID LINE WILL NOT OPERATE CONCURRENTLY.
 2.) PHASES ASSOCIATED BY A DASHED LINE MAY OPERATE CONCURRENTLY.

CONSTRUCTION DETAILS

- A. INSTALL 27 FT. MAST ARM POLE WITH TWIN 50 FT./60 FT. MAST ARMS, SIGNAL HEADS, AND SIGNS AND 15 FT. STREET LIGHTING ARM WITH 250 WATT HPSV LUMINAIRE (NOTE: INSTALL 2-3 IN. SCHEDULE 80, RIGID PVC, 90 DEGREE CONDUIT BENDS) CUT POLE TO 21 FT. GALVANIZE AND CAP.
- B. USE EXISTING BASE MOUNTED CABINET AND CONTROLLER
- C. INSTALL ELECTRICAL HANDHOLE
- D. INSTALL 3 IN. SCHEDULE 80, RIGID PVC ELECTRICAL CONDUIT - BORED
- E. INSTALL 4 IN. SCHEDULE 80, RIGID PVC ELECTRICAL CONDUIT - TRENCHED
- F. USE EXISTING CONDUIT
- G. USE EXISTING HANDHOLE
- H. CAP AND ABANDON EXISTING CONDUIT
- I. REMOVE EXISTING HANDHOLE
- J. INSTALL 5 IN. SOLID WHITE, HEAT APPLIED, PERMANENT PREFORMED THERMOPLASTIC PAVEMENT MARKING LINE
- K. REMOVE EXISTING PAVEMENT MARKING LINE
- L. REMOVE EXISTING SIGNAL POLE AND ALL ATTACHED EQUIPMENT WITH THE EXCEPTION OF THE VIDEO DETECTION CAMERA. THE EXISTING VIDEO DETECTION CAMERA WILL BE RELOCATED AS SHOWN ON NEW MAST ARM
- M. INSTALL 24 IN. SOLID WHITE, HEAT APPLIED, PERMANENT PREFORMED THERMOPLASTIC PAVEMENT MARKING LINE
- N. INSTALL 10 IN. SOLID WHITE, HEAT APPLIED, PERMANENT PREFORMED THERMOPLASTIC PAVEMENT MARKING LINE
- O. RELOCATE EXISTING VIDEO DETECTION CAMERA TO NEW LOCATION AS SHOWN. USE EXISTING WIRING
- P. INSTALL SHIELD ASSEMBLY ON TWO-4 IN. X 4 IN. WOOD SUPPORT
- Q. REMOVE EXISTING PAVEMENT MARKING ARROW
- R. REMOVE EXISTING PAVEMENT MARKING "ONLY"

RED LINE REVISION NO. 2
 November 9, 2012

Relocate Proposed Signal Pole
 TEDD Approval: *[Signature]* 12-10-12

GENERAL NOTES

1. ALL UNDERGROUND AND OVERHEAD UTILITIES SHOWN ON THESE PLANS ARE SCHEMATIC ONLY AND MAY NOT BE COMPLETE. THE CONTRACTOR SHALL BE RESPONSIBLE FOR NOTIFYING MISS UTILITY PRIOR TO CONSTRUCTION SO THAT ALL UTILITIES MAY BE LOCATED IN THE FIELD. IF THE CONTRACTOR PERCEIVES THAT A CONFLICT BETWEEN UTILITIES AND TRAFFIC SIGNAL EQUIPMENT WILL OCCUR, THE CONTRACTOR SHALL NOTIFY THE PROJECT ENGINEER IMMEDIATELY SO THE CONFLICT MAY BE RESOLVED.
2. ALL TRAFFIC SIGNAL FOUNDATIONS SHALL BE INSTALLED AT THE FINAL SIDEWALK OR CURB GRADE FOR CLOSED SECTIONS, HIGHEST ROADWAY PROFILE GRADE FOR OPEN SECTIONS, TO MEET CLEARANCE AS SPECIFIED IN MD 816.03, MD 818.01, MD 818.02, MD 818.04. THE CONTRACTOR SHALL VERIFY ULTIMATE GRADES PRIOR TO THE INSTALLATION OF ALL SIGNAL EQUIPMENT.
3. DISCONNECT EXISTING MICRO-LOOP CABLE FROM THE EXISTING CONTROLLER AT MD 5 & MD 6 AND PULL BACK TO THIS POINT. RE-INSTALL THROUGH NEW CONDUIT TO THE EXISTING BASE MOUNTED CABINET & CONTROLLER AT THIS INTERSECTION.
4. THE LOCATION OF PROPOSED GEOMETRICS MUST BE CONFIRMED PRIOR TO THE INSTALLATION OF SIGNAL EQUIPMENT.
5. ALL EXISTING TRAFFIC SIGNAL EQUIPMENT BEING REMOVED SHALL BECOME THE PROPERTY OF THE SIGNAL CONTRACTOR UPON COMPLETION OF THE WORK.
6. THE CONTRACTOR SHALL REMOVE ALL UNUSED CABLE.
7. ALL PAVEMENT MARKINGS DETAILED SHALL BE INSTALLED IN ACCORDANCE WITH MSHA STANDARDS.
8. PRIOR TO INSTALLATION OF SIGNAL FOUNDATION AND POLE, THE CONTRACTOR SHALL VERIFY ADEQUATE CLEARANCE WITH OVERHEAD UTILITIES.

| GEOMETRIC LEGEND | |
|------------------|-----|
| EXISTING | --- |
| PROPOSED | --- |

| UTILITY LEGEND | |
|----------------|----|
| AERIAL CABLE | A |
| ELECTRICAL | E |
| TELEPHONE | T |
| GAS | G |
| SEWER | S |
| WATER | W |
| CABLE TV | TV |

TRAFFIC CONCEPTS, INC.
 325 Gambrills Road
 Suite B
 Gambrills, MD 21054
 (410) 923-7101
 FAX: (410) 923-6473
 EMAIL: TRAFFIC@TRAFFIC-CONCEPTS.COM

| APPROVALS | REVISIONS |
|-------------------------|---|
| ORIGINAL ON FILE | ① RELOCATE SIGNAL POLE DUE TO GEOMETRIC IMPROVEMENTS 7-11-12 TMS NO. L-279 SHA NO. BW-998M2 |
| | ② REPLACE SIGNAL PAVEMENT MARKINGS, DETECTION AND CHANGE LANE ASSIGNMENTS DUE TO GEOMETRIC IMPROVEMENTS 6-10-10 TMS NO. BW-998M2 |
| | ③ ADD VIDEO DETECTION 1-30-04 CONTRACT NO. AT7245185 |
| | ④ |
| | ⑤ |

SHA STATE OF MARYLAND
 DEPARTMENT OF TRANSPORTATION
 STATE HIGHWAY ADMINISTRATION
 OFFICE OF TRAFFIC & SAFETY
 TRAFFIC ENGINEERING DESIGN DIVISION
MD 5 AND MD 6
 CHARLOTTE HALL, MARYLAND

| TRAFFIC SIGNALIZATION PLAN | | | |
|----------------------------|------------|--------------|-------------|
| SCALE | 1"=30' | DATE | 6-89 |
| DESIGNED BY | D DISTANCE | COUNTY | ST. MARY'S |
| DRAWN BY | | LOGMILE | 18000545.49 |
| CHECKED BY | | T.I.M.S. NO. | |
| F.A.P. NO. | NA | TOD NO. | |
| DRAWING NO. | TS-2572 G | SHEET NO. | 1 OF 2 |