F H WA REGION NO	STATE	FED. AID PROJ. NO	SHEET NO.	TOTAL SHEETS
3	MD.			

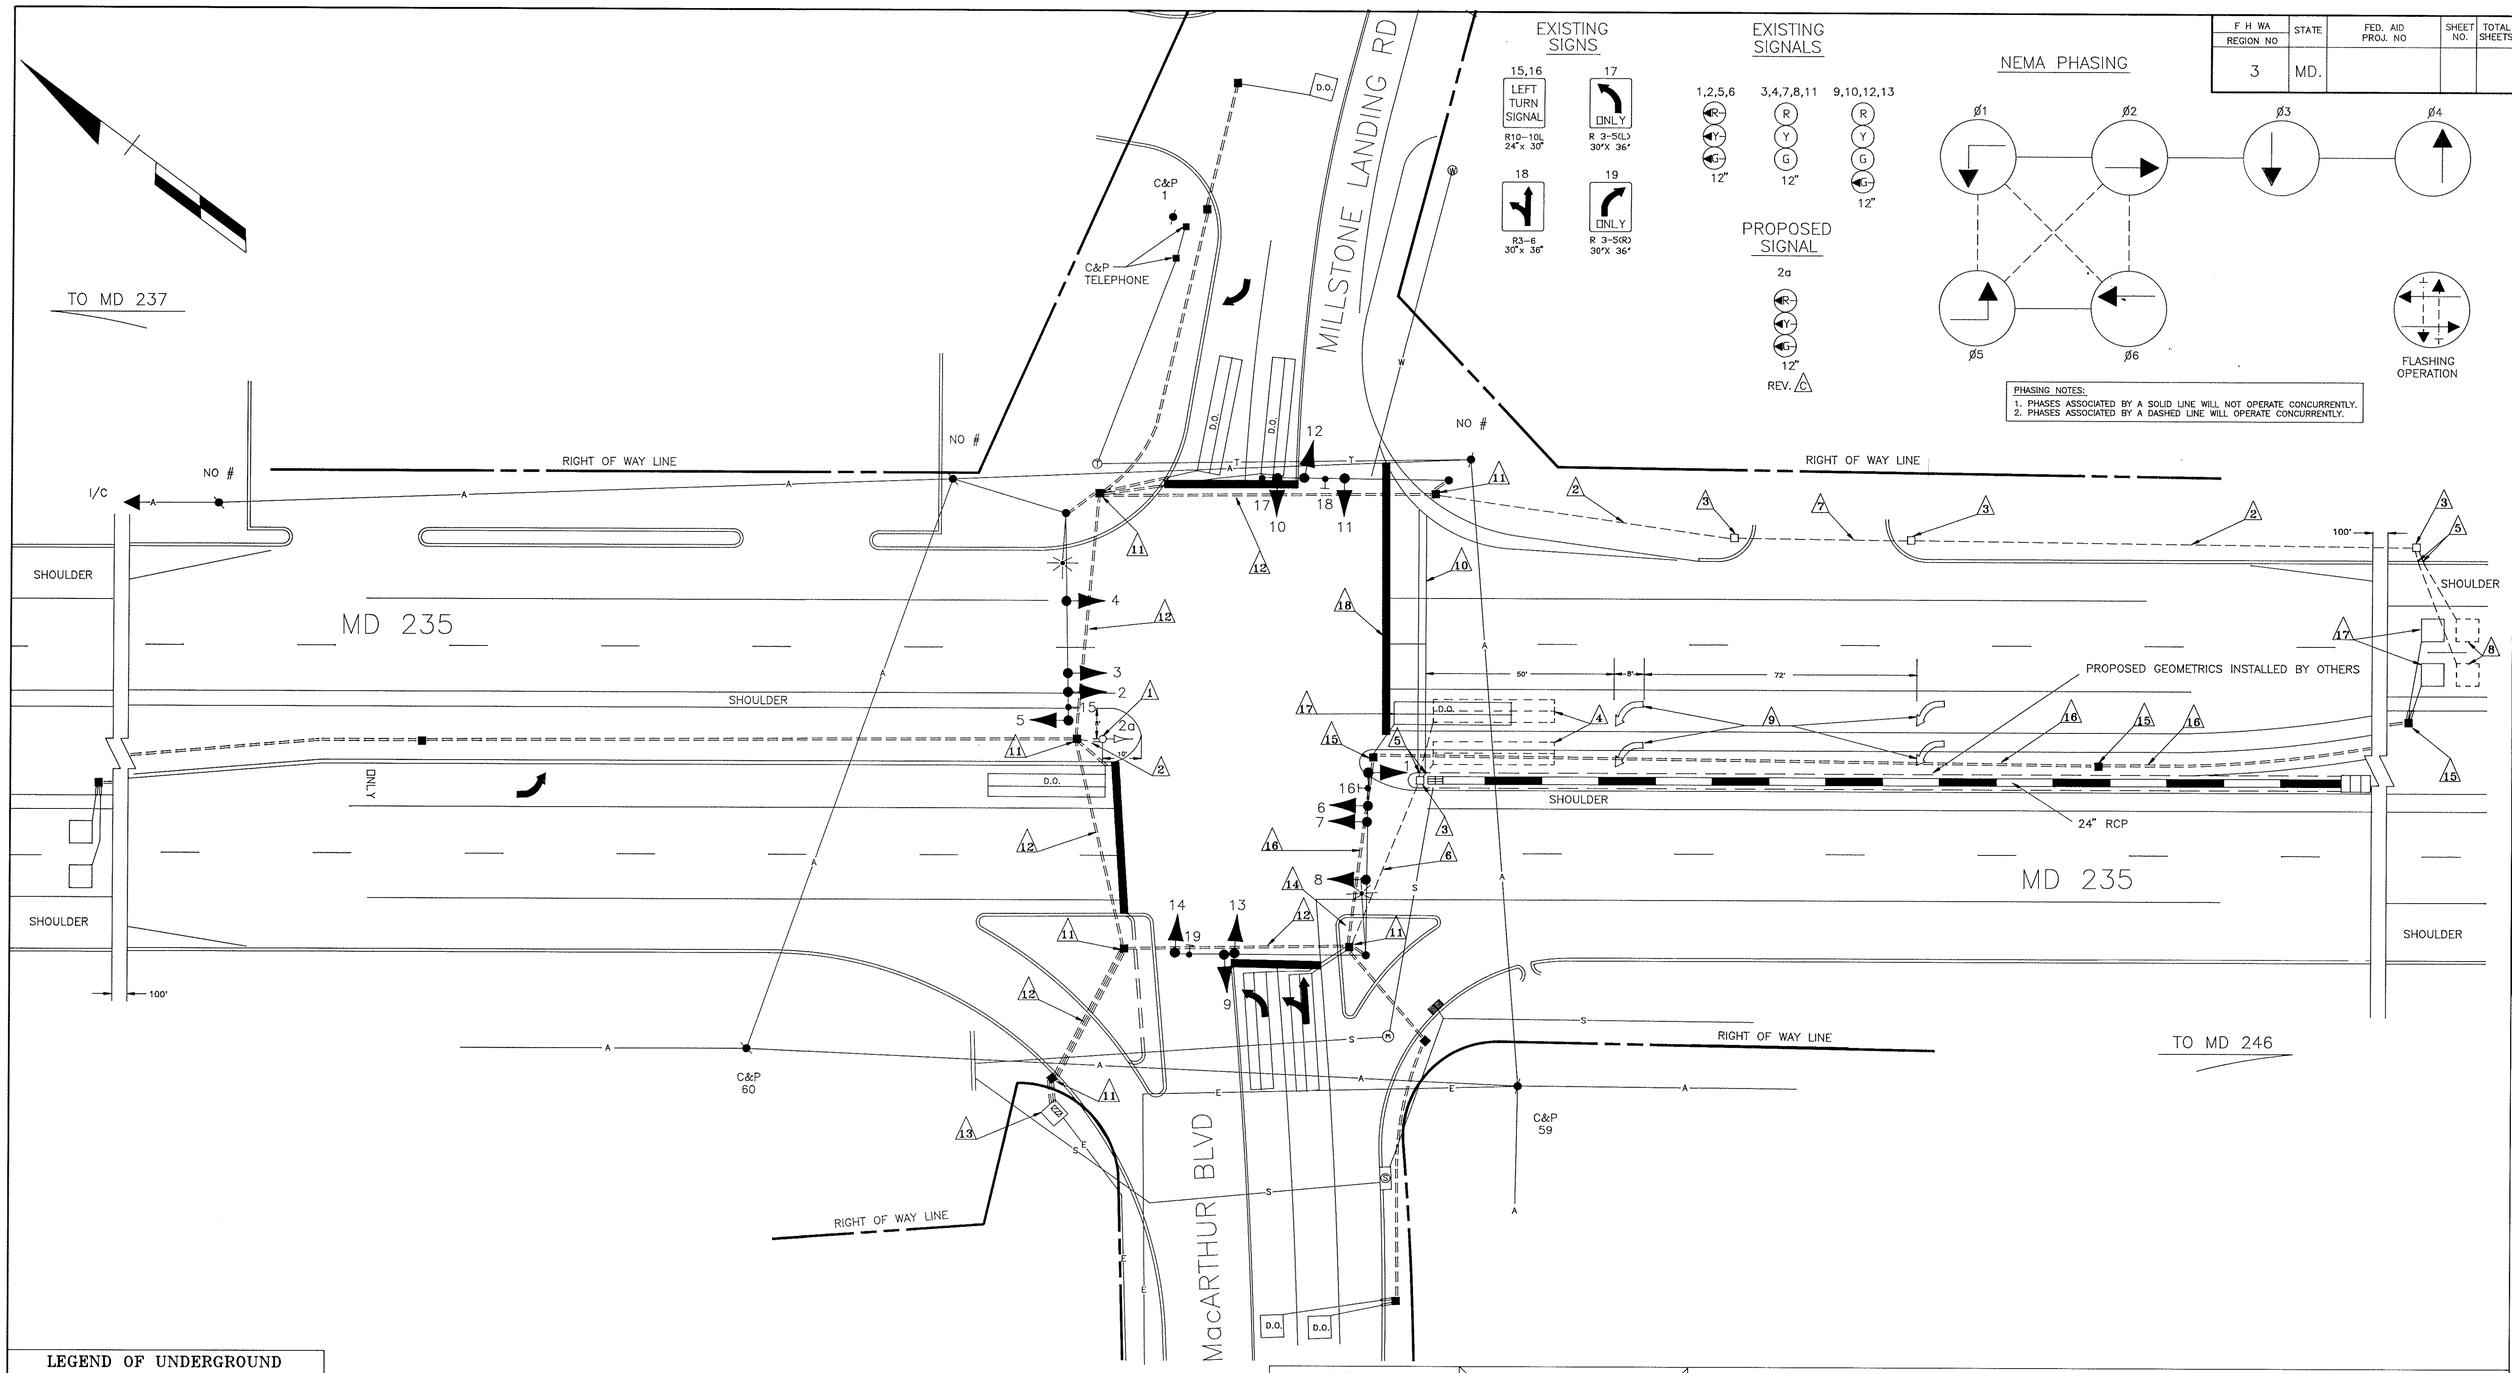

LEGEND OF UNDERGROUND AND OVERHEAD UTILITIES

AERIAL CABLES	A	A	A
ELECTRIC	E	E	E
TELEPHONE	T	T	T
GAS	G	G	G
SEWER	S	S	S
WATER	W	W	W
CABLE TV	TV	TV	TV

REVISIONS	
C 5/93	REVISED DUE TO NEW GEOMETRICS
MAR	
B 11-20-92	ADD I/C AND ASBUILT
RRZ	
A 10-22-91	SIDE STREET PHASING SPLIT
C.J.	

APPROVALS

CHIEF, SIGNAL DESIGN SECTION

ASST. DISTRICT ENGINEER, TRAFFIC

CHIEF, TRAFFIC ENGINEERING DESIGN DIVISION

DIRECTOR, OFFICE OF TRAFFIC & SAFETY

ORIGINAL ON FILE

MDOT – STATE HIGHWAY ADMINISTRATION

OFFICE OF TRAFFIC & SAFETY

TRAFFIC ENGINEERING DESIGN DIVISION

LOG MILE: 18023514.45

DRAWN BY:

DES. BY: T ZAYDEL

CHK. BY: T ZAYDEL

MD 235 & MacARTHUR BLVD / MILLSTONE LANDING RD

SIGNAL #

COUNTY: ST. MARYS

DATE: 4-1-87

SCALE: 1" = 20'

F.A.P. NO.

S.H.A. NO. BW-930-801-512

TS/STD. NO. TS-2320 C

SHEET NO. ___ OF ___

18023514.45