WIRING DIAGRAM 1

WIRING KEY

- A B C D E F G J OO PP — 7-CONDUCTOR ELECTRICAL CABLE (NO. 14 A.W.G.)
- H K L M N O P Q — 5-CONDUCTOR ELECTRICAL CABLE (NO. 14 A.W.G.)
- R S T U V W — 2-CONDUCTOR ELECTRICAL CABLE (NO. 14 A.W.G.)
- X Y Z AA — VIDEO DETECTION LEAD-IN CABLE
- BB CC — 2-CONDUCTOR ELECTRICAL CABLE (NO. 12 A.W.G.)
- DD EE FF — 1-CONDUCTOR ELECTRICAL CABLE (NO.4 A.W.G.)
- GG HH JJ KK — MICROLOOP PROBE LEAD-IN
- LL MM — 4-CONDUCTOR OPTICOM DETECTOR CABLE (NO. 14 A.W.G.)
- NN — STRANDED BARE COPPER GROUND WIRE (NO. 6 A.W.G.)
- + – 3/4 IN. X 10 FT. GROUND ROD
- PS – PROPOSED UNDERGROUND ELECTRICAL SERVICE
- PT – PROPOSED UNDERGROUND ELECTRICAL SERVICE

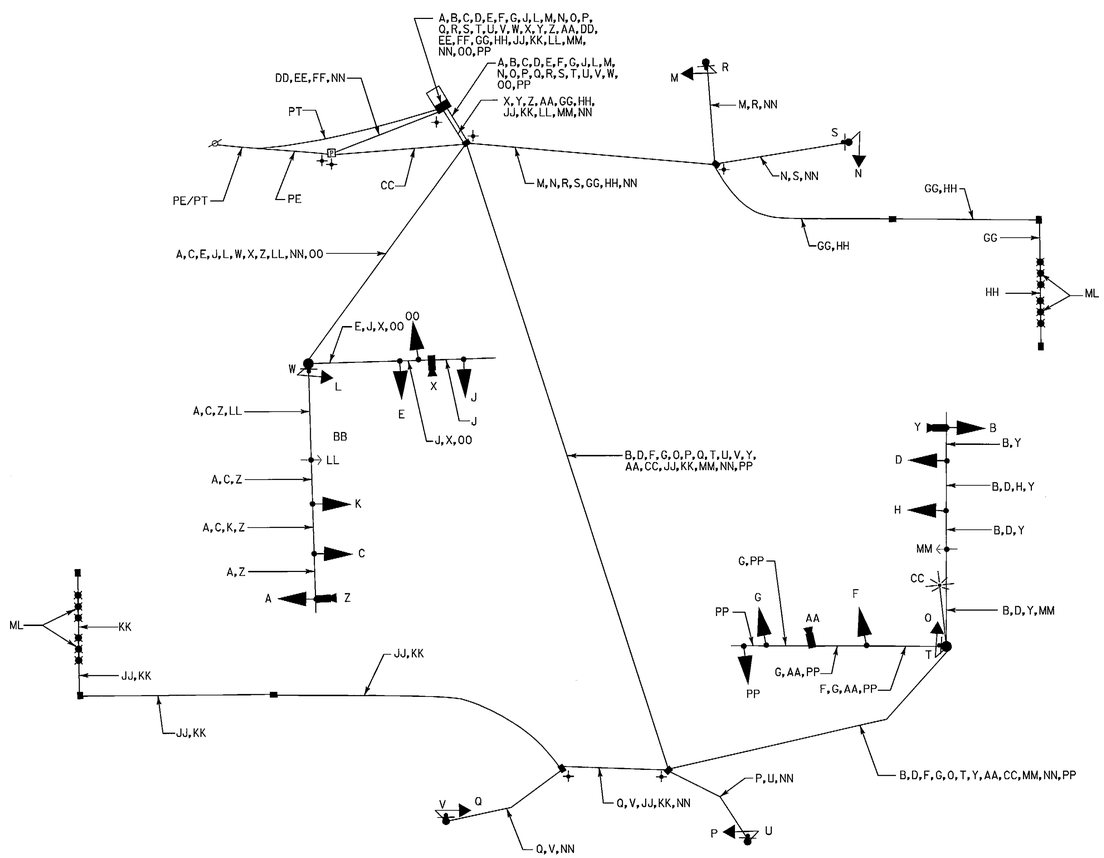

WR&A
Whitman, Requardt and Associates, LLP
Engineers, Architects and Planners
801 South Caroline Street
Baltimore, Maryland 21231
410-235-3450

BY: Sbloss

DIMENSION DIAGRAM

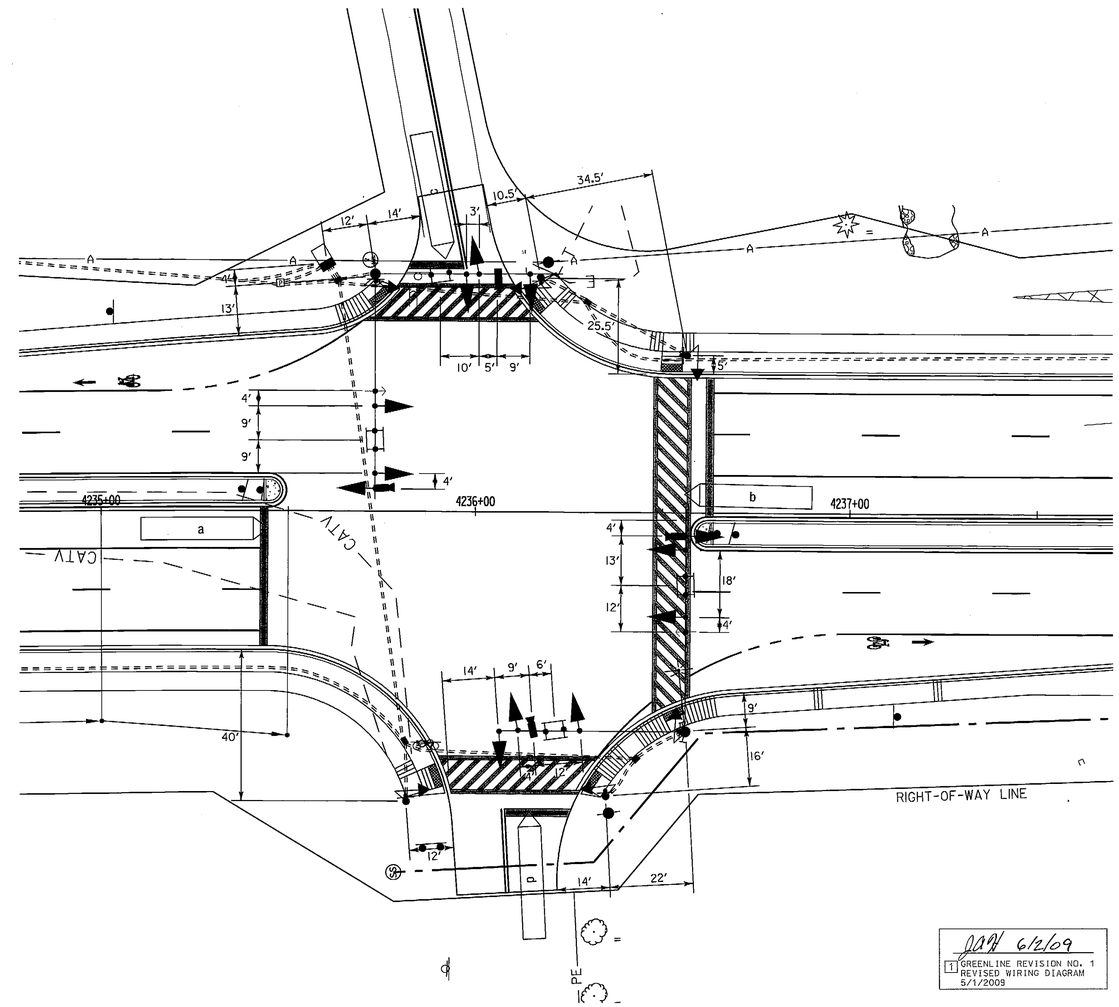

DAH 6/2/09
1 GREENLINE REVISION NO. 1
REVISED WIRING DIAGRAM
5/1/2009

STATE OF MARYLAND
DEPARTMENT OF TRANSPORTATION
STATE HIGHWAY ADMINISTRATION
OFFICE OF TRAFFIC & SAFETY
TRAFFIC ENGINEERING DESIGN DIVISION

MD 237 AND CHANCELLORS RUN PARK ENTRANCE/HORSEHEAD ROAD

GENERAL INFORMATION SHEET

SCALE NONE ADVERTISED DATE OCTOBER 6, 2008 CONTRACT NO. SM7575171

DESIGNED BY	B. DONOWAY	COUNTY	ST MARYS
DRAWN BY	B. DONOWAY	LOGMILE	18023701.33
CHECKED BY	N. LEARY	TIMS NO.	H783
F.A.P. NO.	SEE TITLE SHEET	TOD NO.	

TS NO. 4657 | DRAWING TSP – 2 OF 3 | SHEET NO. 3 OF 8

PLOTTED: 05-04-2009
FILE: n:\31628-000\cadd\Greenline Revision 1\p5G-N004a_md237-Zone3-GL1.dgn