K&E BALTIMORE 17 0153 PHOENIX 10-75 MC 4156

F.H.W.A. REGION NO.	STATE	FED. AID PROJ. NO.	SHEET NO.	TOTAL SHEETS
3	MD.		2	5

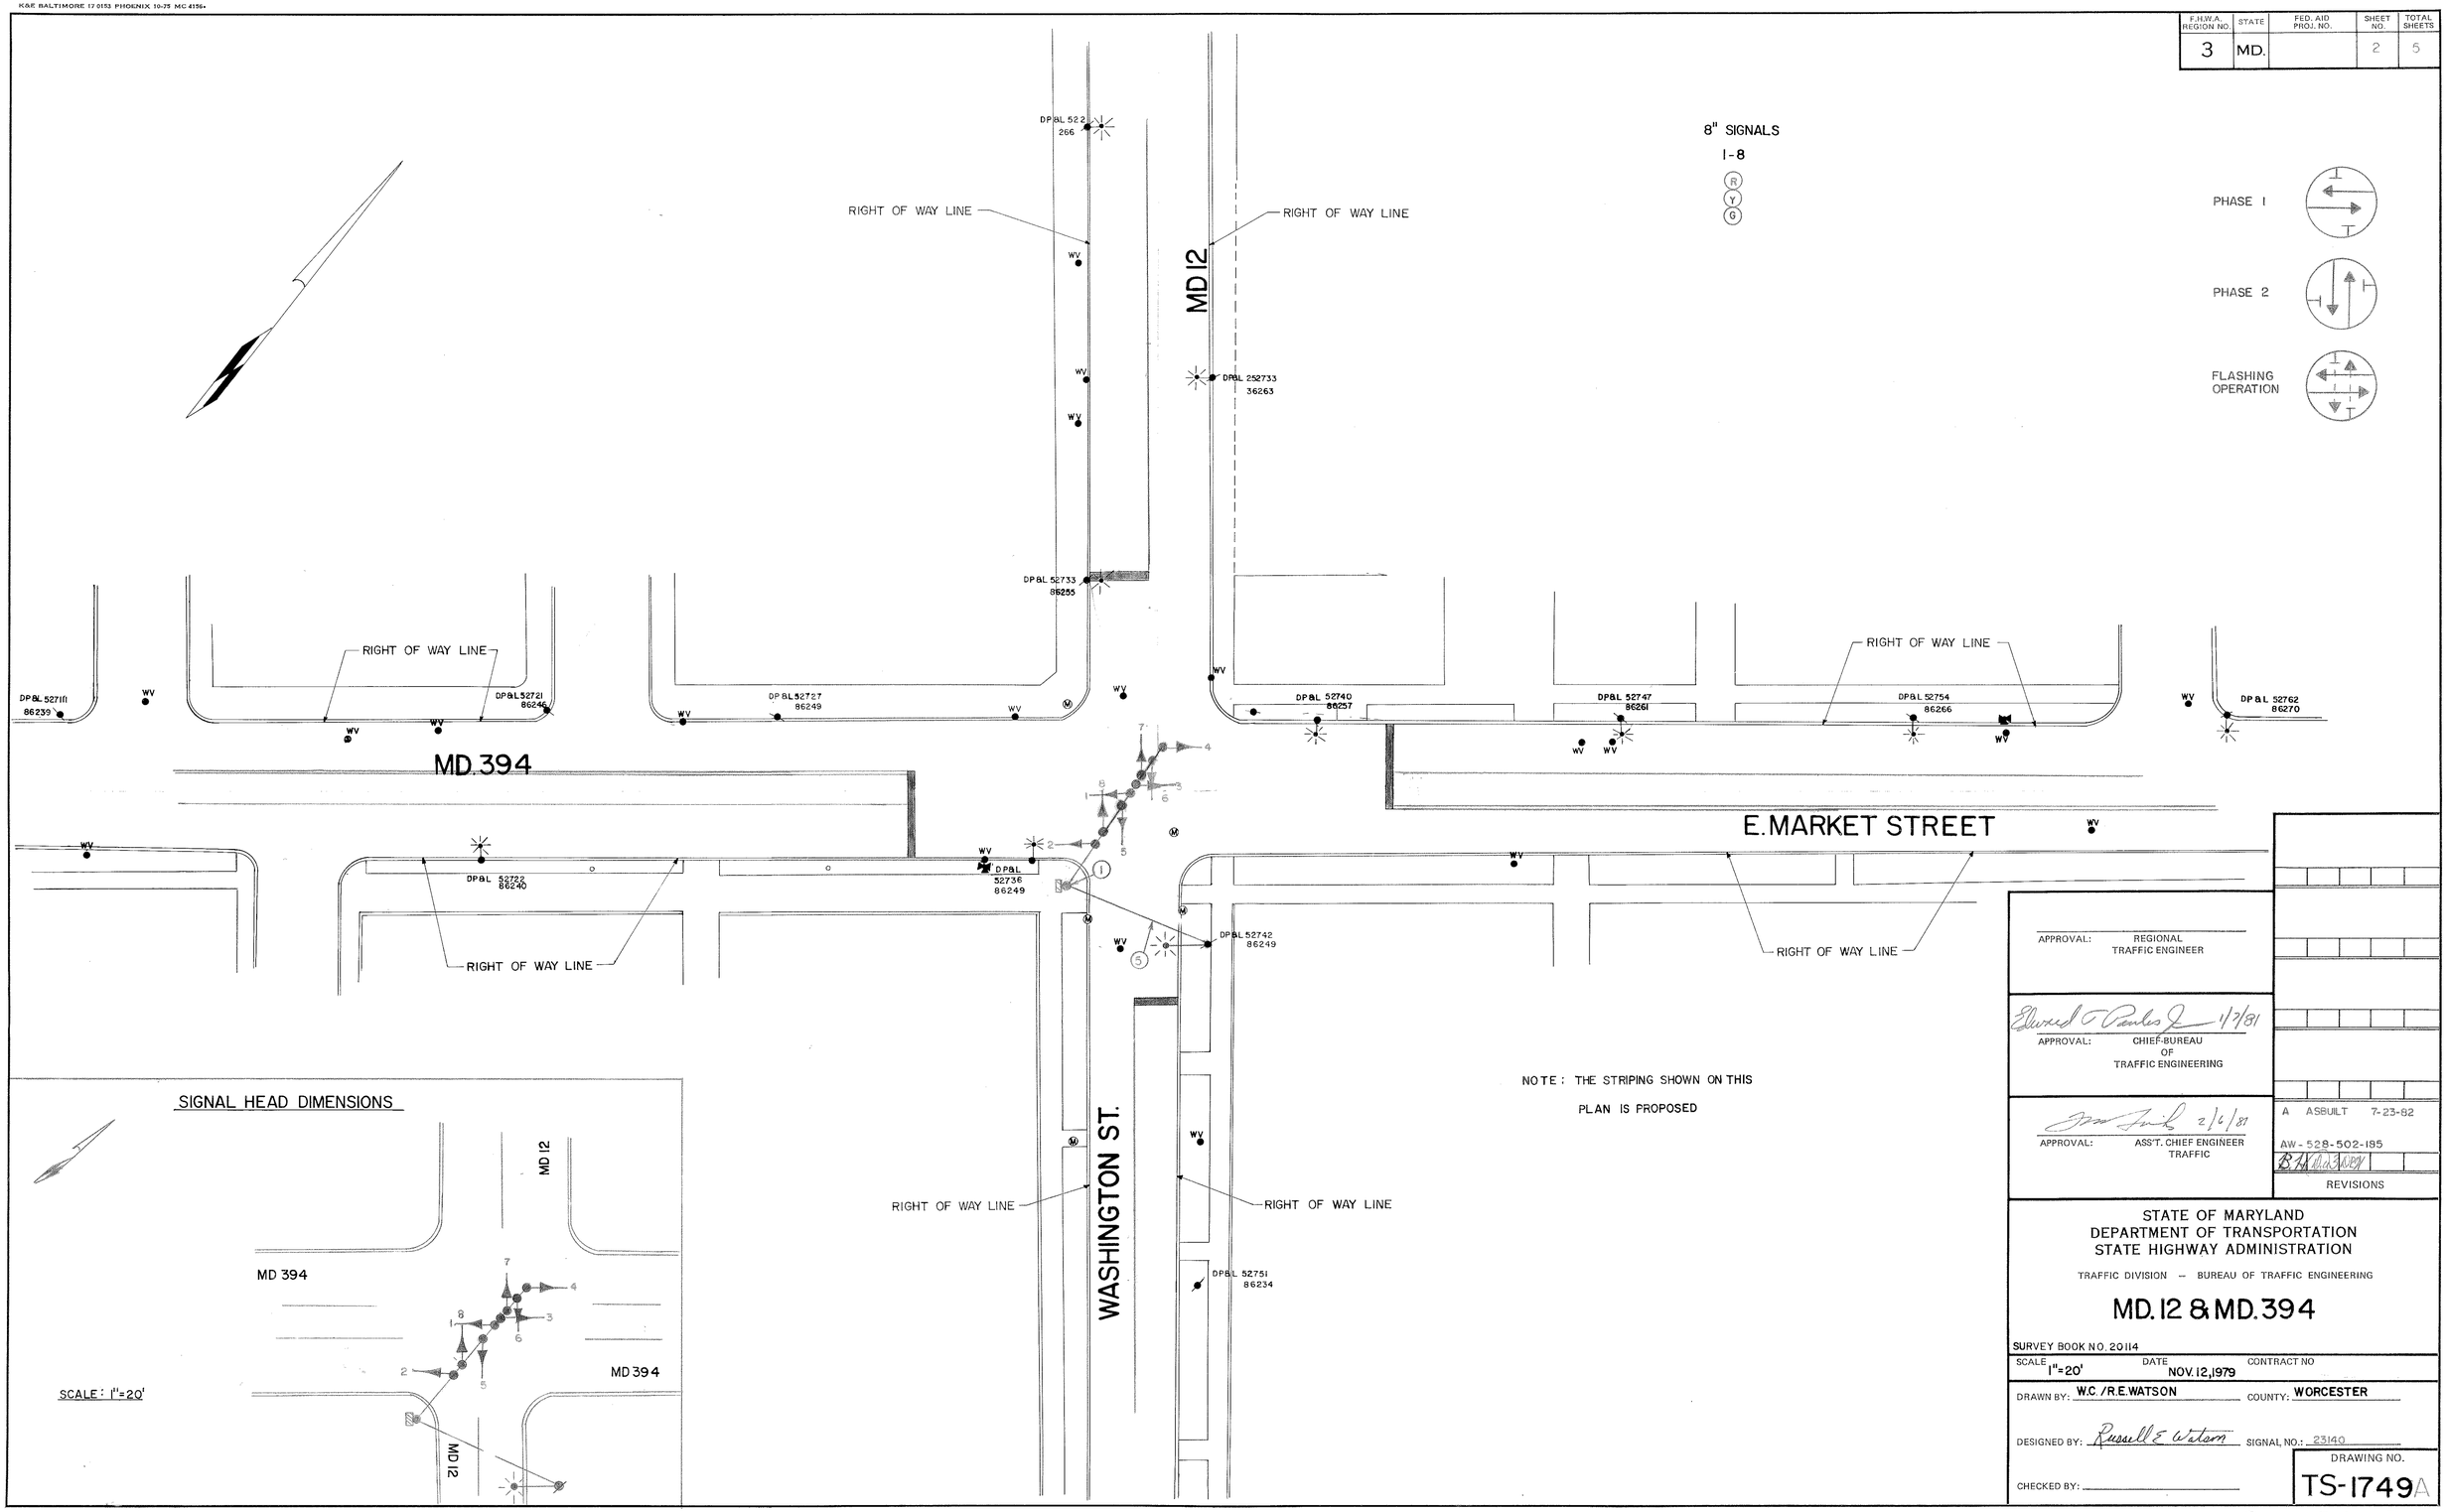

APPROVAL: REGIONAL TRAFFIC ENGINEER

Edward T. Pawlas Jr. 1/7/81
APPROVAL: CHIEF-BUREAU OF TRAFFIC ENGINEERING

2/6/81
APPROVAL: ASS'T. CHIEF ENGINEER TRAFFIC

A ASBUILT 7-23-82
AW-528-502-185
REVISIONS

STATE OF MARYLAND
DEPARTMENT OF TRANSPORTATION
STATE HIGHWAY ADMINISTRATION

TRAFFIC DIVISION – BUREAU OF TRAFFIC ENGINEERING

MD. 12 & MD. 394

SURVEY BOOK NO. 20114

SCALE 1"=20' DATE NOV. 12, 1979 CONTRACT NO

DRAWN BY: W.C. /R.E. WATSON COUNTY: WORCESTER

DESIGNED BY: Russell E. Watson SIGNAL NO.: 23140

CHECKED BY:

DRAWING NO. TS-1749A