FHWA REGION NO.	STATE	FED. AID PROJ. NO.	SHEET NO.	TOTAL SHEETS
3	MD			

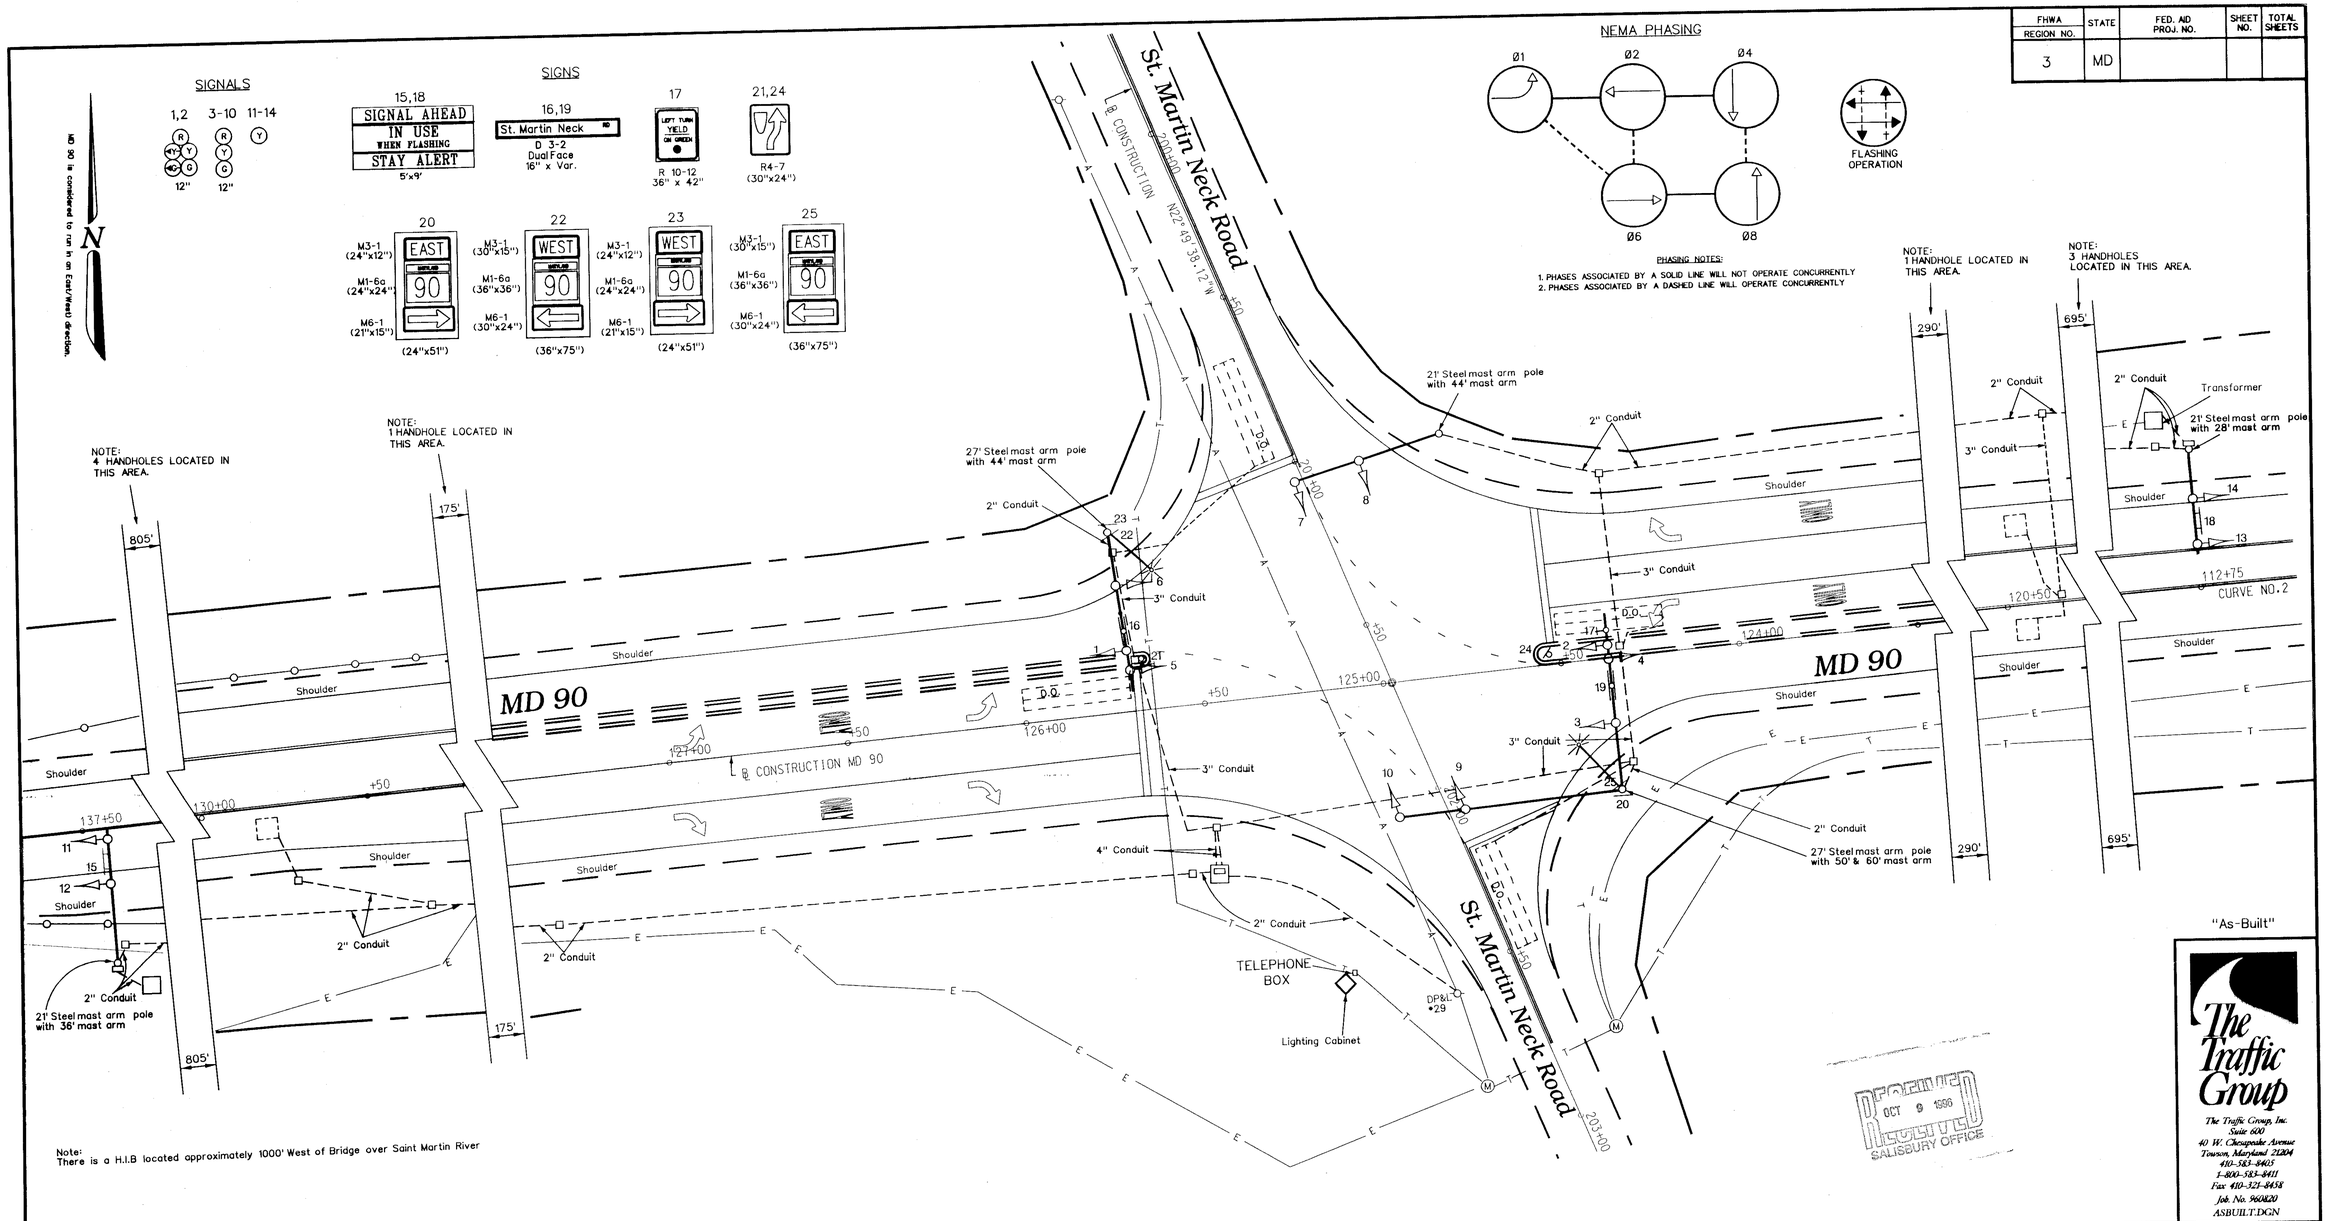

Note:
There is a H.I.B located approximately 1000' West of Bridge over Saint Martin River

GEOMETRIC LEGEND

EXISTING GEOMETRICS
PROPOSED GEOMETRICS

UTILITY LEGEND

G	GAS MAIN
W	WATER MAIN
S	SEWER MAIN
E	ELECTRIC CABLES
D	STORM DRAIN
A	AERIAL CABLES
T	TELEPHONE CABLES

REVISIONS

© SEPTEMBER 27, 1996
AS-BUILT

APPROVALS

ASST. DIVISION CHIEF TRAFFIC ENGINEERING DESIGN DIVISION
CHIEF, TRAFFIC ENGINEERING DESIGN DIVISION
ASST. DISTRICT ENGINEER - TRAFFIC
DIRECTOR, OFFICE OF TRAFFIC & SAFETY
ORIGINAL ON FILE

MDOT – STATE HIGHWAY ADMINISTRATION
Office of Traffic & Safety
TRAFFIC ENGINEERING DESIGN DIVISION

DRAWN BY: B. Thompson
DES. BY:
CHK. BY: A. Budnichuk

(Traffic Signal Plan)

MD 90 at St. Martin Neck Road

COUNTY: Worcester
LOG MILE • 23009009.53

DATE:
SCALE: 1" = 20'
F.A.P. NO.
S.H.A. NO. WO-506x-000-185

TS/STD. NO. *1377C*

SHEET NO. 1 of 1