F H W A REGION NO.	STATE	FED. AID PROJ. NO.	SHEET NO.	TOTAL SHEETS
3	MD			

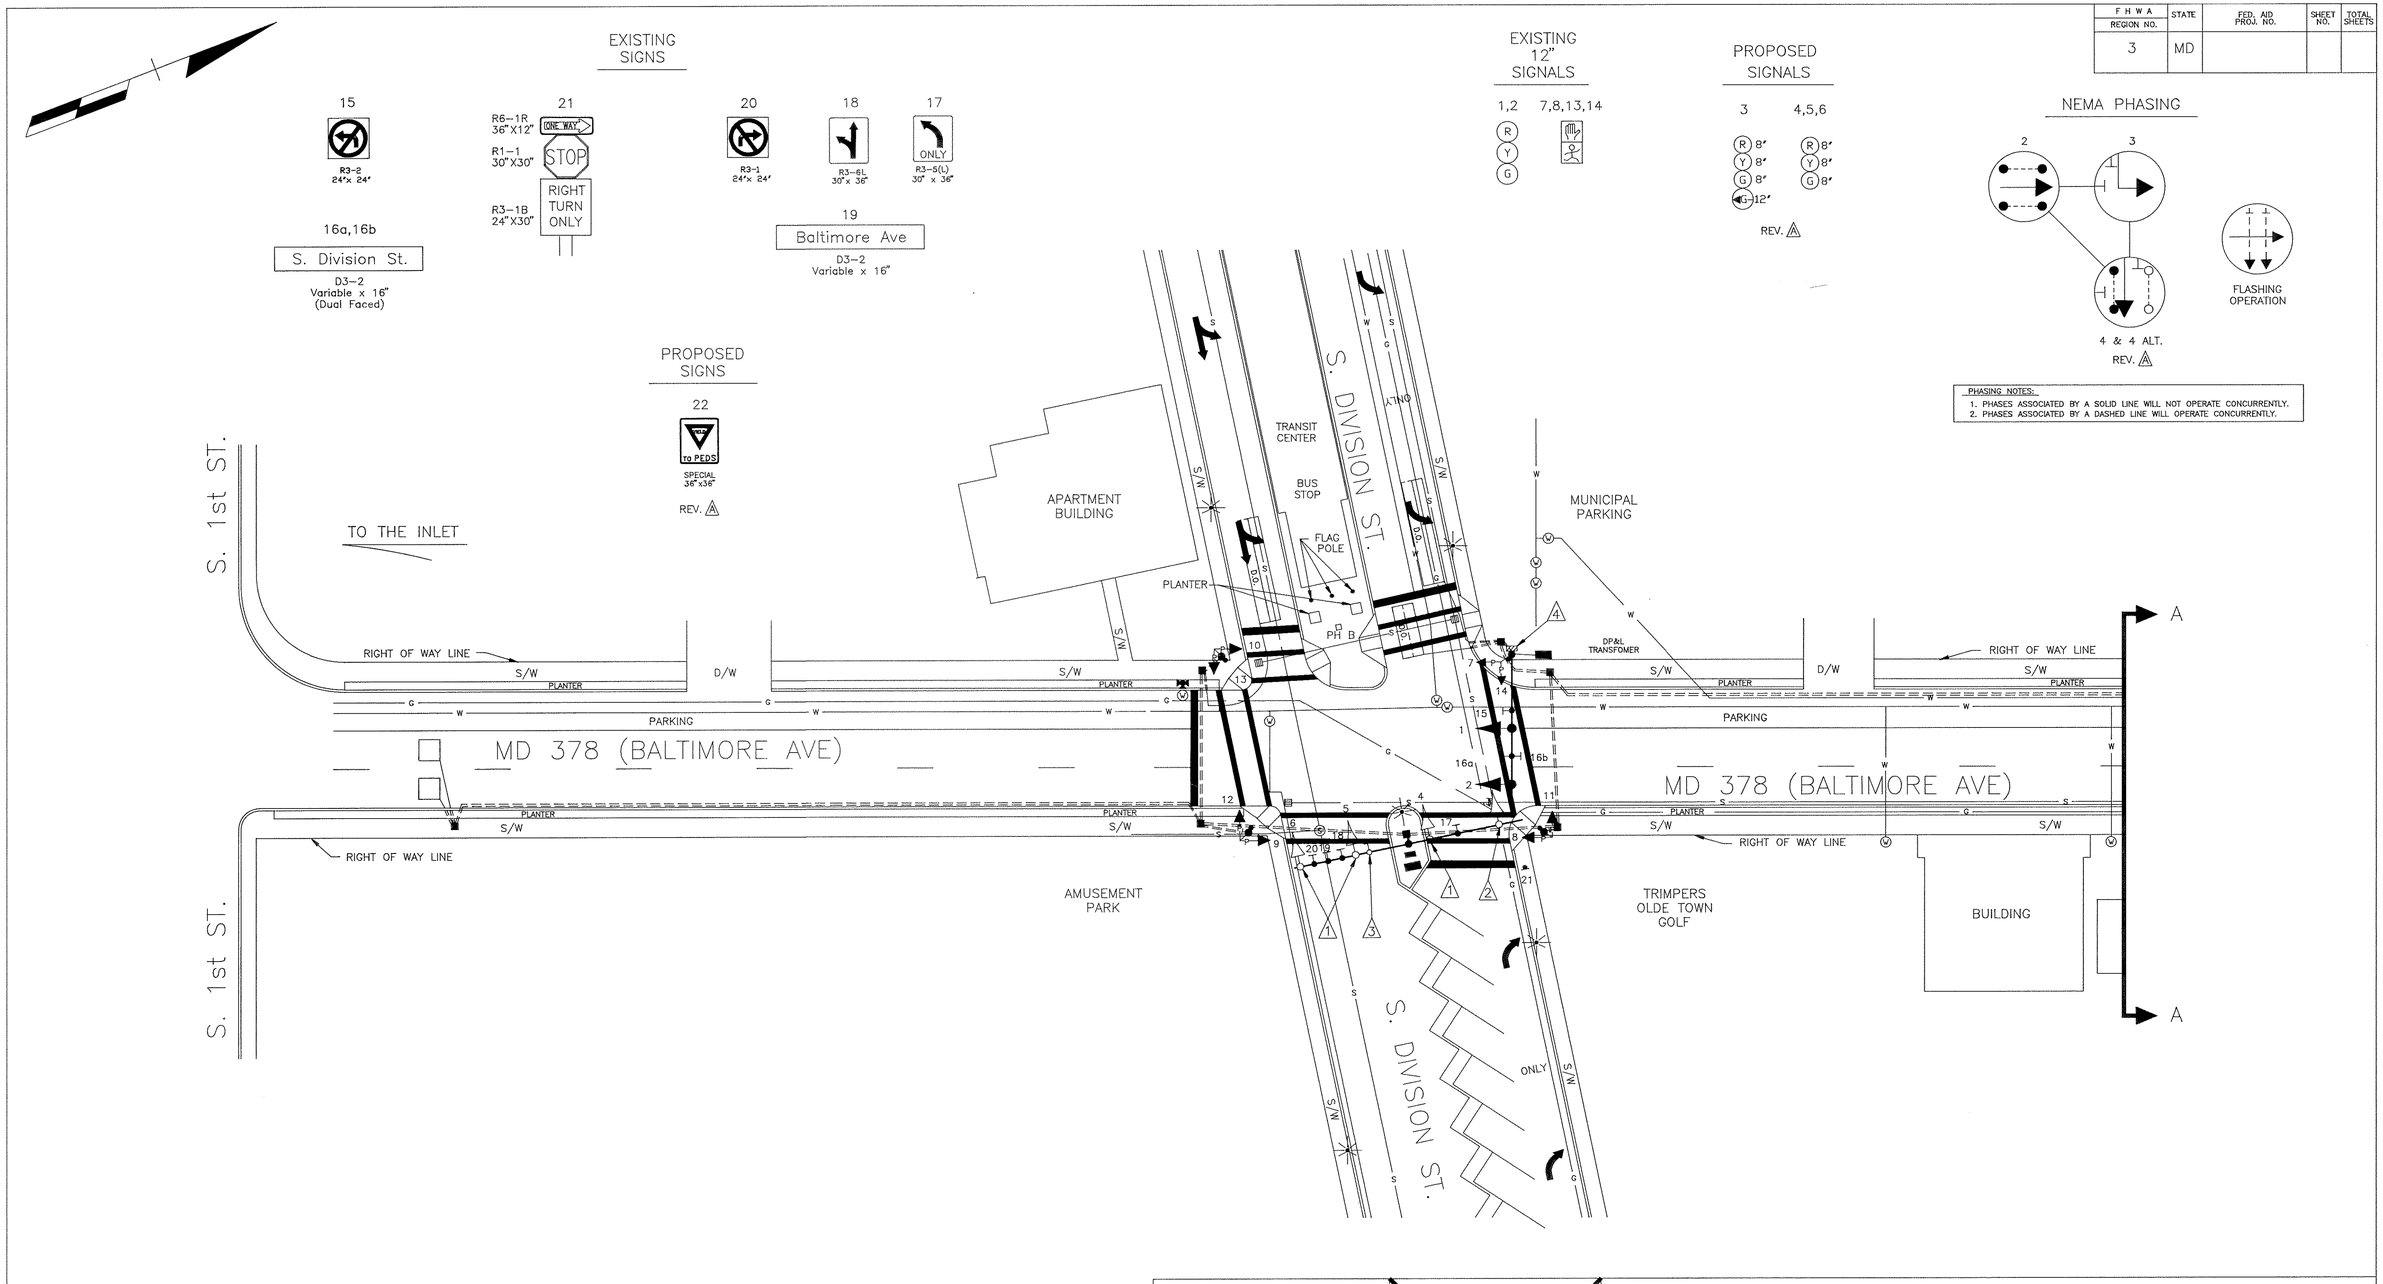

LEGEND OF UNDERGROUND AND OVERHEAD UTILITIES

AERIAL CABLE	A	A	A
ELECTRIC	E	E	E
TELEPHONE	T	T	T
GAS	G	G	G
SEWER	S	S	S
WATER	W	W	W
CABLE TV	TV	TV	TV

REVISIONS

4-26-93
MODIFY SIGNAL HEAD AND PED. PHASING
SHA-NO. 855-23026

MAR SR TH 4/26

APPROVALS

ORIGINAL
CHIEF, SIGNAL DESIGN SECTION

ON
ASST. DISTRICT ENGINEER, TRAFFIC

CHIEF, TRAFFIC ENGINEERING DESIGN DIVISION

FILE
DIRECTOR, OFFICE OF TRAFFIC AND SAFETY

MDOT – STATE HIGHWAY ADMINISTRATION

Office of Traffic and Safety

TRAFFIC ENGINEERING DESIGN DIVISION

SIGNAL NUMBER: LOG MILE: 23037800.11

DRAWN BY: S.R.BARANOWSKI (FOR STS)
DES. BY: R.R.ZACHERL (FOR STS)
CHK. BY:

MD 378 (BALTIMORE AVE) AND S. DIVISION ST.
COUNTY WORCESTER

DATE: 2-9-93
SCALE: 1" = 20'
F.A.P. NO.
S.H.A. NO.

TS/STD. NO. TS-3301 A

SHEET NO. ___ OF ___

23037800.11

F#61