F H WA REGION NO	STATE	FED. AID PROJ. NO	SHEET NO.	TOTAL SHEETS
3	MD.			

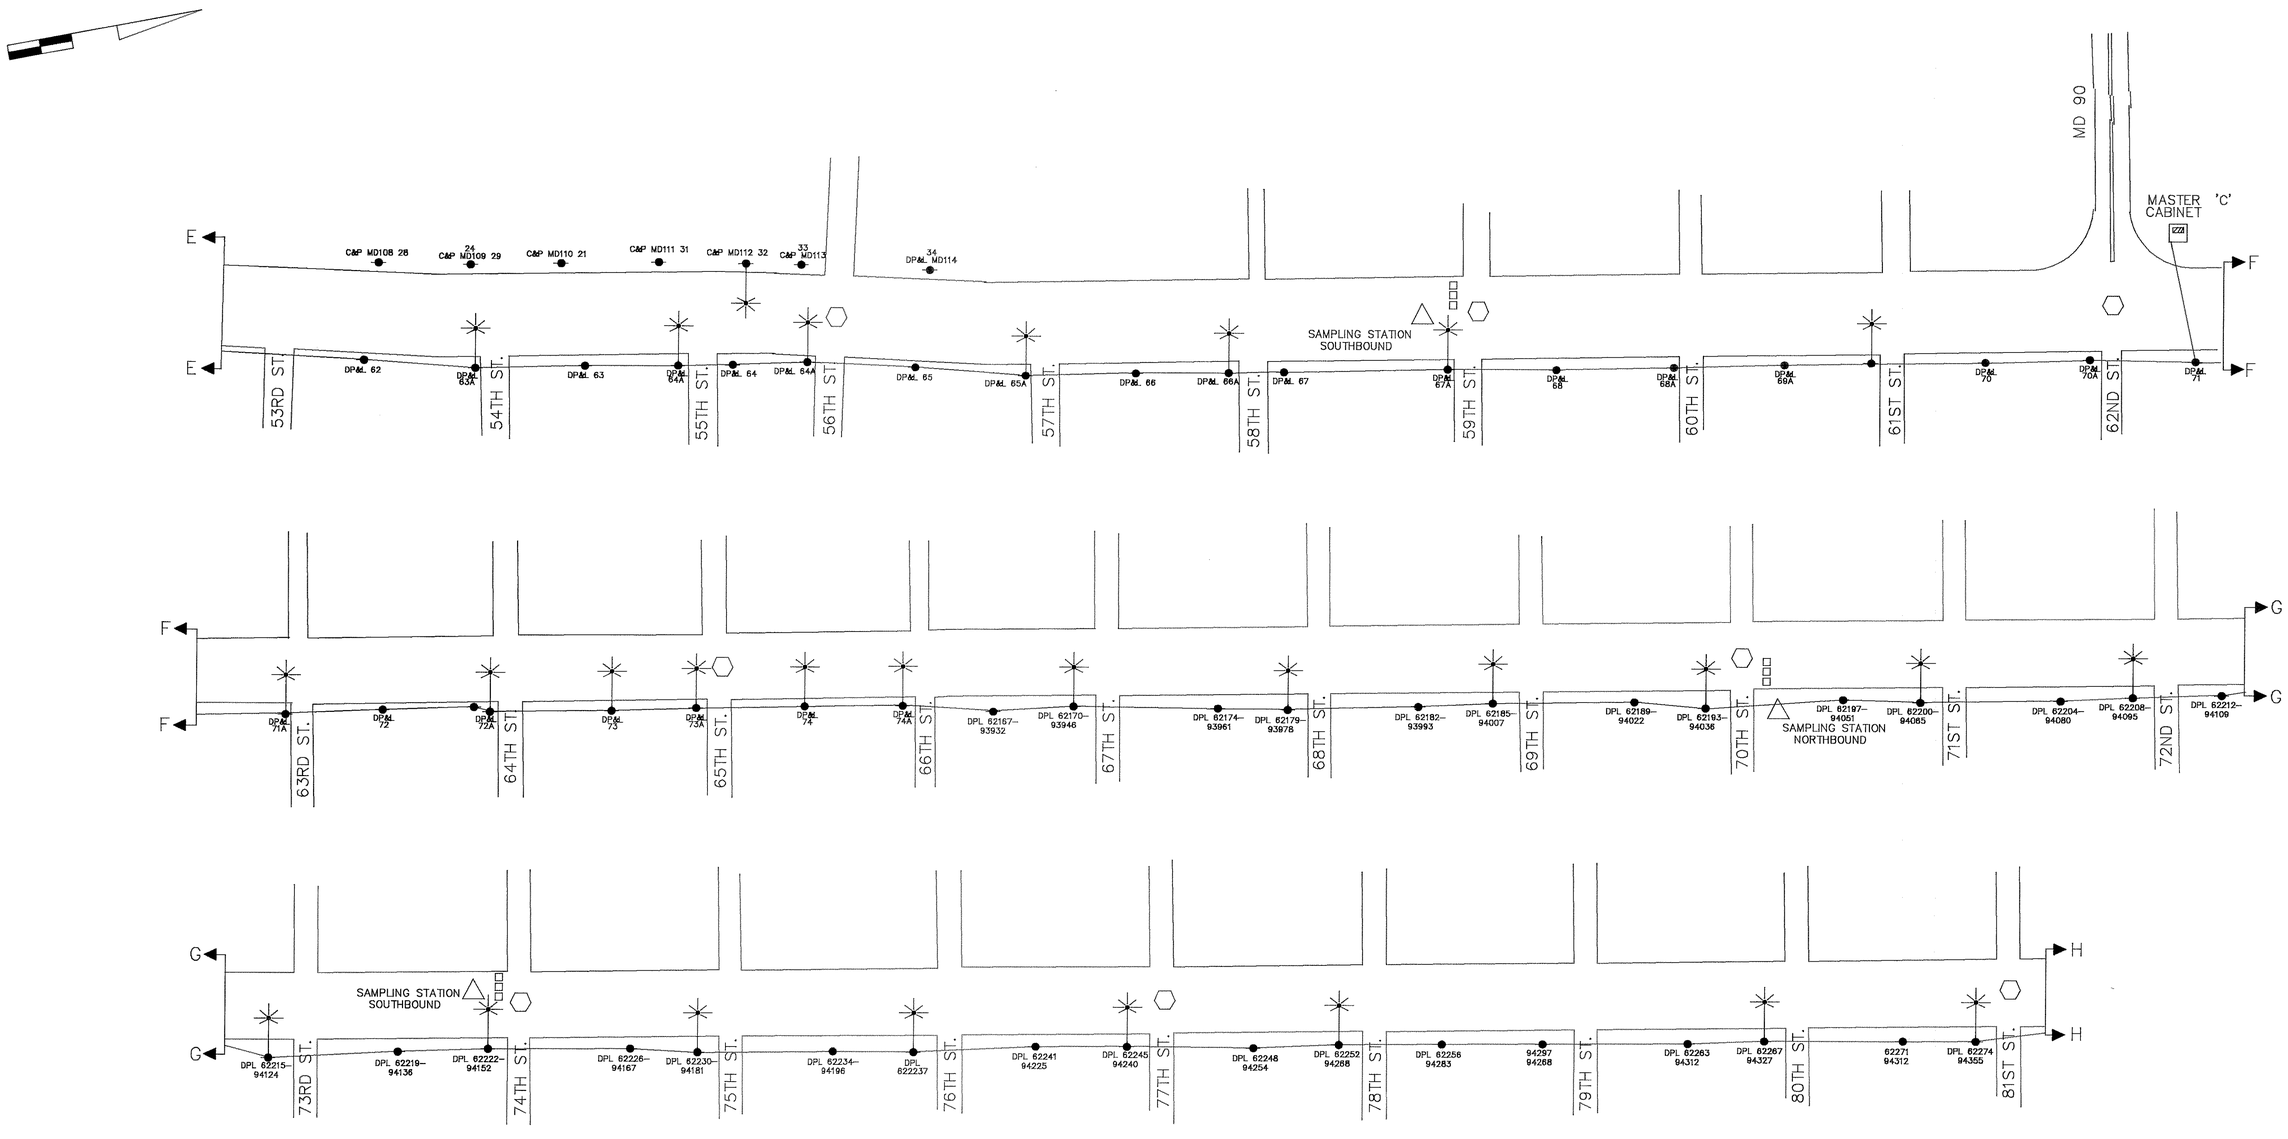

SYMBOL DENOTES

⬡ = EXISTING TRAFFIC SIGNAL

△ = EXISTING SAMPLING STATION

REVISIONS	APPROVALS
© 10/88 REDRAWN AND ASBUILT S.H.A. NO.: CA	CHIEF, DESIGN SECTION ASST. DISTRICT ENGINEER, TRAFFIC CHIEF, BUREAU OF TRAFFIC ENGINEERING DEPUTY CHIEF ENGINEER, OFFICE OF TRAFFIC

MARYLAND DEPARTMENT OF TRANSPORTATION
STATE HIGHWAY ADMINISTRATION – OFFICE OF TRAFFIC
BUREAU OF TRAFFIC ENGINEERING

RE – DRAWN BY: CECELIA ALSTON
DES. BY: CECELIA ALSTON
CHK. BY:

PHILADELPHIA AVE. (MD 528)
INTERCONNECT 56TH ST. – 81ST ST.
OCEAN CITY 'C' SYSTEM

COUNTY: WORCESTER

DATE: 10/88
SCALE: 1" = 100'
F.A.P. NO. U-917-1(1)
S.H.A. NO. WO-614-501-185
TS/FILE NO. TS – 958C1
SHEET NO. ___ OF ___

23052803.61