F.H.WA. REGION NO.	STATE	FED. AID PROJ. NO.	SHEET NO.	TOTAL SHEETS
3	MD.		4	4

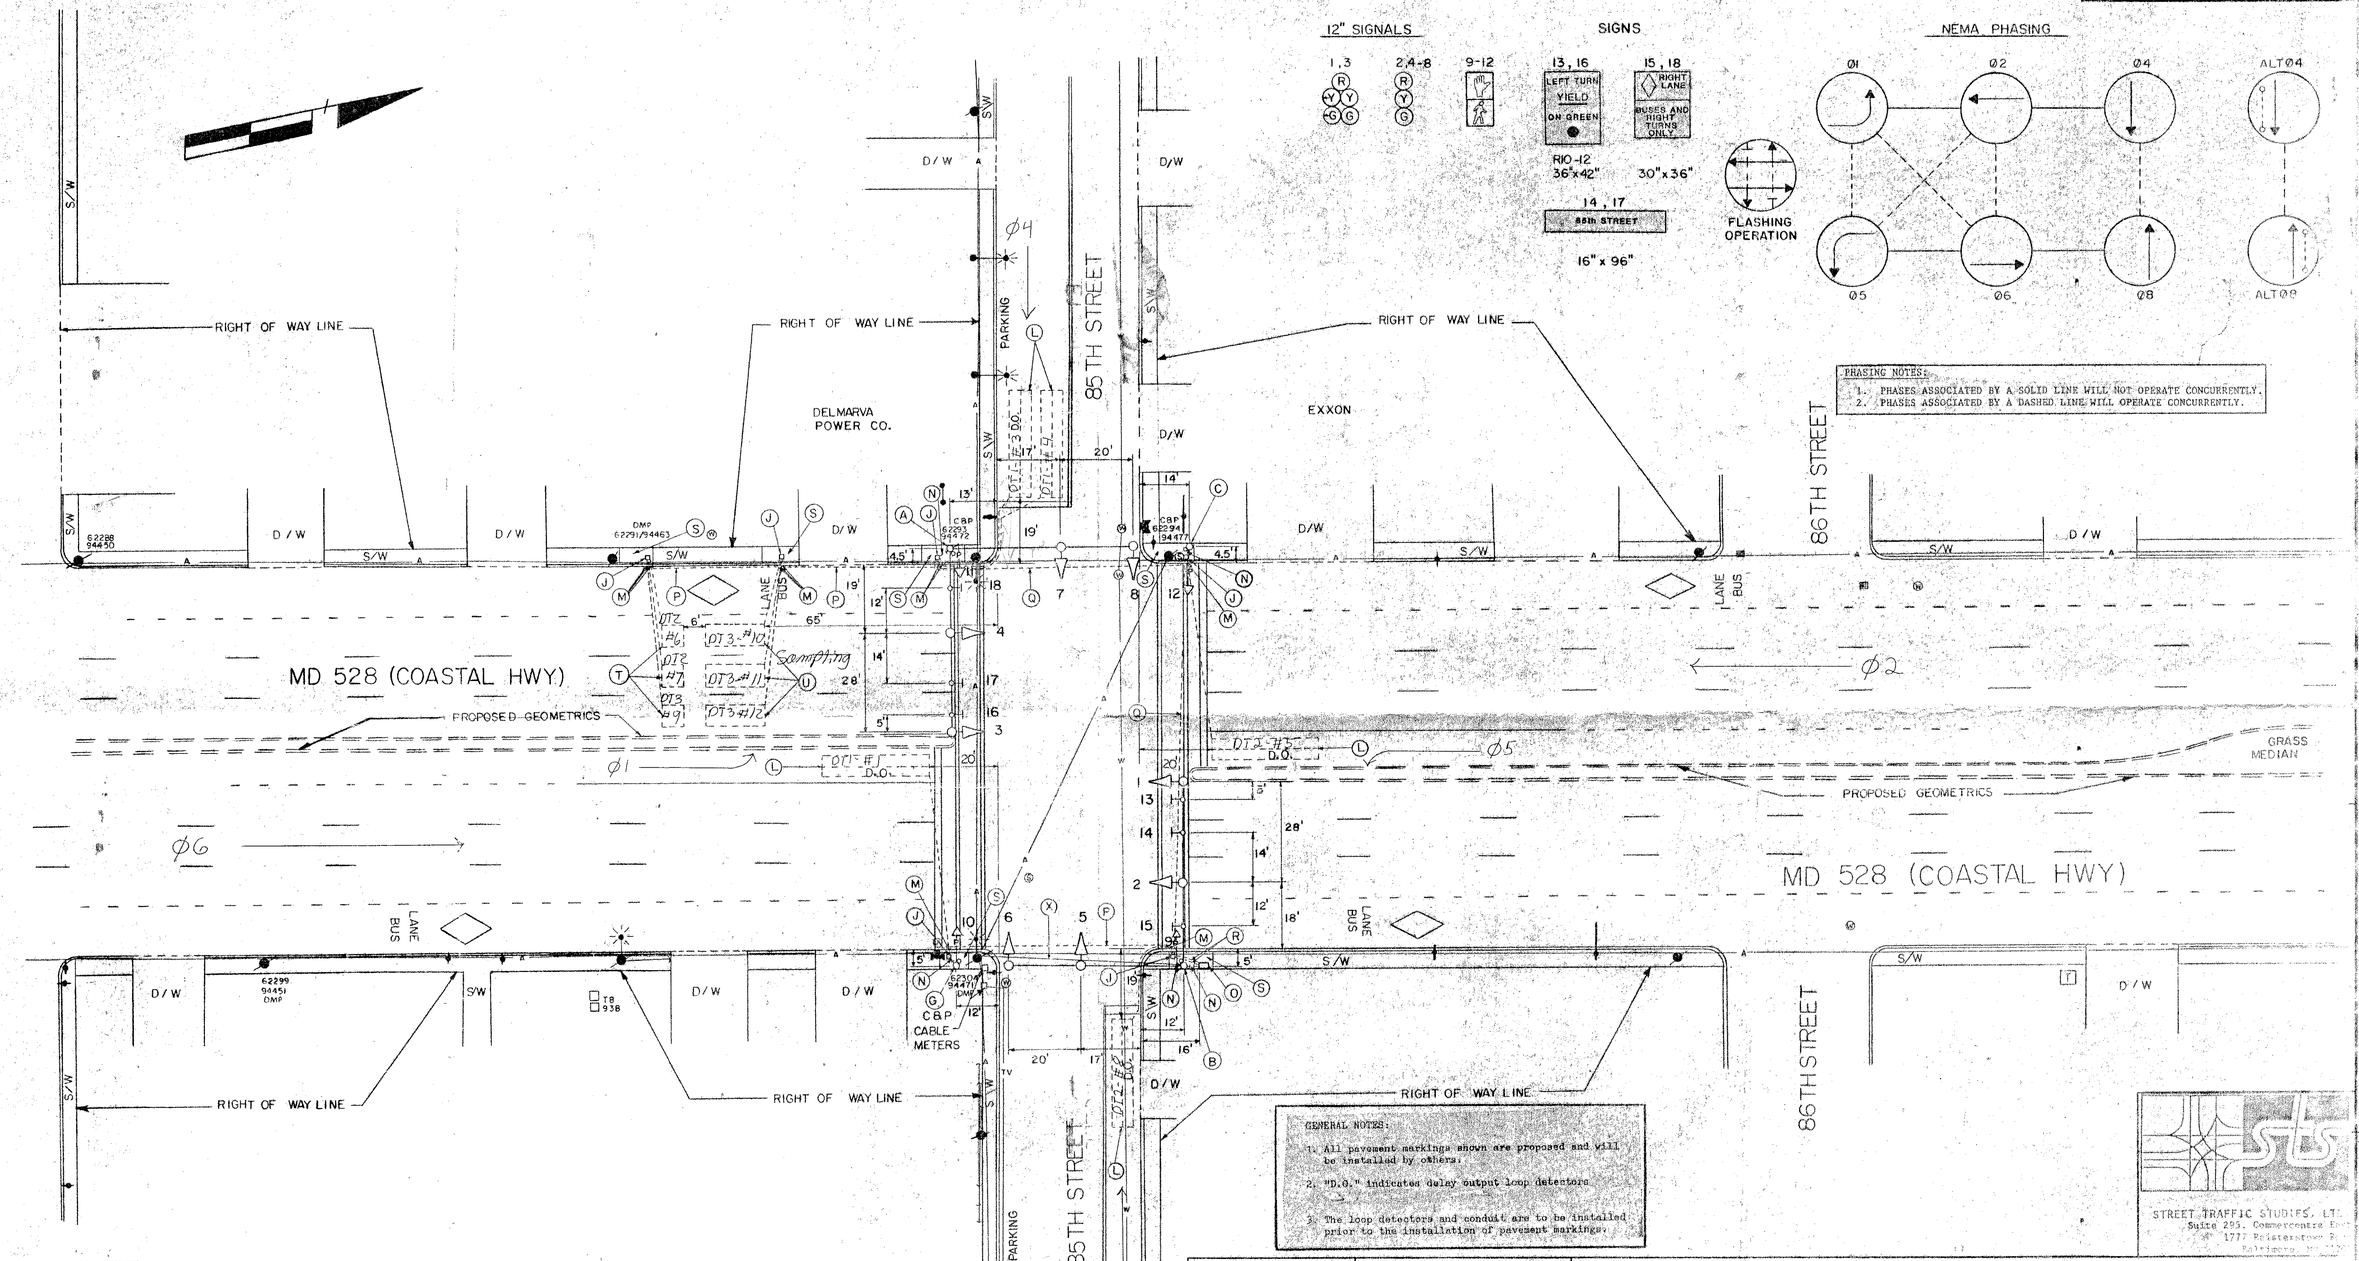

GENERAL NOTES:

1. All pavement markings shown are proposed and will be installed by others.
2. "D.O." indicates delay output loop detectors.
3. The loop detectors and conduit are to be installed prior to the installation of pavement markings.

STREET TRAFFIC STUDIES, LTD.
Suite 295, Commercentre East
1777 Reisterstown Road
Baltimore, MD 21208

LEGEND OF UNDERGROUND AND OVERHEAD UTILITIES

AERIAL CABLE	A — A — A — A
ELECTRIC	E — E — E — E
TELEPHONE	T — T — T — T
GAS	G — G — G — G
SEWER	S — S — S — S
WATER	W — W — W — W
CABLE TV	TV — TV — TV — TV

REVISIONS	APPROVALS
	Dennis J. Rodi 2-17-87 for Dimitrios A. Zachos — CHIEF, SIGNAL DESIGN SECTION
	Alfred D. Budnichuk 2/13/87 — ASST. DISTRICT ENGINEER, TRAFFIC
	Edward T. Paula 2-17-87 — CHIEF, BUREAU OF TRAFFIC ENGINEERING
	2-18-87 — DEPUTY CHIEF ENGINEER, OFFICE OF TRAFFIC

MARYLAND DEPARTMENT OF TRANSPORTATION
STATE HIGHWAY ADMINISTRATION - OFFICE OF TRAFFIC
BUREAU OF TRAFFIC ENGINEERING

MD 528 (COASTAL HWY.) AND 85TH STREET

OCEAN CITY — COUNTY WORCESTER

SCALE: 1" = 20' — DATE: 12-29-86

DRAWN BY K.L. BROWN (FOR STS) — DES. BY: R. ZACHERT (FOR STS) — CHK. BY: [illegible]

F.A.P. NO. N/A — S.H.A. NO. — TS/FILE NO. 2257

SHEET NO. 4 OF 4

214
480
694

86 10 + 84 All of

23052803.39