F.H.WA. REGION NO	STATE	FED. AID PROJ. NO	SHEET NO	TOTAL SHEETS
3	MD.		4	4

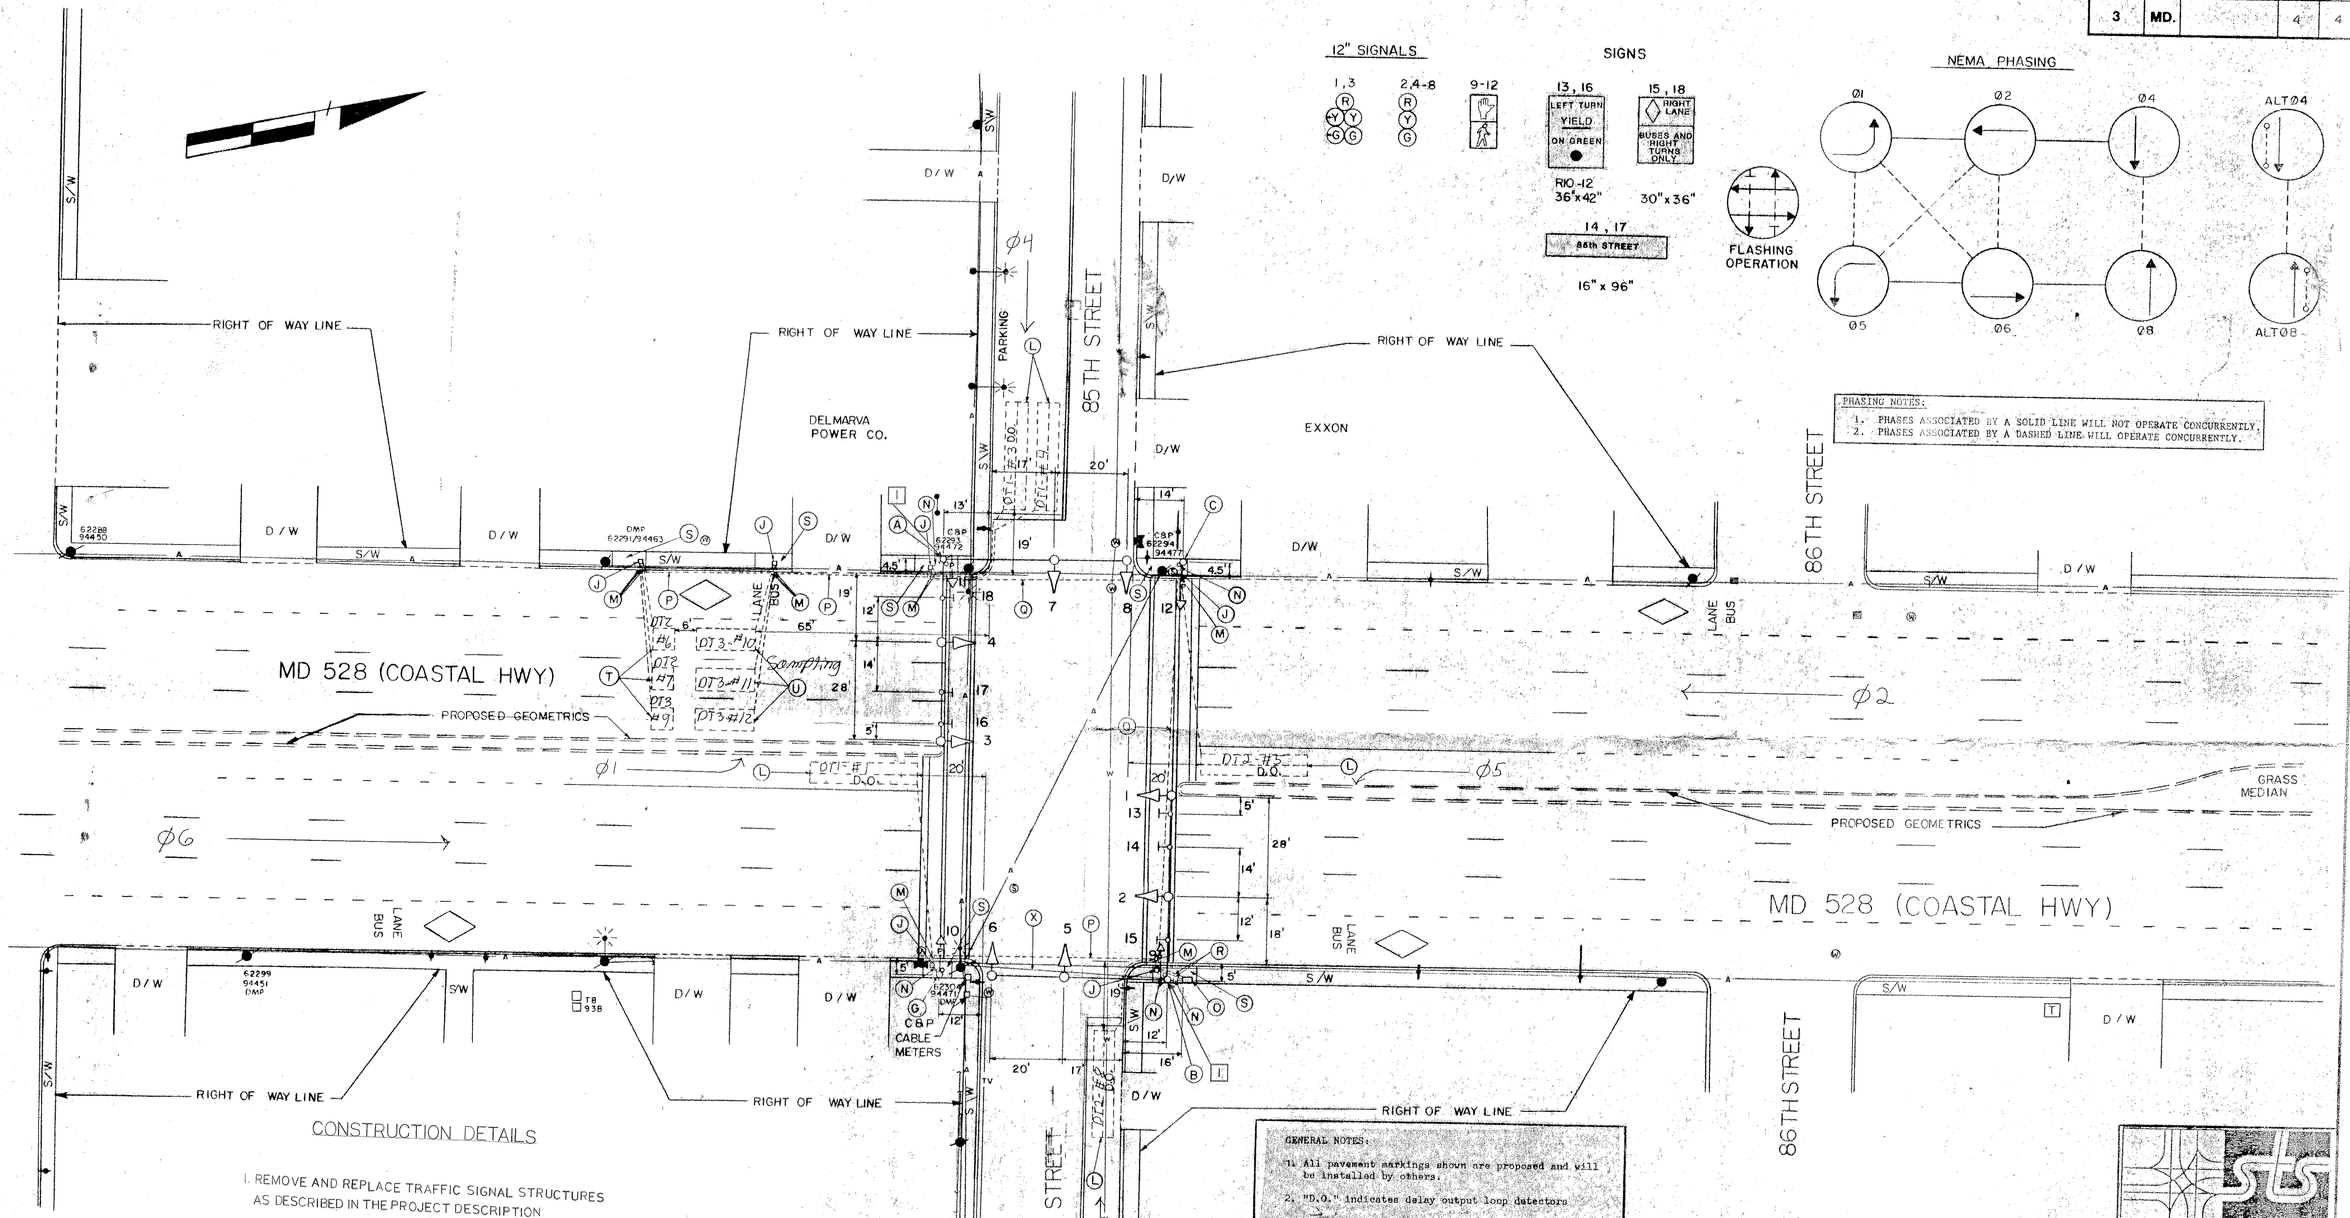

23052803.39