MD 528 is considered to run in a North/South direction.

EXISTING SIGNS

17,19 — 67 th ST — D-3(1) 16" x Var. Dual Faced Sign

18,20 — LEFT TURN YIELD ON GREEN — R 10-12 36" x 42"

21 — ONLY — R 3-5(R) 30" x 36"

22,23 — Coastal HWY — D-3(1) 16" x Var. Dual Faced Sign

24,25 — RIGHT LANE BUSES AND RIGHT TURNS ONLY — R 3-14(Mod) 30" x 36"

PUSHBUTTON TO CROSS COASTAL HWY — WAIT FOR WALK SIGNAL — PUSH BUTTON — TO CROSS COASTAL HWY — R 10-4(1) 9" x 12" (To Be Installed With Pushbutton) Sign to Read " PUSHBUTTON TO CROSS COASTAL HWY"

EXISTING SIGNALS

1,4 — R Y G — 12"/8"

2,5 — R Y G — 12"

3,6-12 — R Y G — 12"

13-16 — 10 — 16"

EXISTING NEMA PHASING

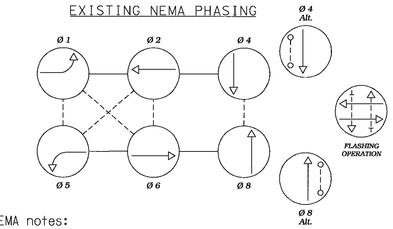

NEMA notes:
Phases associated by a dashed line will operate concurrently.
Phases associated by a solid line will not operate concurrently.

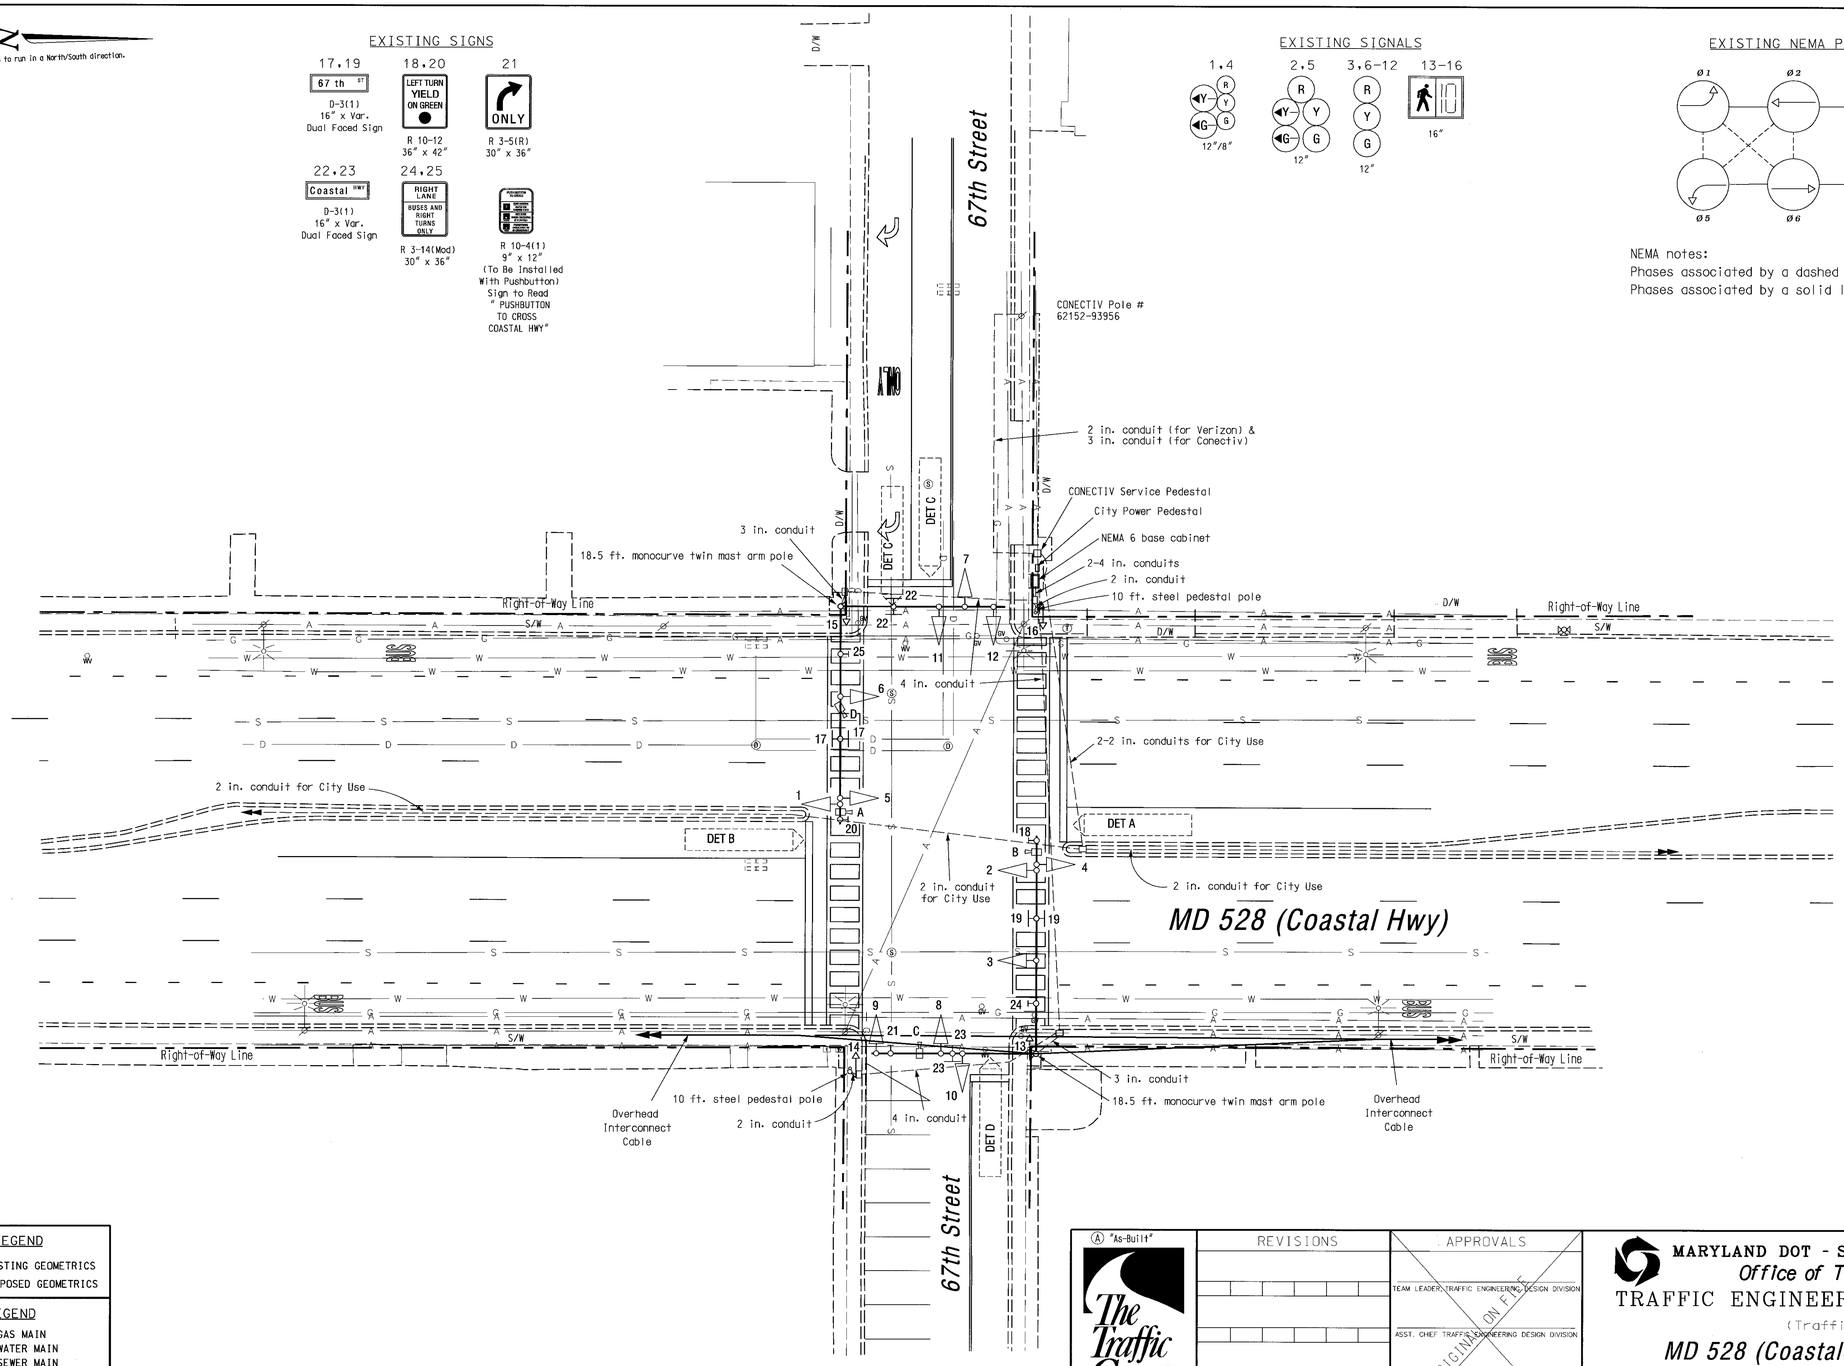

GEOMETRIC LEGEND

EXISTING GEOMETRICS
PROPOSED GEOMETRICS

UTILITY LEGEND

G	GAS MAIN
W	WATER MAIN
S	SEWER MAIN
E	ELECTRIC CABLES
D	STORM DRAIN
A	AERIAL CABLES
T	TELEPHONE CABLES

Ⓐ "As-Built"

The Traffic Group
The Traffic Group, Inc.
410-931-6600
Fax 410-931-6601

REVISIONS		
Ⓐ As-Built	July 14, 2004	
jjd		

APPROVALS

TEAM LEADER, TRAFFIC ENGINEERING DESIGN DIVISION
ASST. CHIEF TRAFFIC ENGINEERING DESIGN DIVISION
CHIEF, TRAFFIC ENGINEERING DESIGN DIVISION
DIRECTOR, TRAFFIC & SAFETY

ORIGINAL ON FILE

MARYLAND DOT - STATE HIGHWAY ADMINISTRATION
Office of Traffic & Safety
TRAFFIC ENGINEERING DESIGN DIVISION
(Traffic Signal Plan)

MD 528 (Coastal Hwy) at 67th Street

DRAWN BY:	J. Dirndorfer	F.A.P. NO.	N/A	TS NO.	4296	SHEET NO.	1 OF 1
CHECKED BY:	M. Rucker	S.H.A. NO.	BW992M82				
SCALE:	1" = 20'	COUNTY:	Worcester	T.I.M.S. NO.	G029		
DATE:	January 23, 2004	LOG MILE:	23052804.42				

F:\2002\2002-0396\04-as-built.dgn 08/04/2004