F.H.W.A. REGION NO.	STATE	FED. AID PROJ. NO.	SHEET NO.	TOTAL SHEETS
3	MD.		3	4

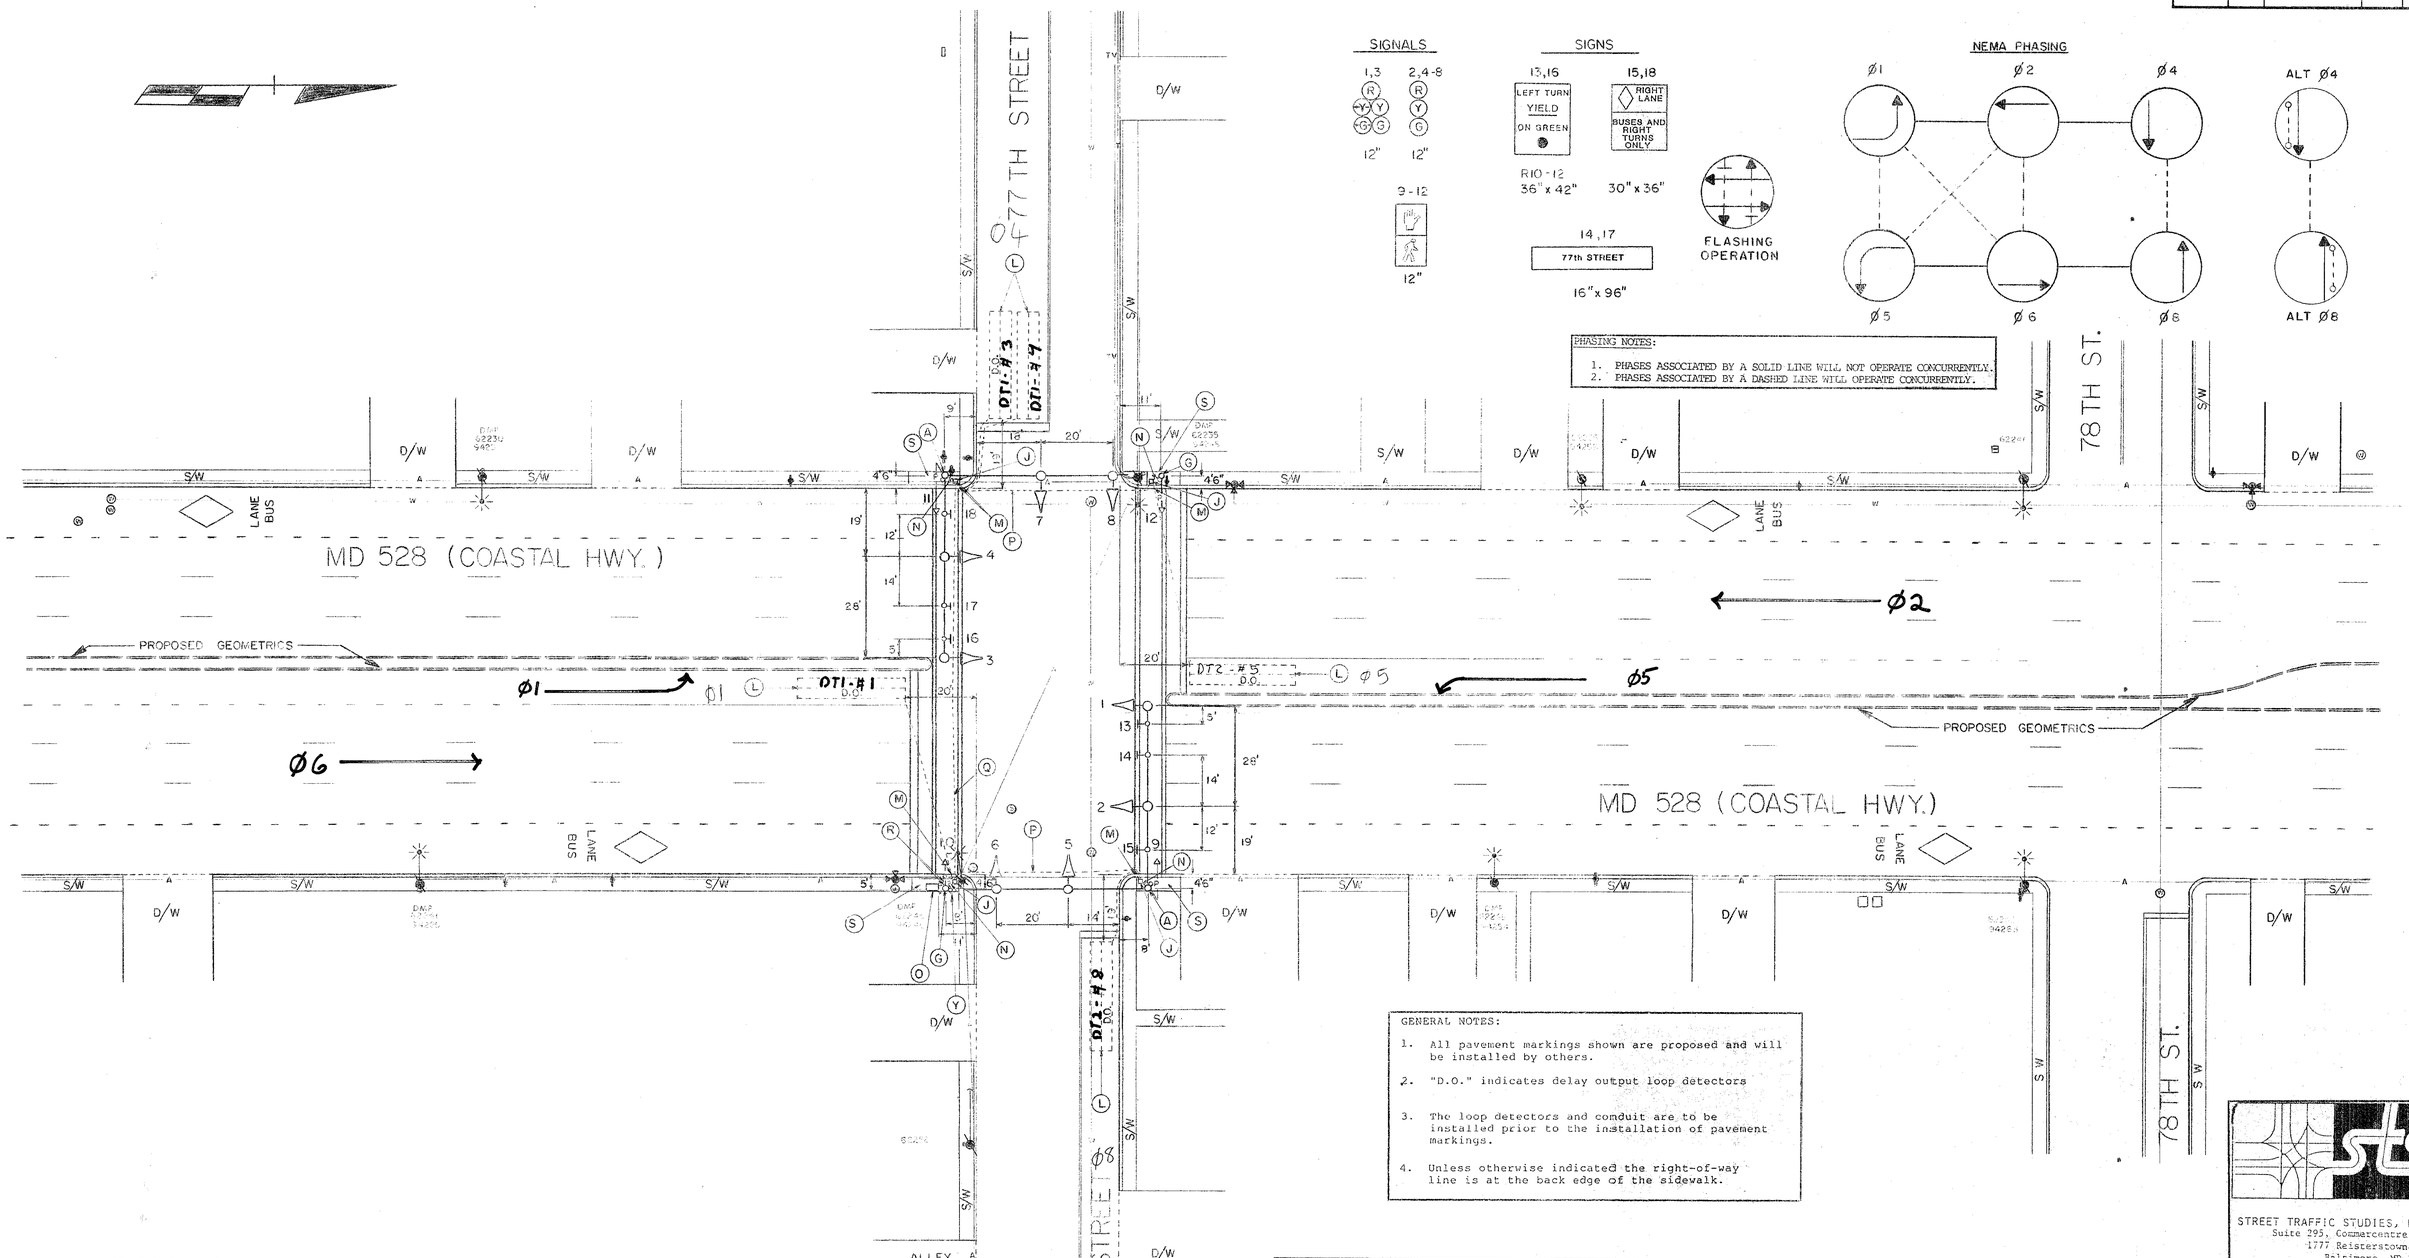

PHASING NOTES:

1. PHASES ASSOCIATED BY A SOLID LINE WILL NOT OPERATE CONCURRENTLY.
2. PHASES ASSOCIATED BY A DASHED LINE WILL OPERATE CONCURRENTLY.

GENERAL NOTES:

1. All pavement markings shown are proposed and will be installed by others.
2. "D.O." indicates delay output loop detectors
3. The loop detectors and conduit are to be installed prior to the installation of pavement markings.
4. Unless otherwise indicated the right-of-way line is at the back edge of the sidewalk.

STREET TRAFFIC STUDIES, LTD.
Suite 295, Commercentre East
1777 Reisterstown Road
Baltimore, MD 21208

LEGEND OF UNDERGROUND AND OVERHEAD UTILITIES

AERIAL CABLE	A — A — A — A
ELECTRIC	E — E — E — E
TELEPHONE	T — T — T — T
GAS	G — G — G — G
SEWER	S — S — S — S
WATER	W — W — W — W
CABLE TV	TV — TV — TV — TV

REVISIONS

APPROVALS

Dennis J. Dodd Jr. 2-17-87
for Dimitrios A. Zelivis
CHIEF, SIGNAL DESIGN SECTION

Alfred D. Budrichuk 2/13/87
ASST. DISTRICT ENGINEER, TRAFFIC

Edward T. Carter Jr. 2-17-87
CHIEF, BUREAU OF TRAFFIC ENGINEERING

2-18-87
DEPUTY CHIEF ENGINEER, OFFICE OF TRAFFIC

MARYLAND DEPARTMENT OF TRANSPORTATION
STATE HIGHWAY ADMINISTRATION - OFFICE OF TRAFFIC
BUREAU OF TRAFFIC ENGINEERING

MD 528 AND 77TH STREET

OCEAN CITY — COUNTY: WORCESTER

SCALE: 1" = 20' — DATE: 11-19-86

DRAWN BY SR. BARANOWSKI (FOR STS)
DES. BY: R. ZACHERL (FOR STS)
CHK. BY: Dennis J. Dodd 2-17-87

F.A.P. NO. N/A
S.H.A. NO.
TS/FILE NO. 2256

SHEET NO. 3 OF 4

124021
DIETZGEN S-139-M3