F H WA REGION NO.	STATE	FED. AID PROJ. NO.	SHEET NO.	TOTAL SHEETS
3	MD.		3	3

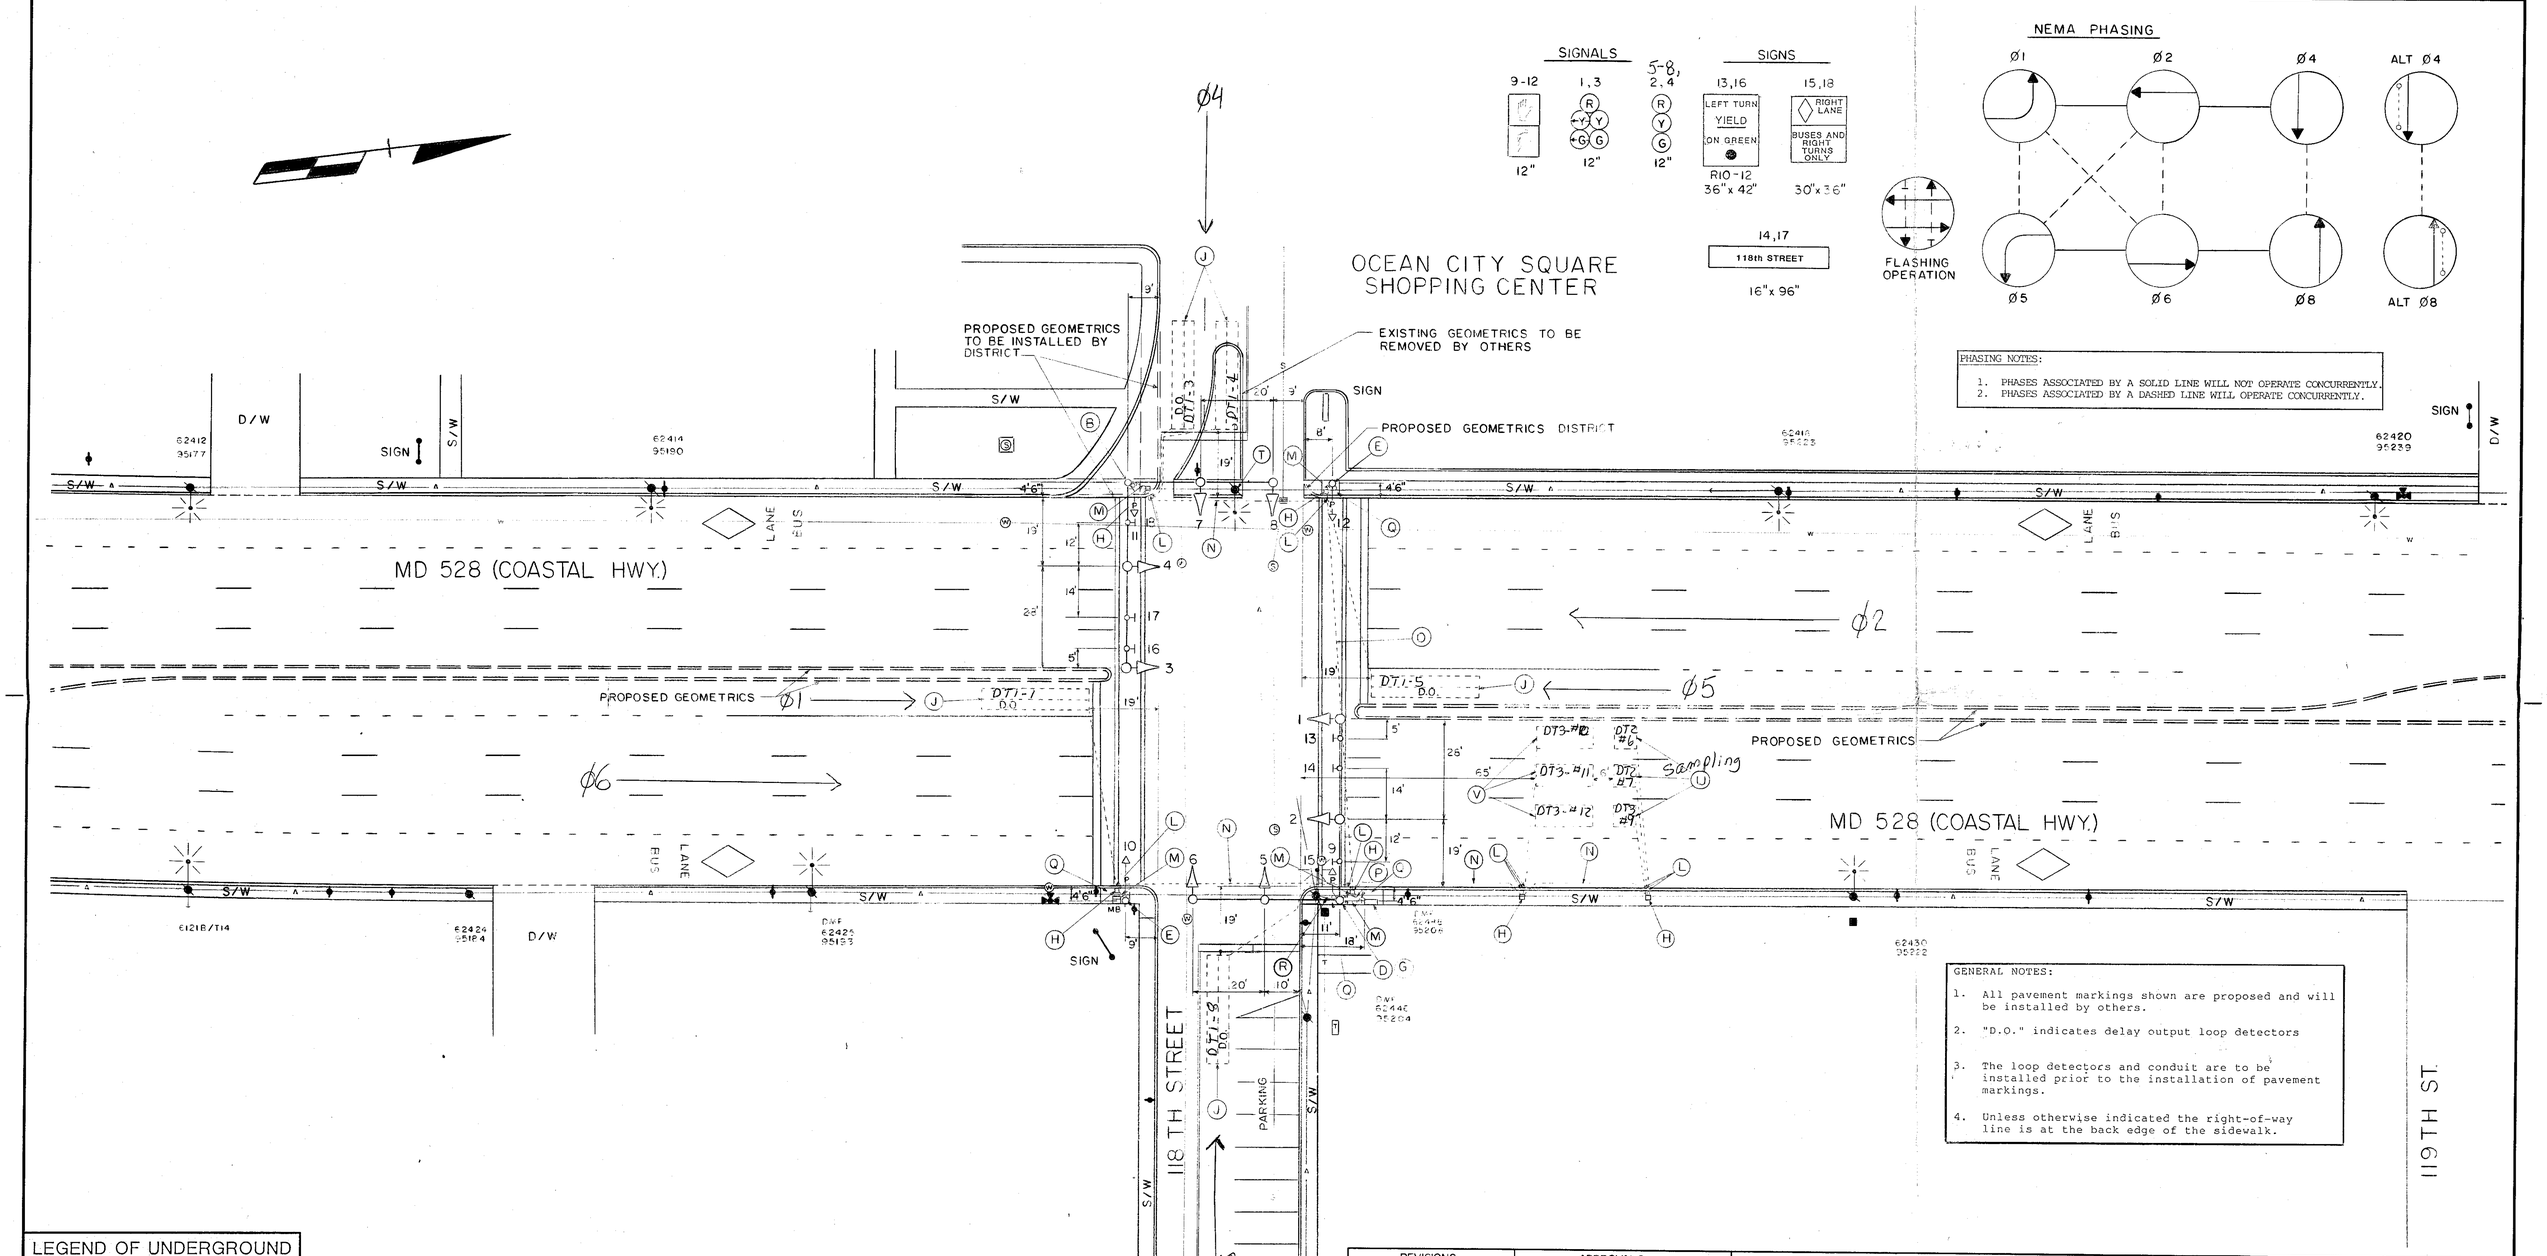

LEGEND OF UNDERGROUND AND OVERHEAD UTILITIES

AERIAL CABLE	A
ELECTRIC	E
TELEPHONE	T
GAS	G
SEWER	S
WATER	W
CABLE TV	TV

STREET TRAFFIC STUDIES, LTD.
Suite 295, Commercentre East
1777 Reisterstown Road
Baltimore, MD 21208

REVISIONS	APPROVALS
	CHIEF, SIGNAL DESIGN SECTION
	ASST. DISTRICT ENGINEER, TRAFFIC
	CHIEF, BUREAU OF TRAFFIC ENGINEERING
	DEPUTY CHIEF ENGINEER, OFFICE OF TRAFFIC

MARYLAND DEPARTMENT OF TRANSPORTATION
STATE HIGHWAY ADMINISTRATION - OFFICE OF TRAFFIC
BUREAU OF TRAFFIC ENGINEERING

MD 528 AND 118 TH STREET

OCEAN CITY — COUNTY: WORCESTER

SCALE: 1" = 20' — DATE: 11-21-86

DRAWN BY S. THACKER (FOR STS) — DES. BY: R. ZACHERL (FOR STS) — CHK. BY:

F.A.P. NO. N/A

S.H.A. NO. WO-645-451-185

TS/FILE NO. 2262

SHEET NO. 3 OF 3

124021

DIETZGEN S-139-M3