DRILL HOLES

DRILL HOLES

DRILL HOLES

MD 528 IS ASSUMED TO RUN IN A NORTH-SOUTH DIRECTION




## EXISTING SIGNALS




## EXISTINGS SIGNS

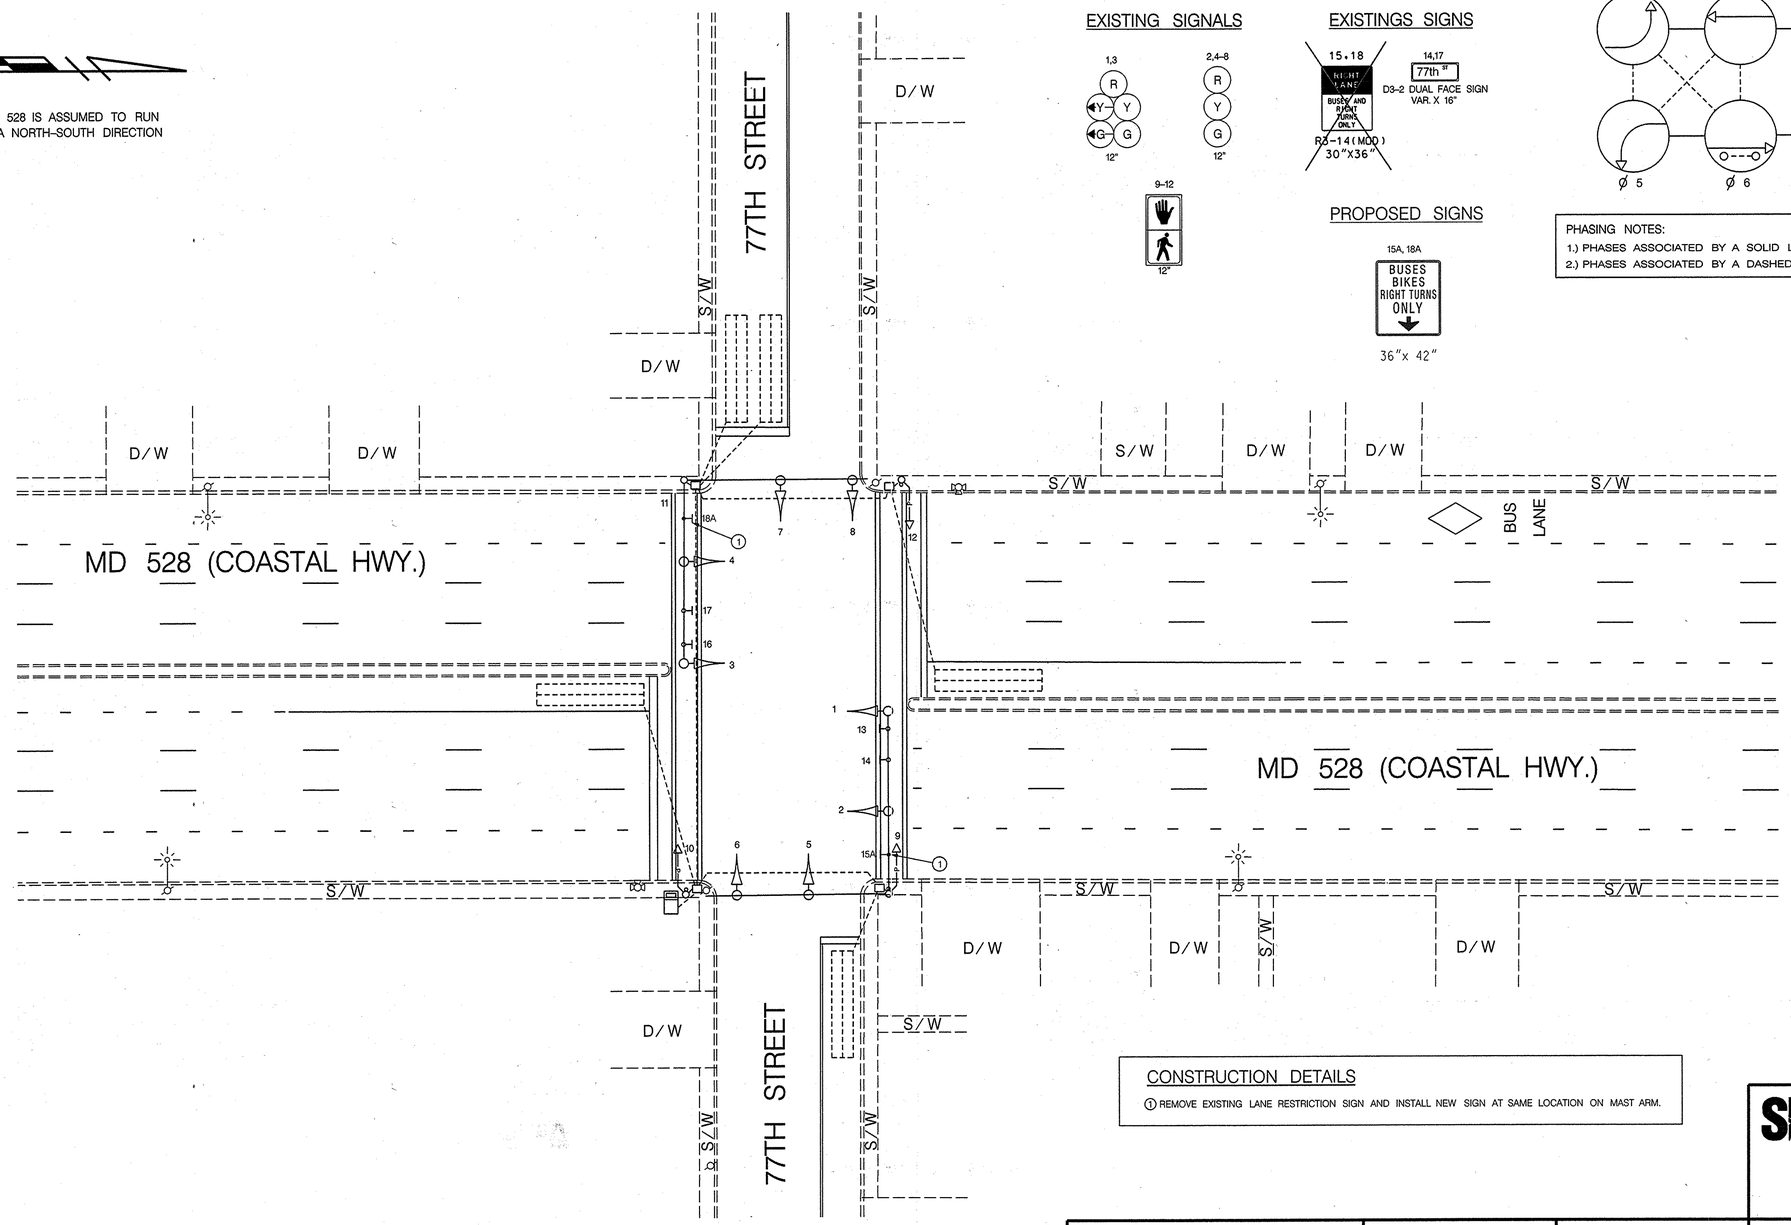


## PROPOSED SIGNS




## NEMA PHASING




PHASING NOTES:

1.) PHASES ASSOCIATED BY A SOLID LINE WILL NOT OPERATE CONCURRENTLY.

2.) PHASES ASSOCIATED BY A DASHED LINE MAY OPERATE CONCURRENTLY.

## CONSTRUCTION DETAILS

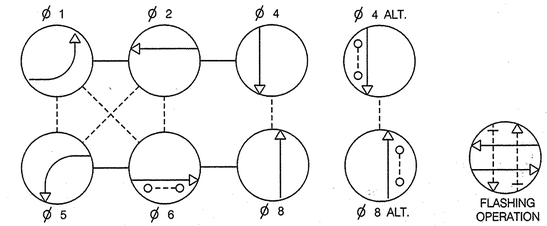① REMOVE EXISTING LANE RESTRICTION SIGN AND INSTALL NEW SIGN AT SAME LOCATION ON MAST ARM.

## LEGEND OF UNDERGROUND AND OVERHEAD UTILITIES

| | |
|---|---|
| AERIAL CABLE | A |
| ELECTRICAL | E |
| TELEPHONE | T |
| GAS | G |
| SEWER | S |
| WATER | W |
| CABLE TV | TV |


TRAFFIC CONCEPTS, INC.

325 Gambrills Road
Suite E
Gambrills, MD 21054
(410) 923-7101
FAX: (410) 923-6473
EMAIL: TRAFFIC@TRAFFIC-CONCEPTS.COM


APPROVALS

ORIGINAL ON FILE

TEAM LEADER

ASST. DIV. CHIEF

DIVISION CHIEF

OFFICE DIRECTOR

REVISIONS

| | | |
|---|---|---|
| A | INSTALL RESTRICTED RIGHT LANE SIGNS | |
| 7-14-08 | | SHA NO. AT9095189 |
| MR | | |

FILE PATH: L:\1500\1566\Task 123- MD 528\Dgn\CC DGN FILES\MD528 @ 77th_pl.dgn

DATE: Tuesday, July 15, 2008 AT 10:02 AM

STATE OF MARYLAND
DEPARTMENT OF TRANSPORTATION
STATE HIGHWAY ADMINISTRATION

OFFICE OF TRAFFIC & SAFETY
TRAFFIC ENGINEERING DESIGN DIVISION

# TRAFFIC SIGNAL PLAN

## MD 528 AND 77TH STREET

| | | | |
|---|---|---|---|
| SCALE | 1"=20' | DATE | CONTRACT NO. |
| DESIGNED BY | M.R. | COUNTY | WORCHESTER |
| DRAWN BY | M.R. | LOGMILE | |
| CHECKED BY | S.R. | T.I.M.S. NO. | I623 |
| F.A.P. NO. | | TOD NO. | |
| DRAWING NO. | TS-2256A | SHEET NO. | 24 OF 46 |

TOD No. AT909-32
SHA No. WO442A55/C55