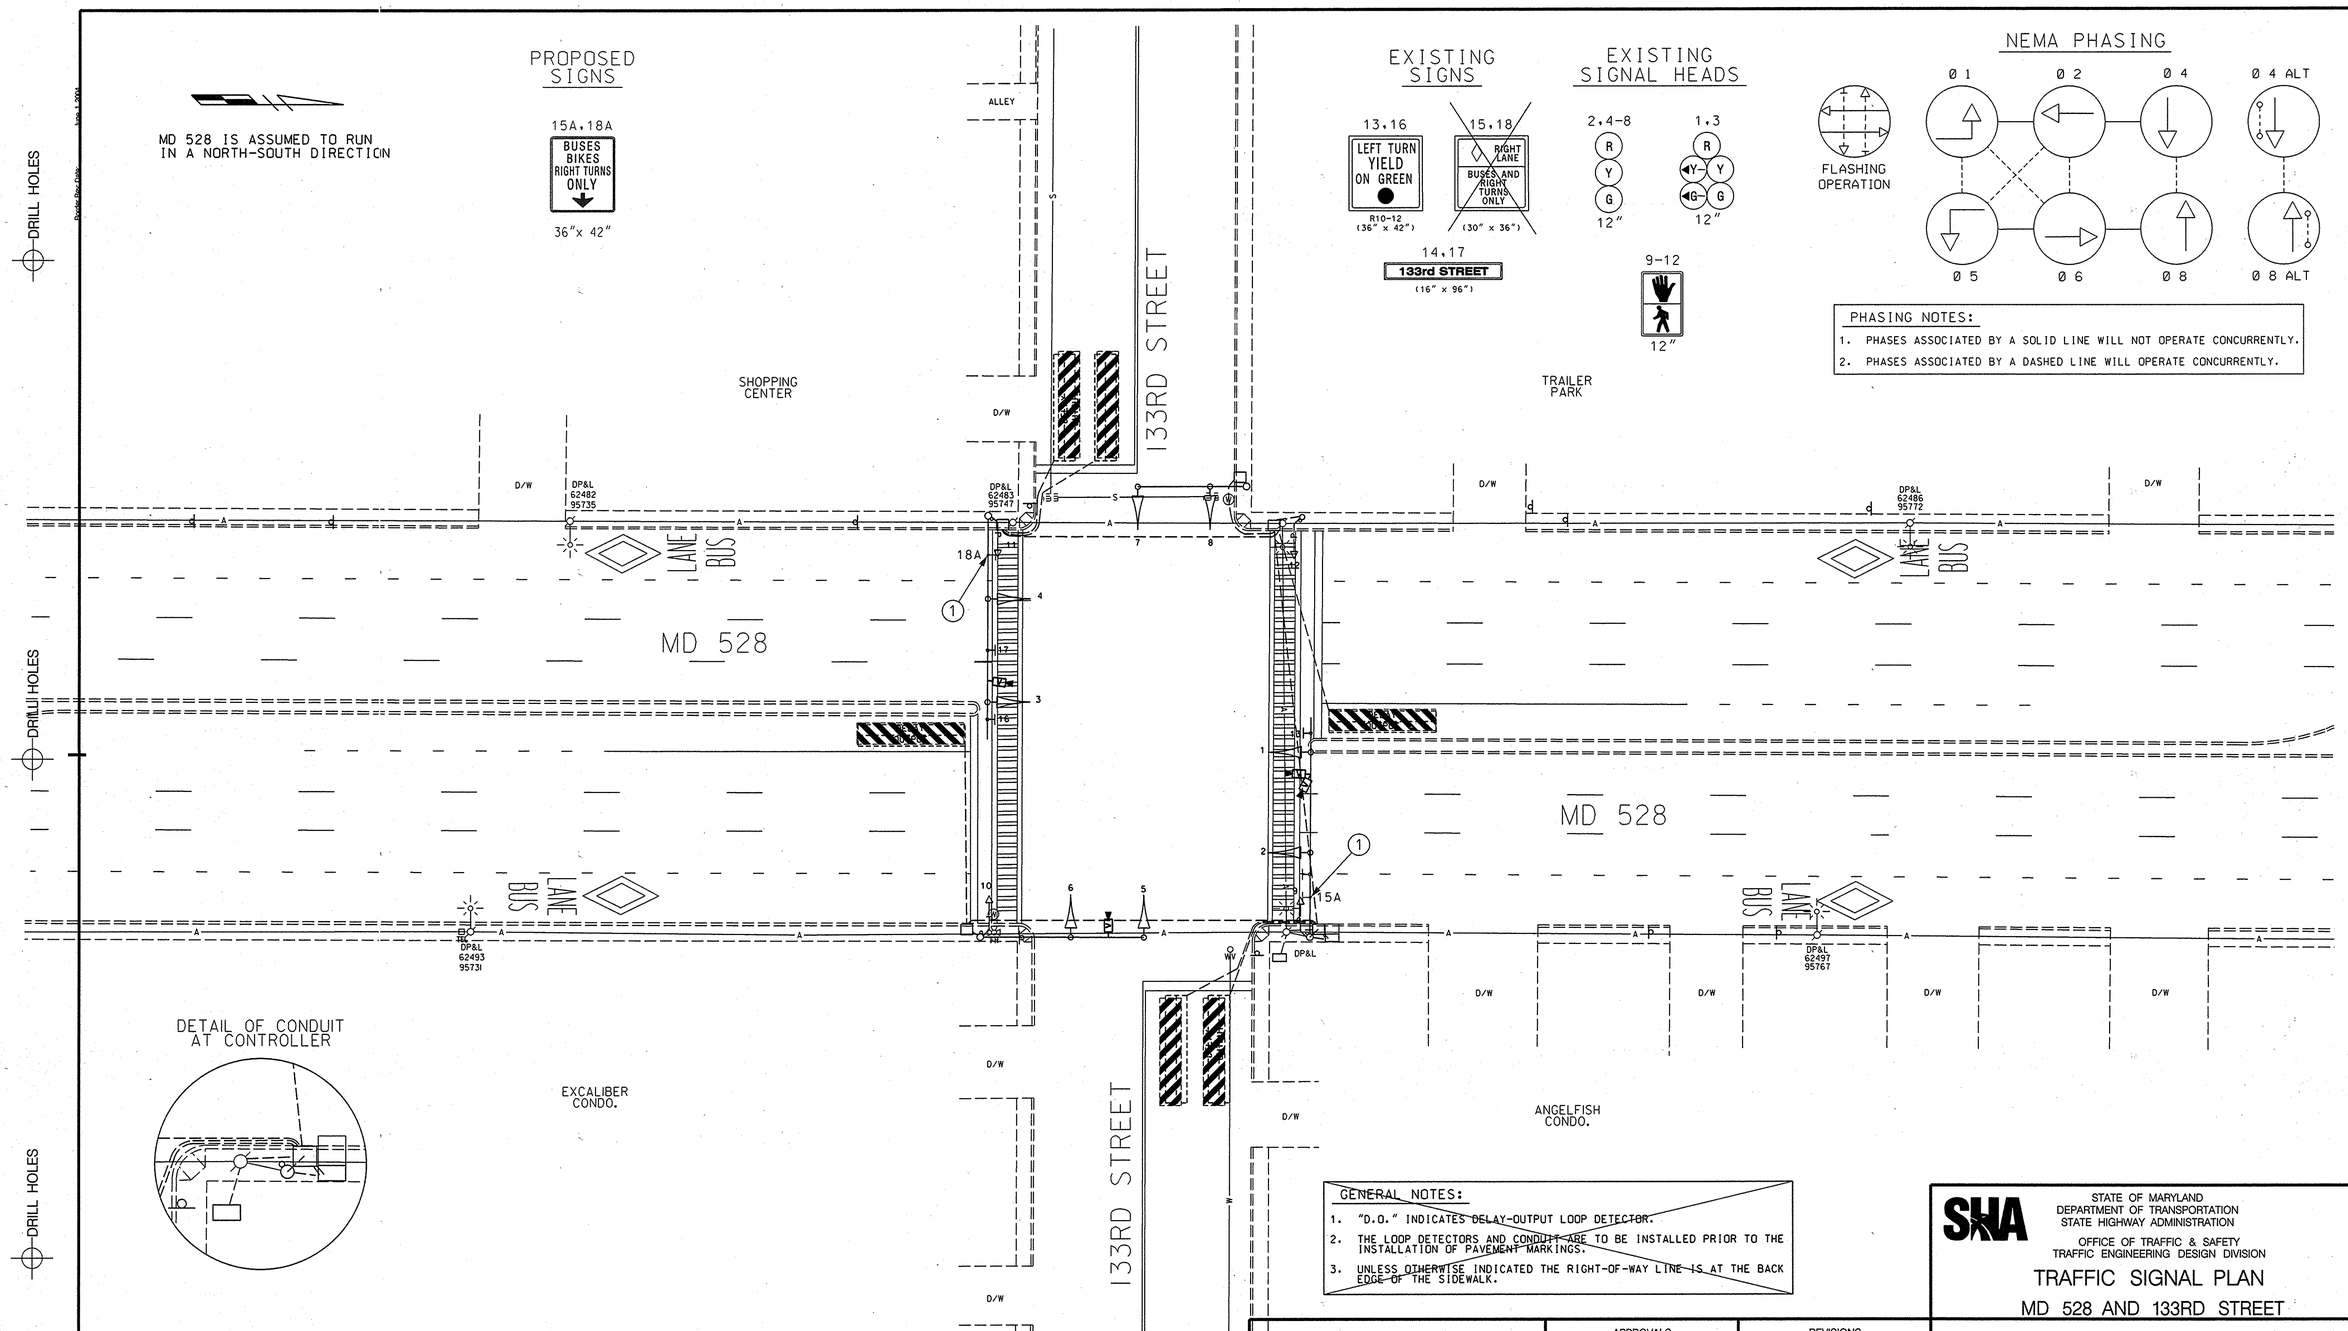
PROPOSED SIGNS
MD 528 IS ASSUMED TO RUN IN A NORTH-SOUTH DIRECTION
15A,18A
BUSES BIKES RIGHT TURNS ONLY
36"x 42"
EXISTING SIGNS
13,16
LEFT TURN YIELD ON GREEN
R10-12 (36" x 42")
15,18
RIGHT LANE
BUSES AND RIGHT TURNS ONLY
(30" x 36")
14,17
133rd STREET
(16" x 96")
EXISTING SIGNAL HEADS
2,4-8
R Y G
12"
1,3
R Y G
12"
9-12
12"
NEMA PHASING
FLASHING OPERATION
Ø 1 Ø 2 Ø 4 Ø 4 ALT
Ø 5 Ø 6 Ø 8 Ø 8 ALT
PHASING NOTES:
1. PHASES ASSOCIATED BY A SOLID LINE WILL NOT OPERATE CONCURRENTLY.
2. PHASES ASSOCIATED BY A DASHED LINE WILL OPERATE CONCURRENTLY.
DRILL HOLES
ALLEY
SHOPPING CENTER
TRAILER PARK
133RD STREET
D/W
DP&L 62482 95735
DP&L 62483 95747
DP&L 62486 95772
DP&L 62493 95731
DP&L 62497 95767
LANE BUS
MD 528
18A
15A
EXCALIBER CONDO.
ANGELFISH CONDO.
DETAIL OF CONDUIT AT CONTROLLER
GENERAL NOTES:
1. "D.O." INDICATES DELAY-OUTPUT LOOP DETECTOR.
2. THE LOOP DETECTORS AND CONDUIT ARE TO BE INSTALLED PRIOR TO THE INSTALLATION OF PAVEMENT MARKINGS.
3. UNLESS OTHERWISE INDICATED THE RIGHT-OF-WAY LINE IS AT THE BACK EDGE OF THE SIDEWALK.
LEGEND OF UNDERGROUND AND OVERHEAD UTILITIES
AERIAL CABLE A
ELECTRICAL E
TELEPHONE T
GAS G
SEWER S
WATER W
CABLE TV TV
CONSTRUCTION DETAILS
① REMOVE EXISTING LANE RESTRICTION SIGN AND INSTALL NEW SIGN AT SAME LOCATION ON MAST ARM AS SHOWN.
TRAFFIC CONCEPTS, INC.
325 Gambrills Road
Suite E
Gambrills, MD 21054
(410) 923-7101
FAX: (410) 923-6473
EMAIL: TRAFFIC@TRAFFIC-CONCEPTS.COM
APPROVALS
TEAM LEADER
ASST. DIV. CHIEF
DIVISION CHIEF
OFFICE DIRECTOR
ORIGINAL ON FILE
REVISIONS
Ⓐ INSTALL RESTRICED RIGHT LANE SIGNS
7-14-08 SHA. NO. AT9095185
MR
SHA
STATE OF MARYLAND
DEPARTMENT OF TRANSPORTATION
STATE HIGHWAY ADMINISTRATION
OFFICE OF TRAFFIC & SAFETY
TRAFFIC ENGINEERING DESIGN DIVISION
TRAFFIC SIGNAL PLAN
MD 528 AND 133RD STREET
SCALE 1" = 20'
DATE 1-28-87
CONTRACT NO. WO-653-451-185
DESIGNED BY R. ZACHERL
DRAWN BY S. R. BARANOWSKI
CHECKED BY
F.A.P. NO.
COUNTY WORCHESTER
LOGMILE
T.I.M.S. NO. I673
TOD NO.
DRAWING NO. TS-2315 A
SHEET NO. 39 OF 46
FILE PATH: L:\1500\1566\Task 123- MD 528\Dgn\OC DGN FILES\MD528 @ 133rd.dgn
DATE: Tuesday, July 15, 2008 AT 11:08 AM
TOD No. AT909-32
SHA No. WO442A55/C55