F.H.W.A. REGION NO.	STATE	FED. AID PROJ. NO.	SHEET NO.	TOTAL SHEETS
3	MD.	U-917-1(1)	9	20

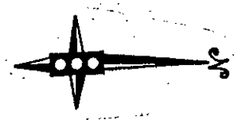

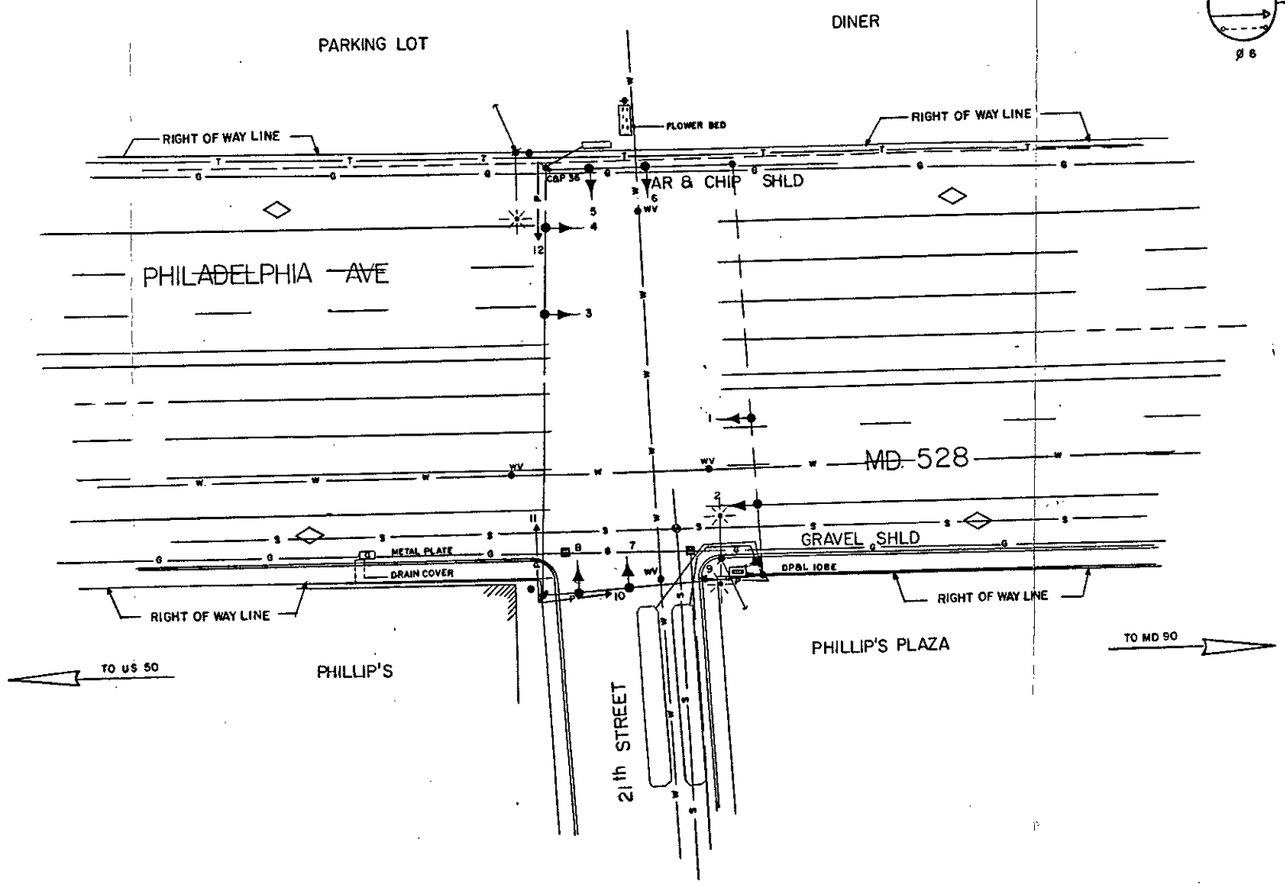

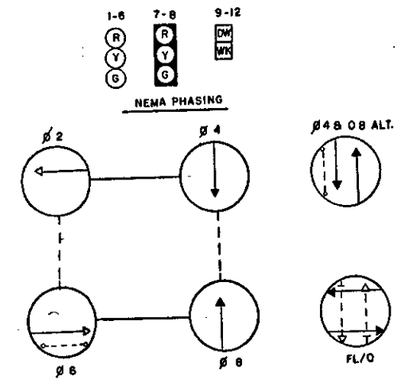

LEGEND
OF UNDERGROUND UTILITIES

—G—G—	GAS MAIN
—W—W—	WATER MAIN
—S—S—	SEWER MAIN
—E—E—	ELECTRIC CABLES
—T—T—	TELEPHONE CABLES
—A—A—	AERIAL CABLES

APPROVAL: CHIEF SIGNAL DESIGN SECTION

APPROVAL: DISTRICT TRAFFIC ENGINEER

APPROVAL: CHIEF BUREAU OF TRAFFIC ENGINEERING

APPROVAL: DEPUTY-CHIEF ENGINEER OFFICE OF TRAFFIC

REVISIONS	
B	5/84 "Refer to Special Provisions." AW-678-501-085
DA	
A	4/84 "REDRAWN & ASBUILT" (note: original plan is on file) WO-479-001-185 FAP-U-917-1(1)
LS	

STATE OF MARYLAND
DEPARTMENT OF TRANSPORTATION
STATE HIGHWAY ADMINISTRATION

TRAFFIC DIVISION – BUREAU OF TRAFFIC ENGINEERING

PHILA. AVE. (MD 528) & 21st. ST.

SCALE 1" = 20' DATE 6/74 CONTRACT NO. WO-479-001-185 FAP-U-917-1(1)

DRAWN BY: WM, LS COUNTY: WORCESTER

DESIGNED BY: WM SIGNAL NO.: 23109

CHECKED BY: AB

DRAWING NO. TS-363 B

23052807.17