F H WA REGION NO	STATE	FED. AID PROJ. NO	SHEET NO.	TOTAL SHEETS
3	MD.			

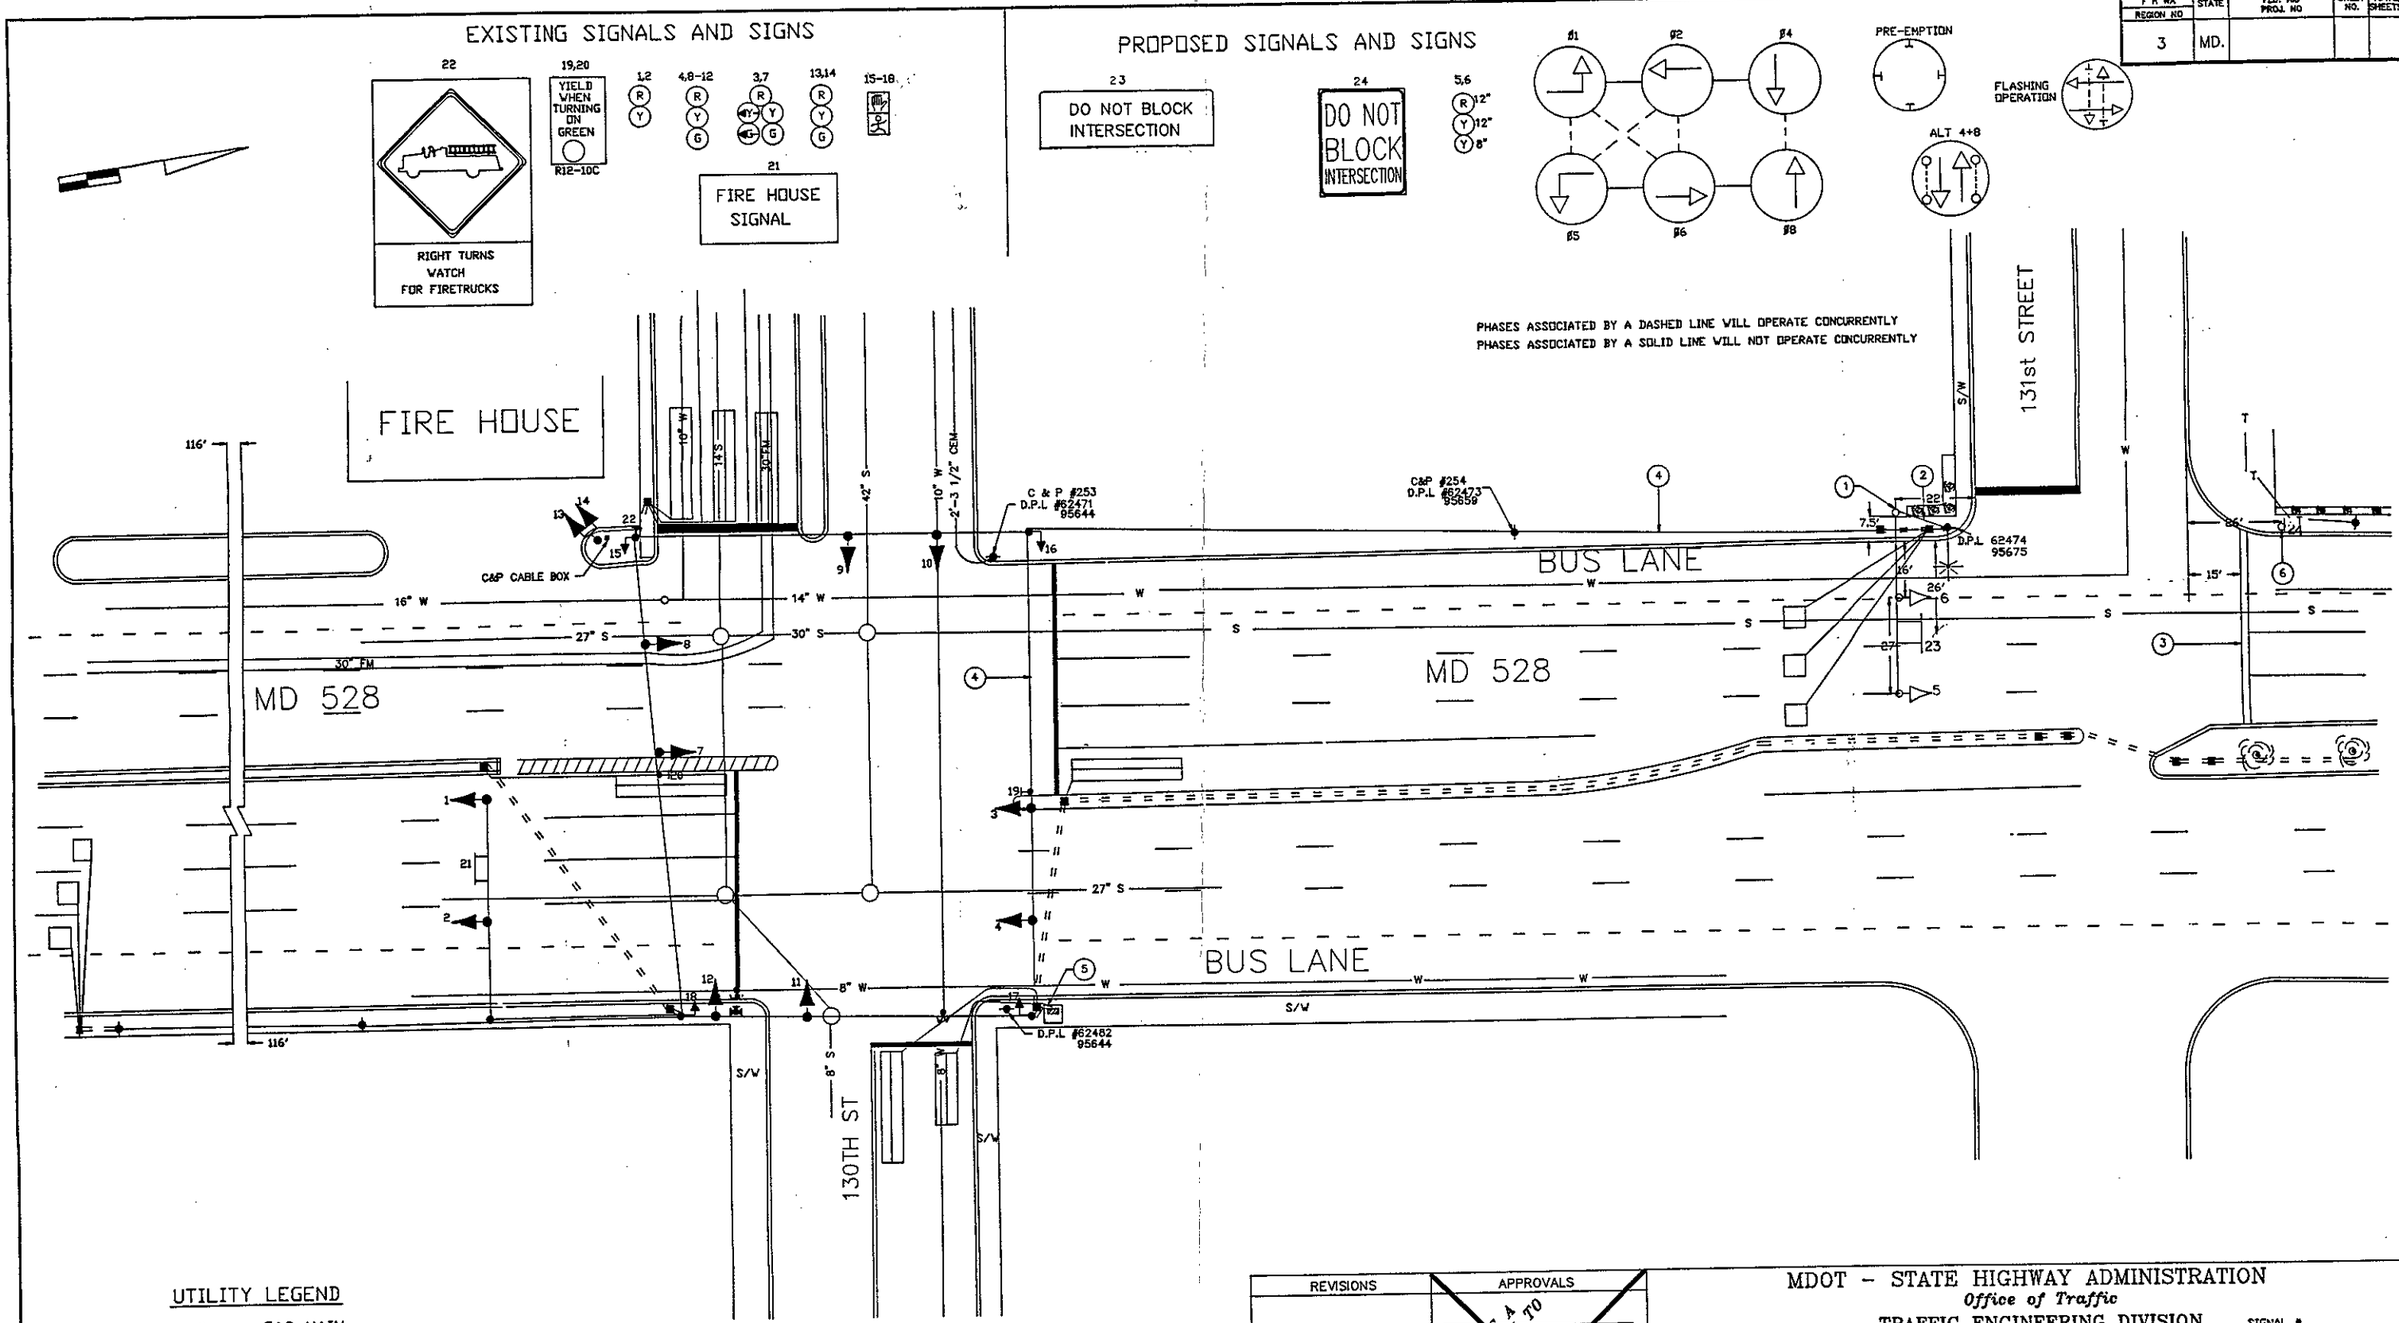

UTILITY LEGEND

—G—G—	GAS MAIN
—W—W—	WATER MAIN
—S—S—	SEWER MAIN
—E—E—	ELECTRIC CABLES
—A—A—	AERIAL CABLES
—T—T—	TELEPHONE CABLES

REVISIONS	APPROVALS
	NOTE: THIS IS A REVISION TO T.S.-1433E S.H.A. NO. WO-656-501-176
(F) ASBUILT INSTALL I.C.B AT 131st ST.	DEPUTY CHIEF ENGINEER, OFFICE OF TRAFFIC

MDOT - STATE HIGHWAY ADMINISTRATION
Office of Traffic
TRAFFIC ENGINEERING DIVISION SIGNAL #

ACAD DRAWN BY: DERRICK DICKERSON
DES. BY:
CHK. BY:

MD 528 AND 130TH/131st STREET

COUNTY: WORCESTER

DATE: 2/88
SCALE: 1" = 20"
F.A.P. NO.
S.H.A. NO. WO-656-501-176
TS/STD. NO. 1433 (F)
SHEET NO. ___ OF ___

23052801.09